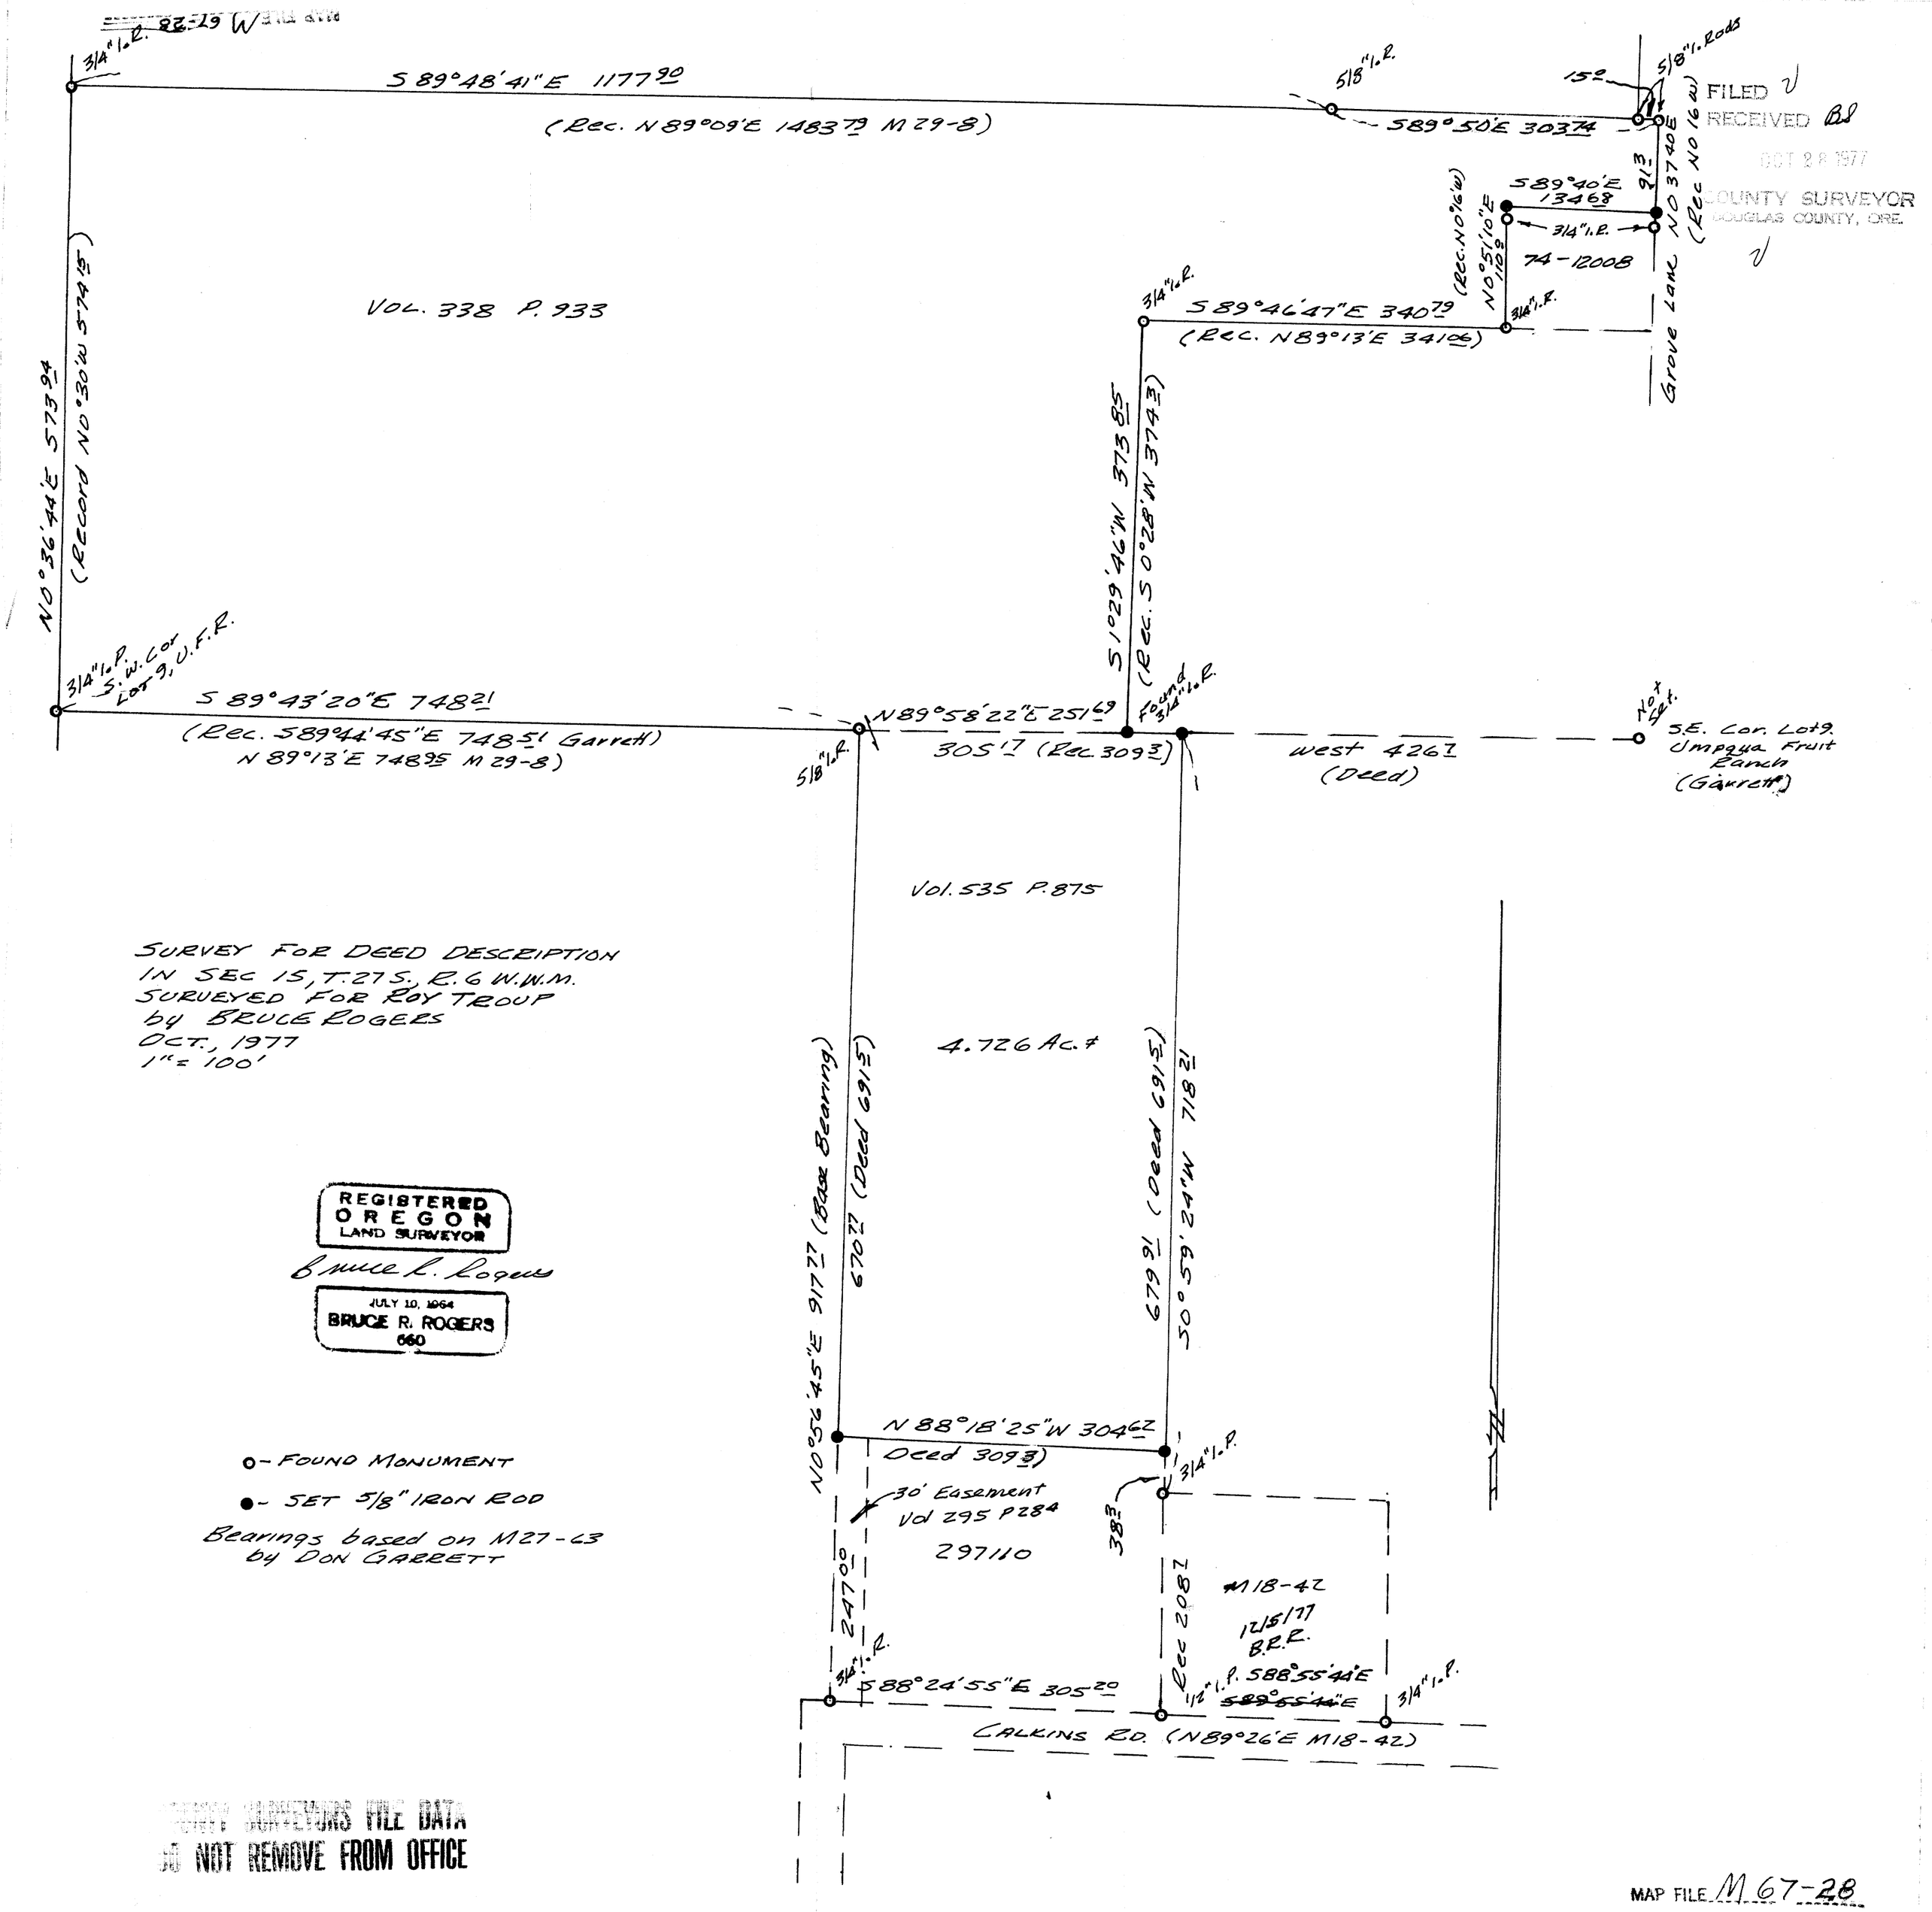

SURVEY FOR DEED DESCRIPTION
IN SEC 15, T. 27 S., R. 6 W.W.M.
SURVEYED FOR ROY TROUP
by BRUCE ROGERS
OCT., 1977
1" = 100'

REGISTERED
OREGON
LAND SURVEYOR

Bruce R. Rogers

JULY 10, 1964
BRUCE R. ROGERS
660

o - FOUND MONUMENT

● - SET 5/8" IRON ROD

Bearings based on M 27-63
by DON GARRETT

FILED
RECEIVED
OCT 28 1977
COUNTY SURVEYOR
DOUGLAS COUNTY, ORE.

COUNTY SURVEYORS FILE DATA
DO NOT REMOVE FROM OFFICE

MAP FILE M 67-28