COUNTY SURVEYORS FILE DATA
DO NOT REMOVE FROM OFFICE

FILED
RECEIVED
FEB 28
COUNTY SURVEYOR
DOUGLAS COUNTY, ORE.

SURVEY IN LOTS 6, 7, 8, 9, & 10, BLOCK 3
AMENDED PLAT TOWNSITE OF SUTHERLIN

SECTION 17, T25S, R5W, W.M.

SURVEY FOR: EARNEST ANDERSON

SURVEY BY: B.H.W. ENG. & SURVEYING

FEB. 1978

SCALE: 1" = 50'

REGISTERED PROFESSIONAL LAND SURVEYOR
Romanso E. Ware
OREGON
NOV. 16, 1973
ROMANSO E. WARE
1005

● —— FD. 5/8" I. ROD (UNLESS OTHERWISE NOTED)
○ —— SET 5/8" I. ROD

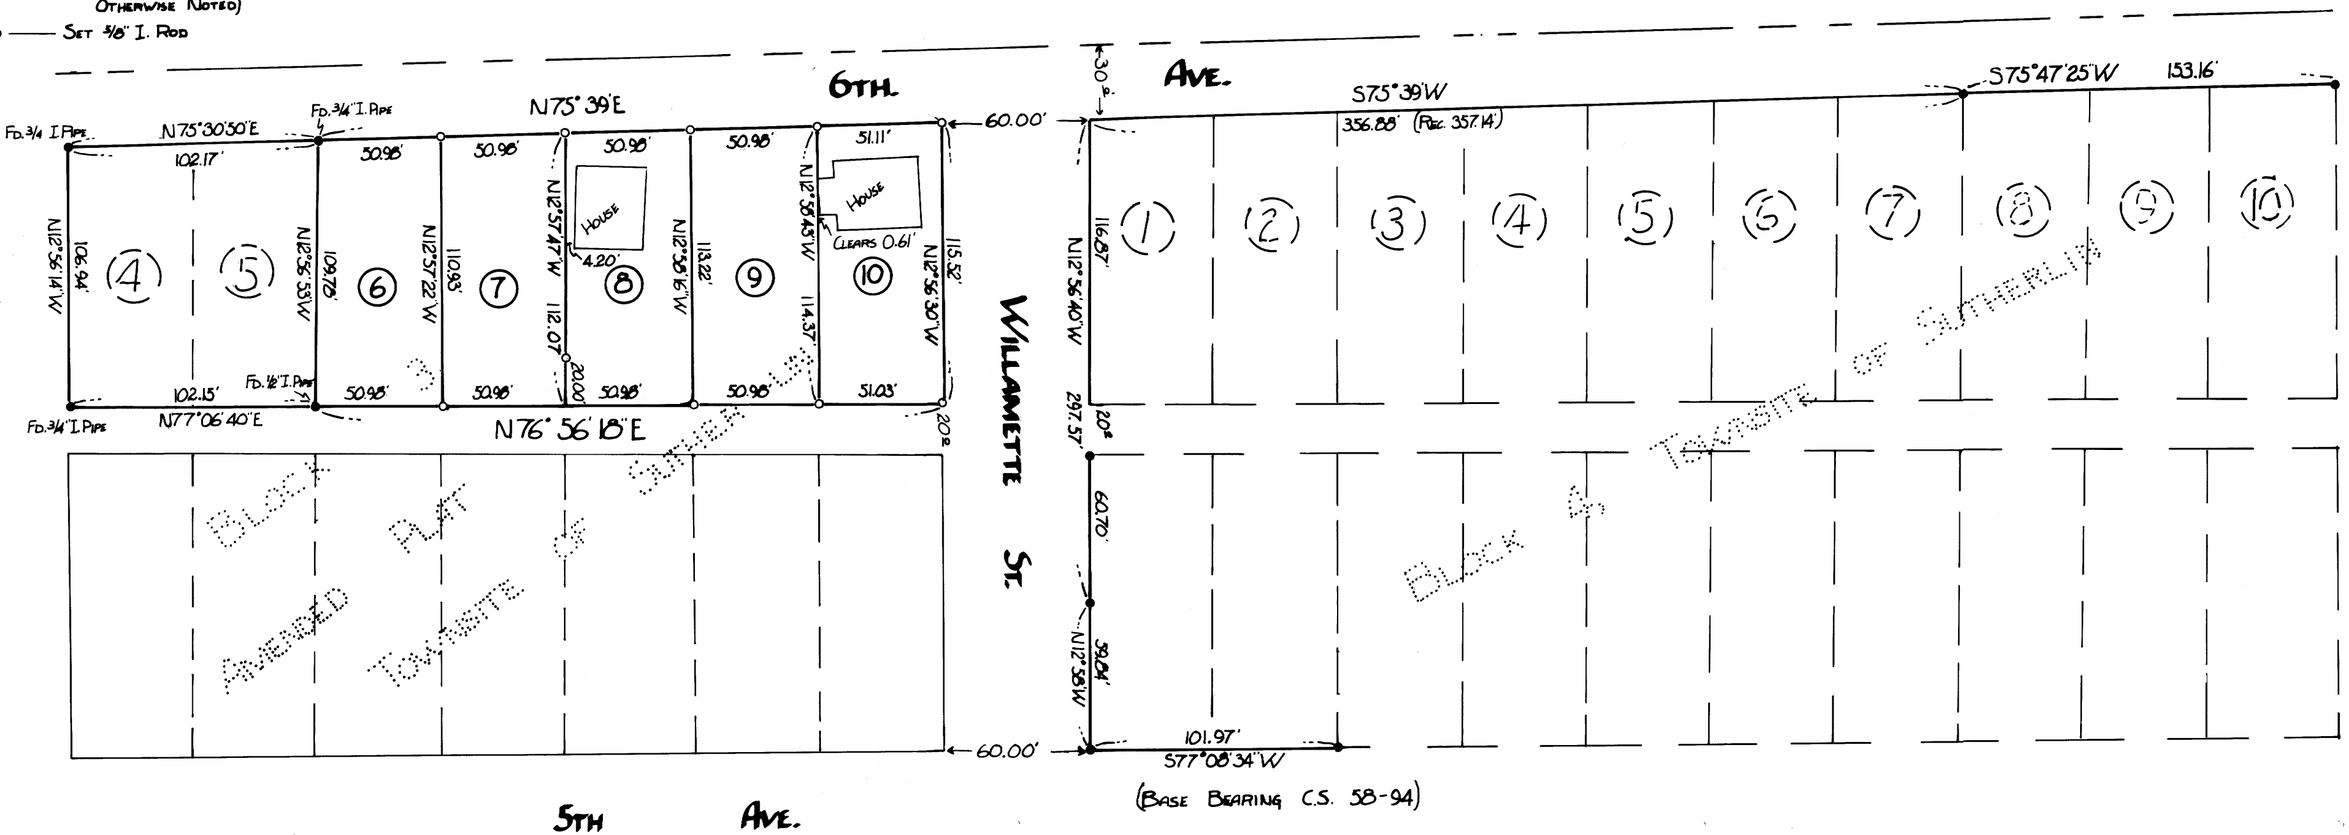

(BASE BEARING C.S. 58-94)