COUNTY SURVEYORS FILE DATA
DO NOT REMOVE FROM OFFICE

FILED
RECEIVED L C
APR 1 2 1978
COUNTY SURVEYOR
DOUGLAS COUNTY, ORE.

MAP FILE M69 - 41

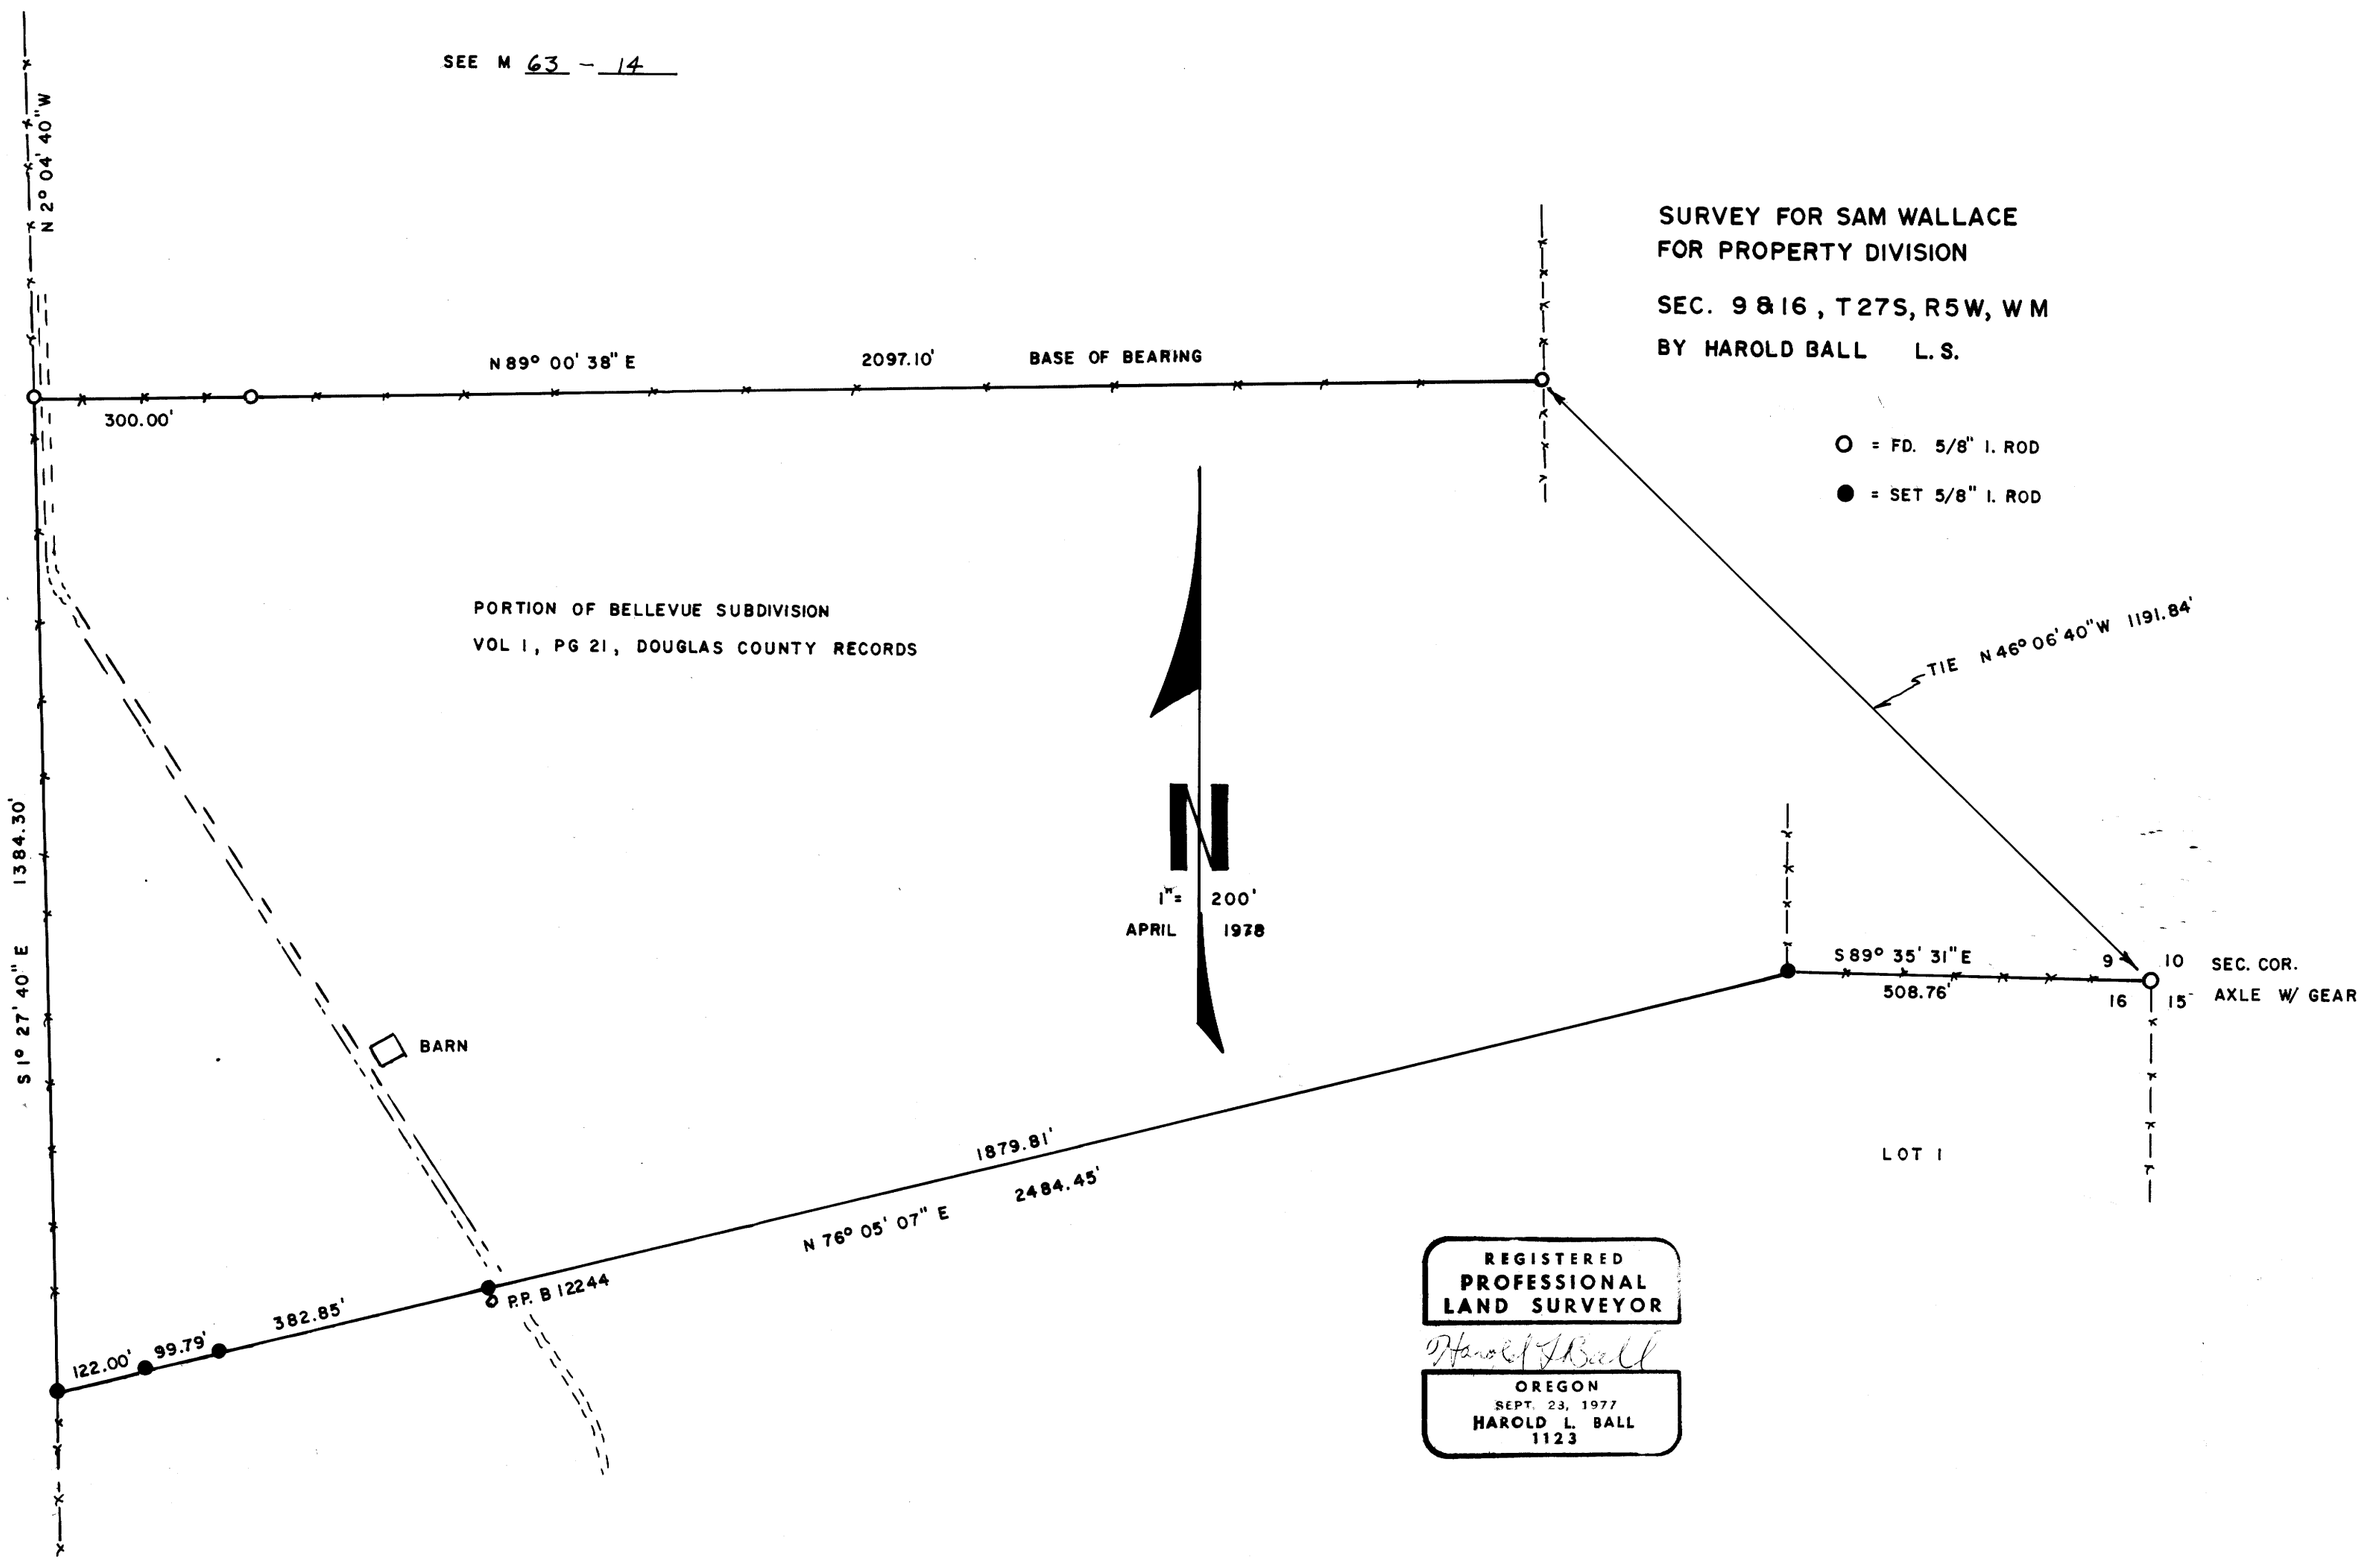

MAP FILE M69-41