COUNTY SURVEYORS FILE DATA
DO NOT REMOVE FROM OFFICE

FILED
RECEIVED
JUN 5 1978
COUNTY SURVEYOR
DOUGLAS COUNTY, ORE.

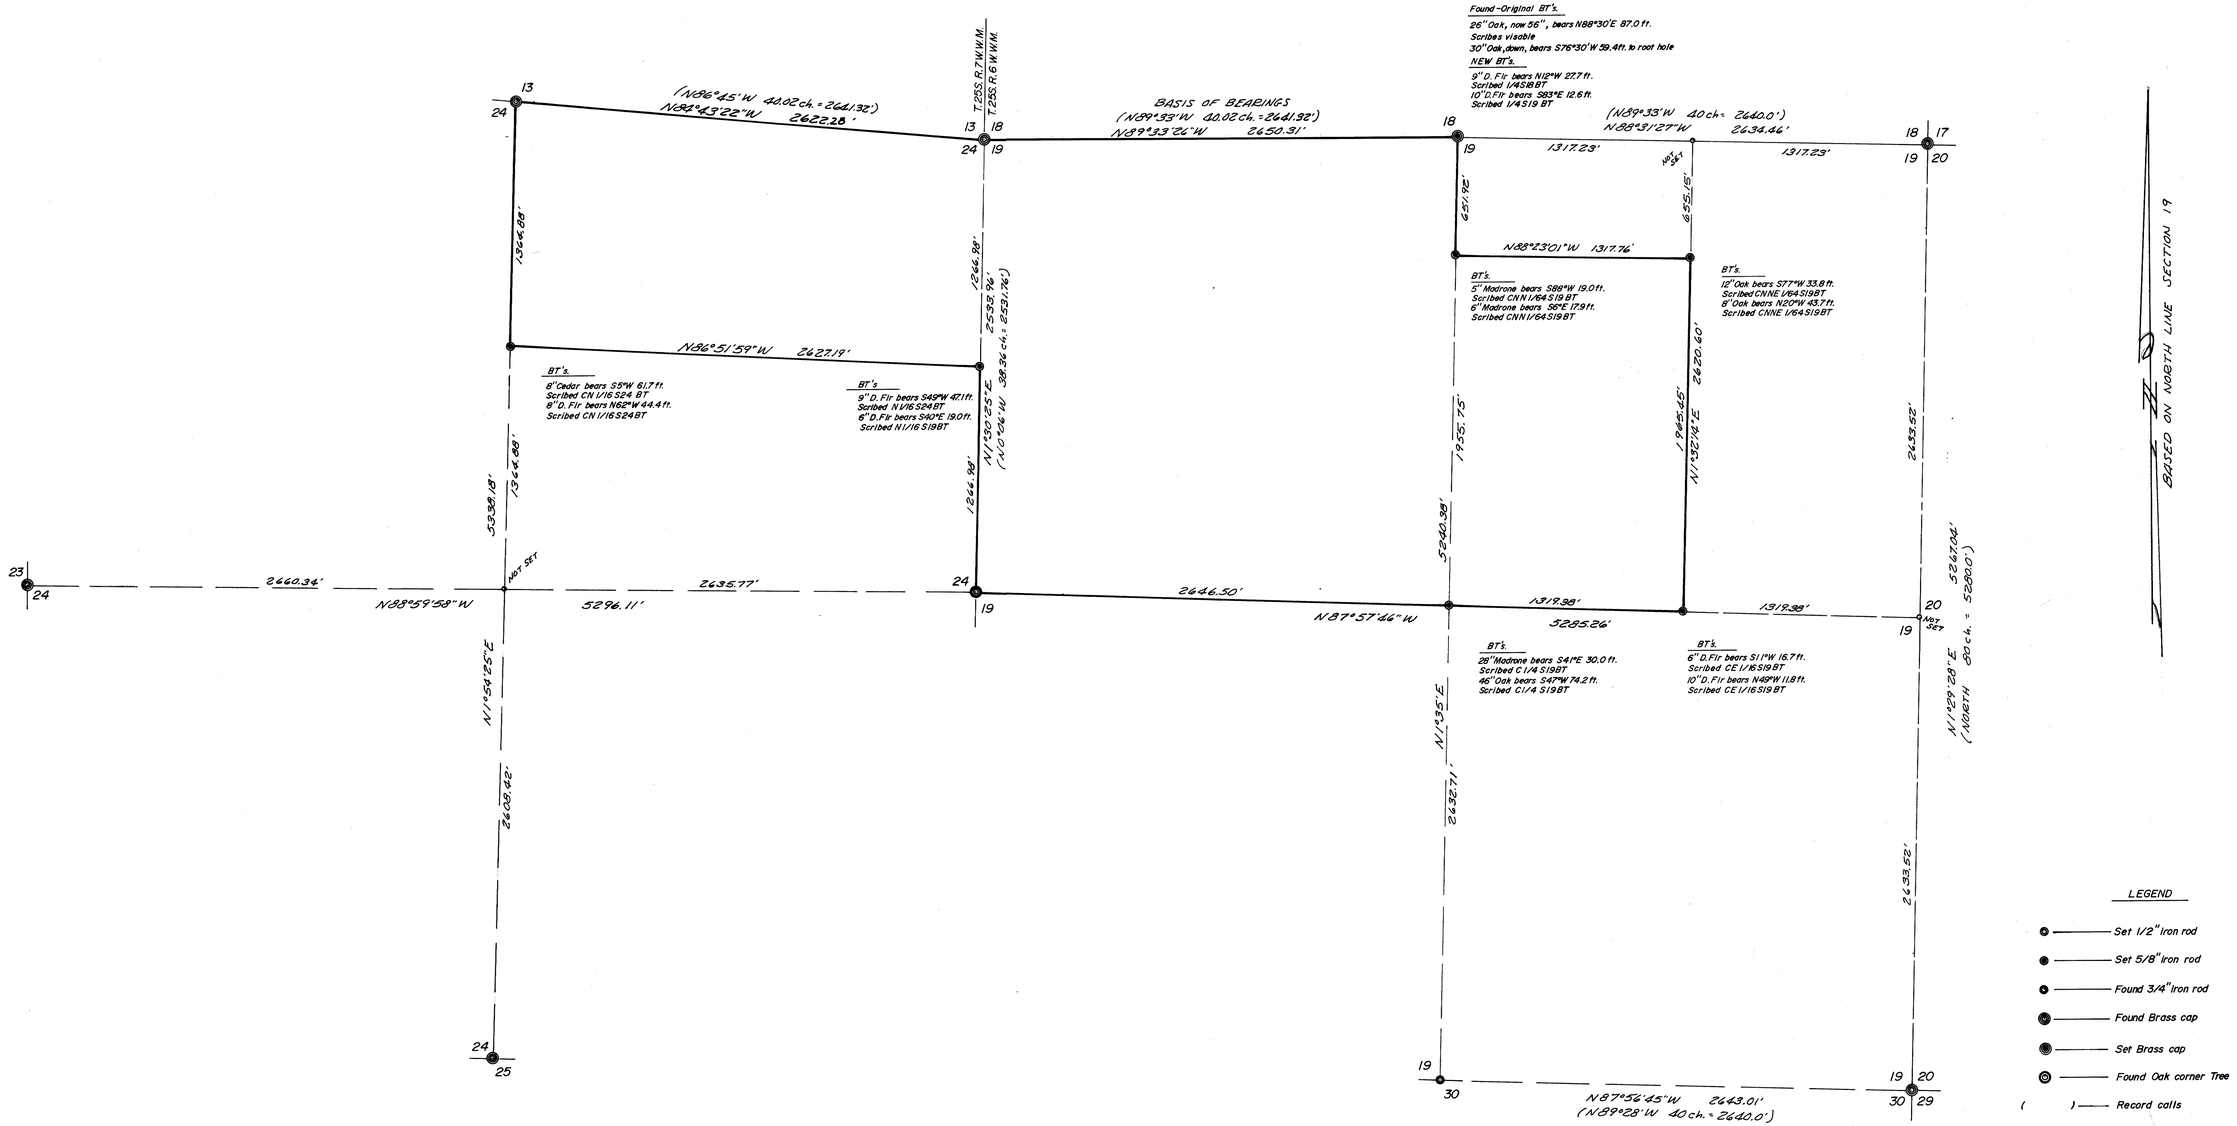

COUNTY SURVEYORS FILE DATA
DO NOT REMOVE FROM OFFICE

REGISTERED PROFESSIONAL LAND SURVEYOR
OREGON
JULY 14, 1967
GLENN S. BAUGHMAN
536

SURVEY FOR PROPERTY CORNERS IN SECTION 19, T.25S.R.6W.W.M. & SECTION 24, T.25S.R.7W.W.M.		
FOR: JOHN TILLEY	SCALE 1"=400'	DRAWN BY Eab / REVISED
BAUGHMAN TECHNICAL SERVICES INC.		
DATE MAY 1978	APPROVED BY	DRAWING NUMBER FM 1-37

MAP FILE M 70 - 18

MADE IN U.S.A.
K+E CRYSTALENE © 10 9458 ARCHITECTS' STANDARD FORM