M70 - 28

COUNTY SURVEYORS FILE DATA
DO NOT REMOVE FROM OFFICE

SURVEY FOR U.S. FOREST SERVICE
IN SECTION 21, T.31S. R.1W., W.M., DOUGLAS COUNTY, OREGON
BY: BAUGHMAN TECHNICAL SERVICES, INC.

JULY 1978

SCALE: 1" = 400'

200 100 50 0 100 300 500 700 900 feet

LEGEND

- Found Brass cap
- Set Brass cap
- ( ) Record calls
- True lines posted with steel fence posts and government property signs.

NOTE: Brass washers, set in lower blaze of new B.T.'s.

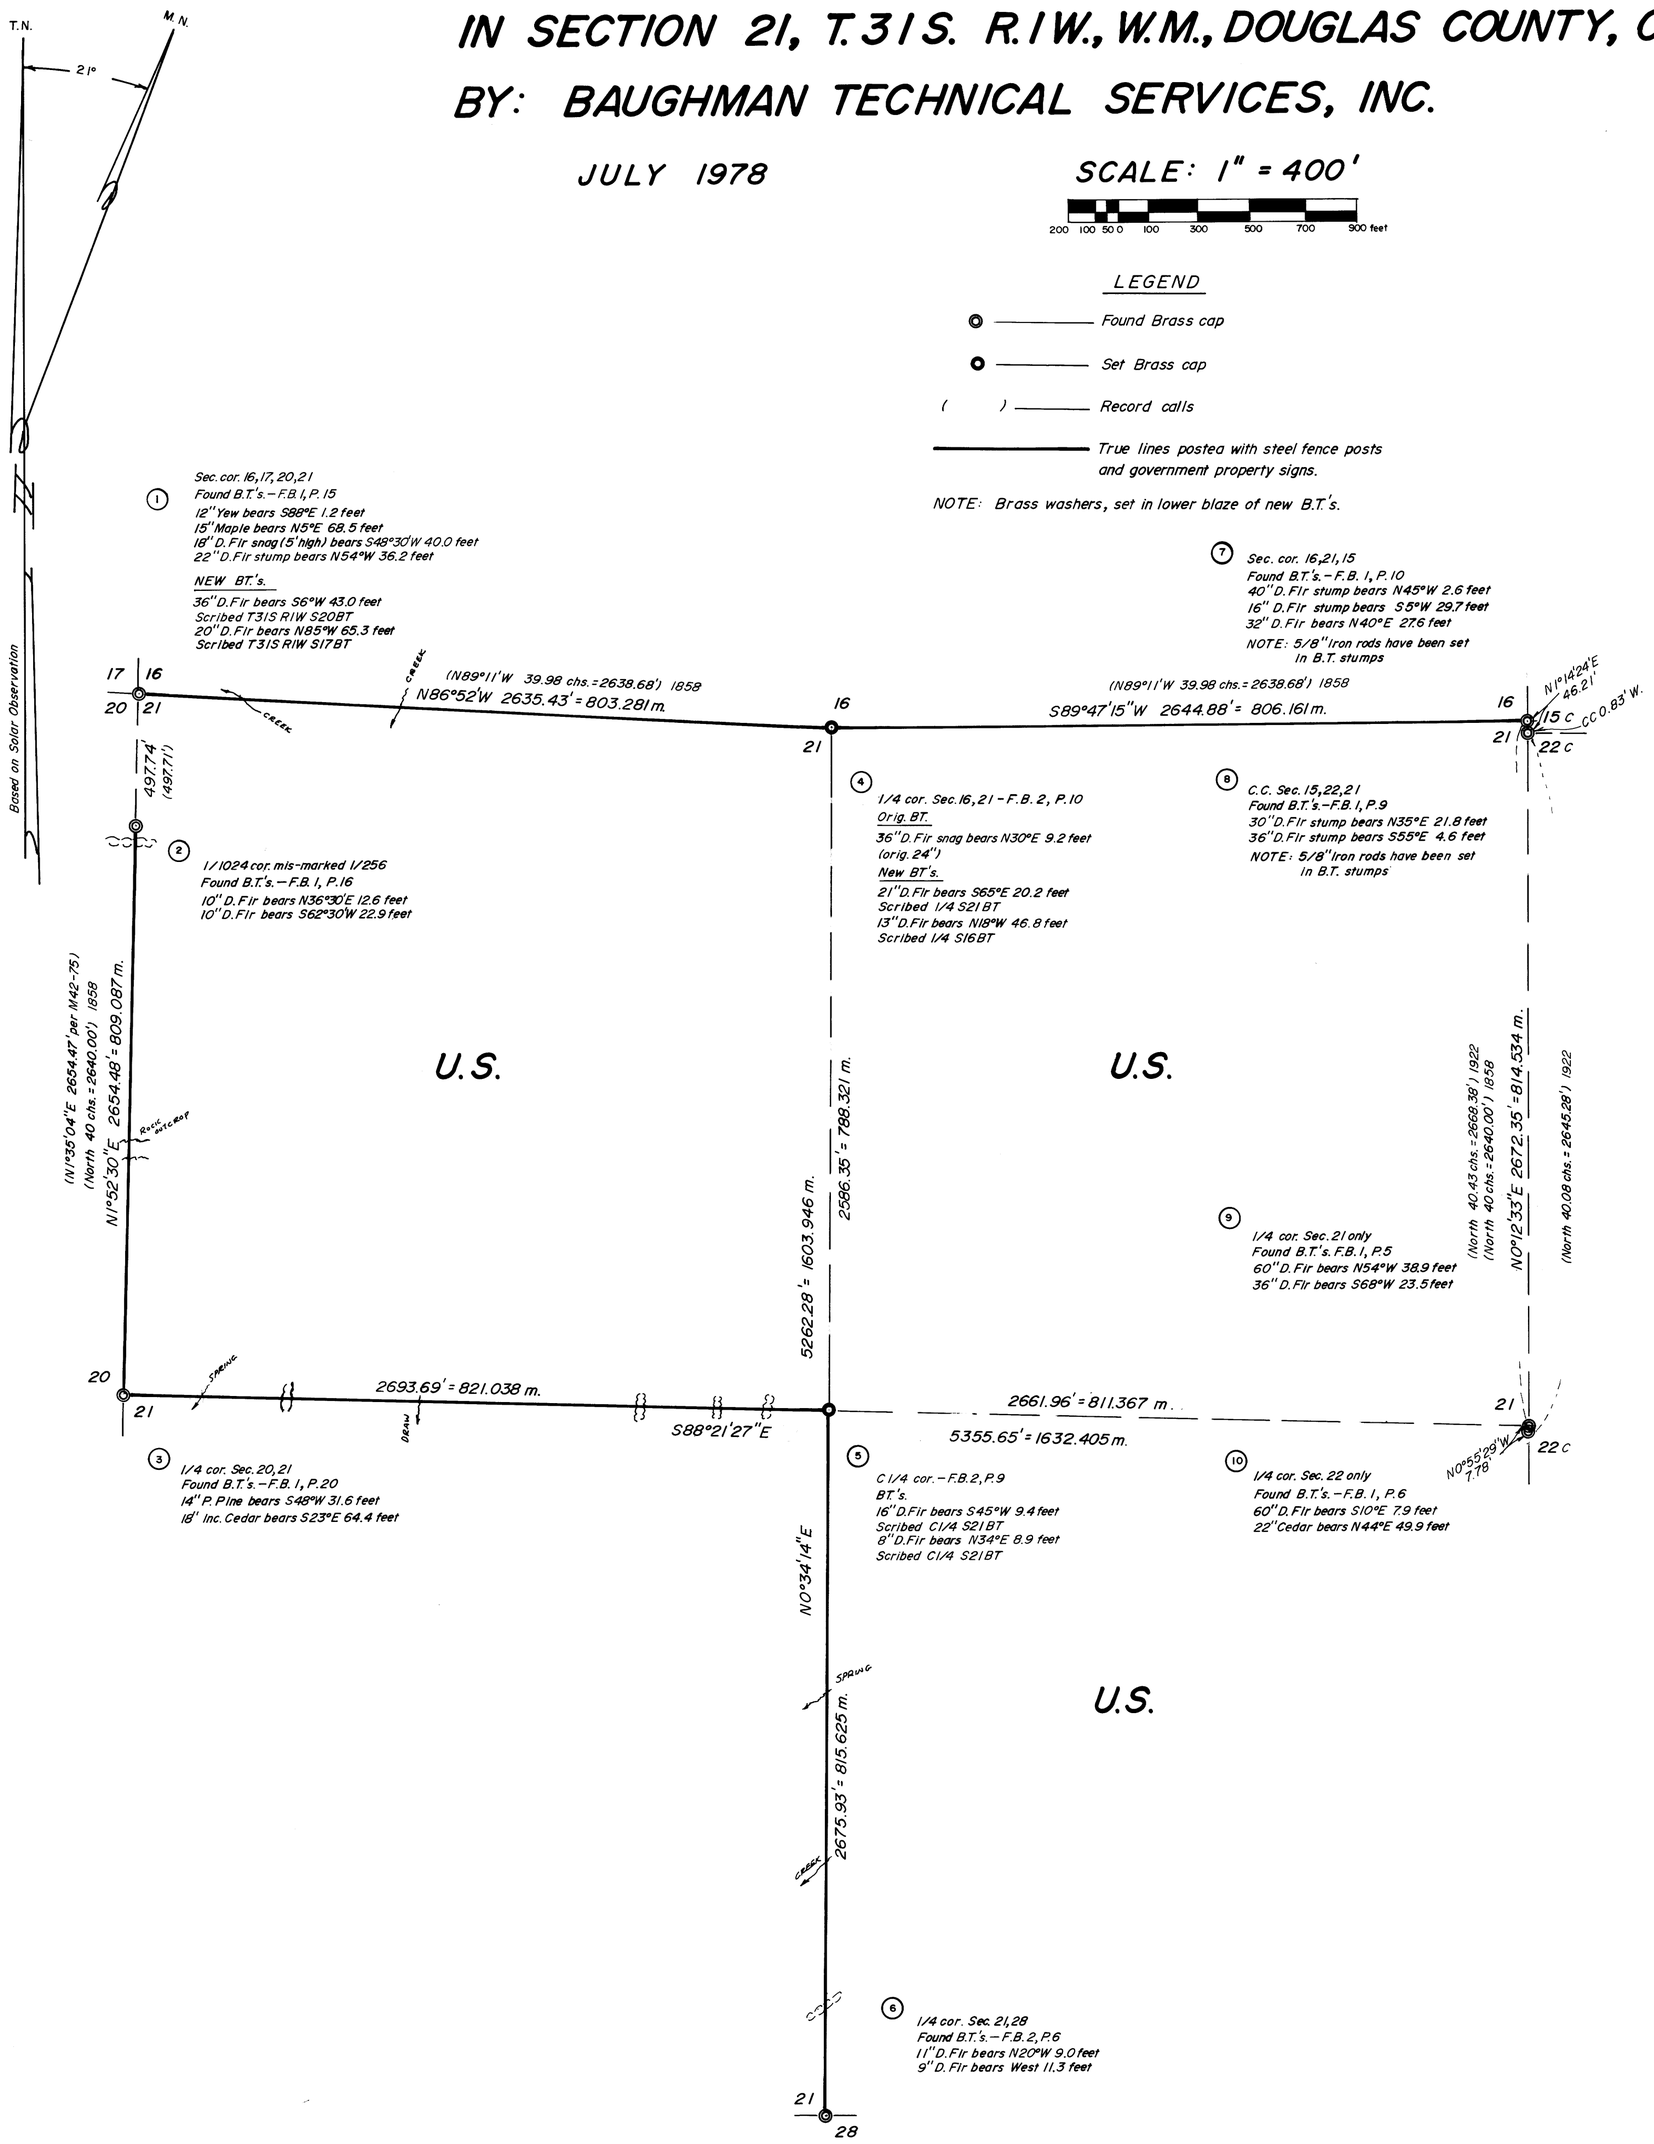

(1) Sec. cor. 16,17,20,21
Found B.T.'s.–F.B. 1, P. 15
12" Yew bears S88°E 1.2 feet
15" Maple bears N5°E 68.5 feet
18" D. Fir snag (5' high) bears S48°30'W 40.0 feet
22" D. Fir stump bears N54°W 36.2 feet
NEW BT.'s.
36" D. Fir bears S6°W 43.0 feet
Scribed T31S R1W S20BT
20" D. Fir bears N85°W 65.3 feet
Scribed T31S R1W S17BT

(2) 1/1024 cor. mis-marked 1/256
Found B.T.'s.–F.B. 1, P. 16
10" D. Fir bears N36°30'E 12.6 feet
10" D. Fir bears S62°30'W 22.9 feet

(3) 1/4 cor. Sec. 20,21
Found B.T.'s.–F.B. 1, P. 20
14" P. Pine bears S48°W 31.6 feet
18" Inc. Cedar bears S23°E 64.4 feet

(4) 1/4 cor. Sec. 16,21 – F.B. 2, P. 10
Orig. BT.
36" D. Fir snag bears N30°E 9.2 feet (orig. 24")
New BT's.
21" D. Fir bears S65°E 20.2 feet
Scribed 1/4 S21BT
13" D. Fir bears N18°W 46.8 feet
Scribed 1/4 S16BT

(5) C 1/4 cor.–F.B. 2, P. 9
BT's.
16" D. Fir bears S45°W 9.4 feet
Scribed C1/4 S21BT
8" D. Fir bears N34°E 8.9 feet
Scribed C1/4 S21BT

(6) 1/4 cor. Sec. 21,28
Found B.T.'s.–F.B. 2, P. 6
11" D. Fir bears N20°W 9.0 feet
9" D. Fir bears West 11.3 feet

(7) Sec. cor. 16,21,15
Found B.T.'s.–F.B. 1, P. 10
40" D. Fir stump bears N45°W 2.6 feet
16" D. Fir stump bears S5°W 29.7 feet
32" D. Fir bears N40°E 27.6 feet
NOTE: 5/8" Iron rods have been set in B.T. stumps

(8) C.C. Sec. 15,22,21
Found B.T.'s.–F.B. 1, P. 9
30" D. Fir stump bears N35°E 21.8 feet
36" D. Fir stump bears S55°E 4.6 feet
NOTE: 5/8" Iron rods have been set in B.T. stumps

(9) 1/4 cor. Sec. 21 only
Found B.T.'s. F.B. 1, P. 5
60" D. Fir bears N54°W 38.9 feet
36" D. Fir bears S68°W 23.5 feet

(10) 1/4 cor. Sec. 22 only
Found B.T.'s.–F.B. 1, P. 6
60" D. Fir bears S10°E 7.9 feet
22" Cedar bears N44°E 49.9 feet

(1) COUNTY SURVEYORS OFFICE T31S 17|16 20|21 R1W 1968 — Stamped
Found Brass cap, set by Douglas County, Surveyors Office

(2) T31S R1W SNN 1/256 S20|S21 ORE LIC 222 1972 — Stamped
Found Brass cap, set by J. A. Hoffbuhr Ore. License 222

(3) COUNTY SURVEYORS OFFICE T31S R1W 1/4 20|21 1968 — Stamped
Found Brass cap, set by Douglas County Surveyors Office

(4) T31S R1W 1/4 S16 S21 OLS 536 1978 — Stamped
Set 2"x30" I.P., with Brass cap

(5) T31S R1W WM C 1/4 C C C 1978 OLS 536 — Stamped
Set 2"x 30" I.P., with Brass cap

(6) COUNTY SURVEYORS OFFICE T31S R1W 1/4 S21 S28 1968 — Stamped
Found Brass cap, set by Douglas County Surveyors Office

(7) U.S. GENERAL LAND OFFICE SURVEY T31S S16 S21 S15 R1W 1923 — Stamped
Found Brass cap, set by U.S.G.L.O.

(8) U.S. GENERAL LAND OFFICE SURVEY T31S S15C S21 S22C R1W 1923 — Stamped
Found Brass cap, set by U.S.G.L.O.

(9) U.S. GENERAL LAND OFFICE SURVEY 1/4 S21 1922 — Stamped
Found Brass cap, set by U.S.G.L.O.

(10) U.S. GENERAL LAND OFFICE SURVEY 1/4 S22 1922 — Stamped
Found Brass cap, set by U.S.G.L.O.

REGISTERED PROFESSIONAL LAND SURVEYOR
OREGON
JULY 14, 1978
GLENN S. BAUGHMAN
536

"I, GLENN S. BAUGHMAN, a registered professional land surveyor in the State of Oregon, hereby certify that this plat and the notes hereon, or attached, are a correct representation of a survey I performed during May — July 1978 for the U.S. Forest Service, in accordance with the statutes of the State of Oregon and with the Articles of my contract."

GLENN S. BAUGHMAN
Registered Professional Land Surveyor
Oregon License No. 536

TILLER LAND SURVEY No. 26 CONTRACT No. 02296

FM 2-39

COUNTY SURVEYORS FILE DATA
DO NOT REMOVE FROM OFFICE

M70 - 28