COUNTY SURVEYORS FILE DATA
DO NOT REMOVE FROM OFFICE

FILED
RECEIVED KB
APR 27 1979
COUNTY SURVEYOR
DOUGLAS COUNTY, ORE.
KW

MAP FILE 11-28-57

SURVEY FOR U.S. FOREST SERVICE

IN SECTION 9, T31S, R2W, DOUGLAS COUNTY, OREGON

BY: UMPQUA SURVEYING COMPANY, MYRTLE CREEK, OREGON

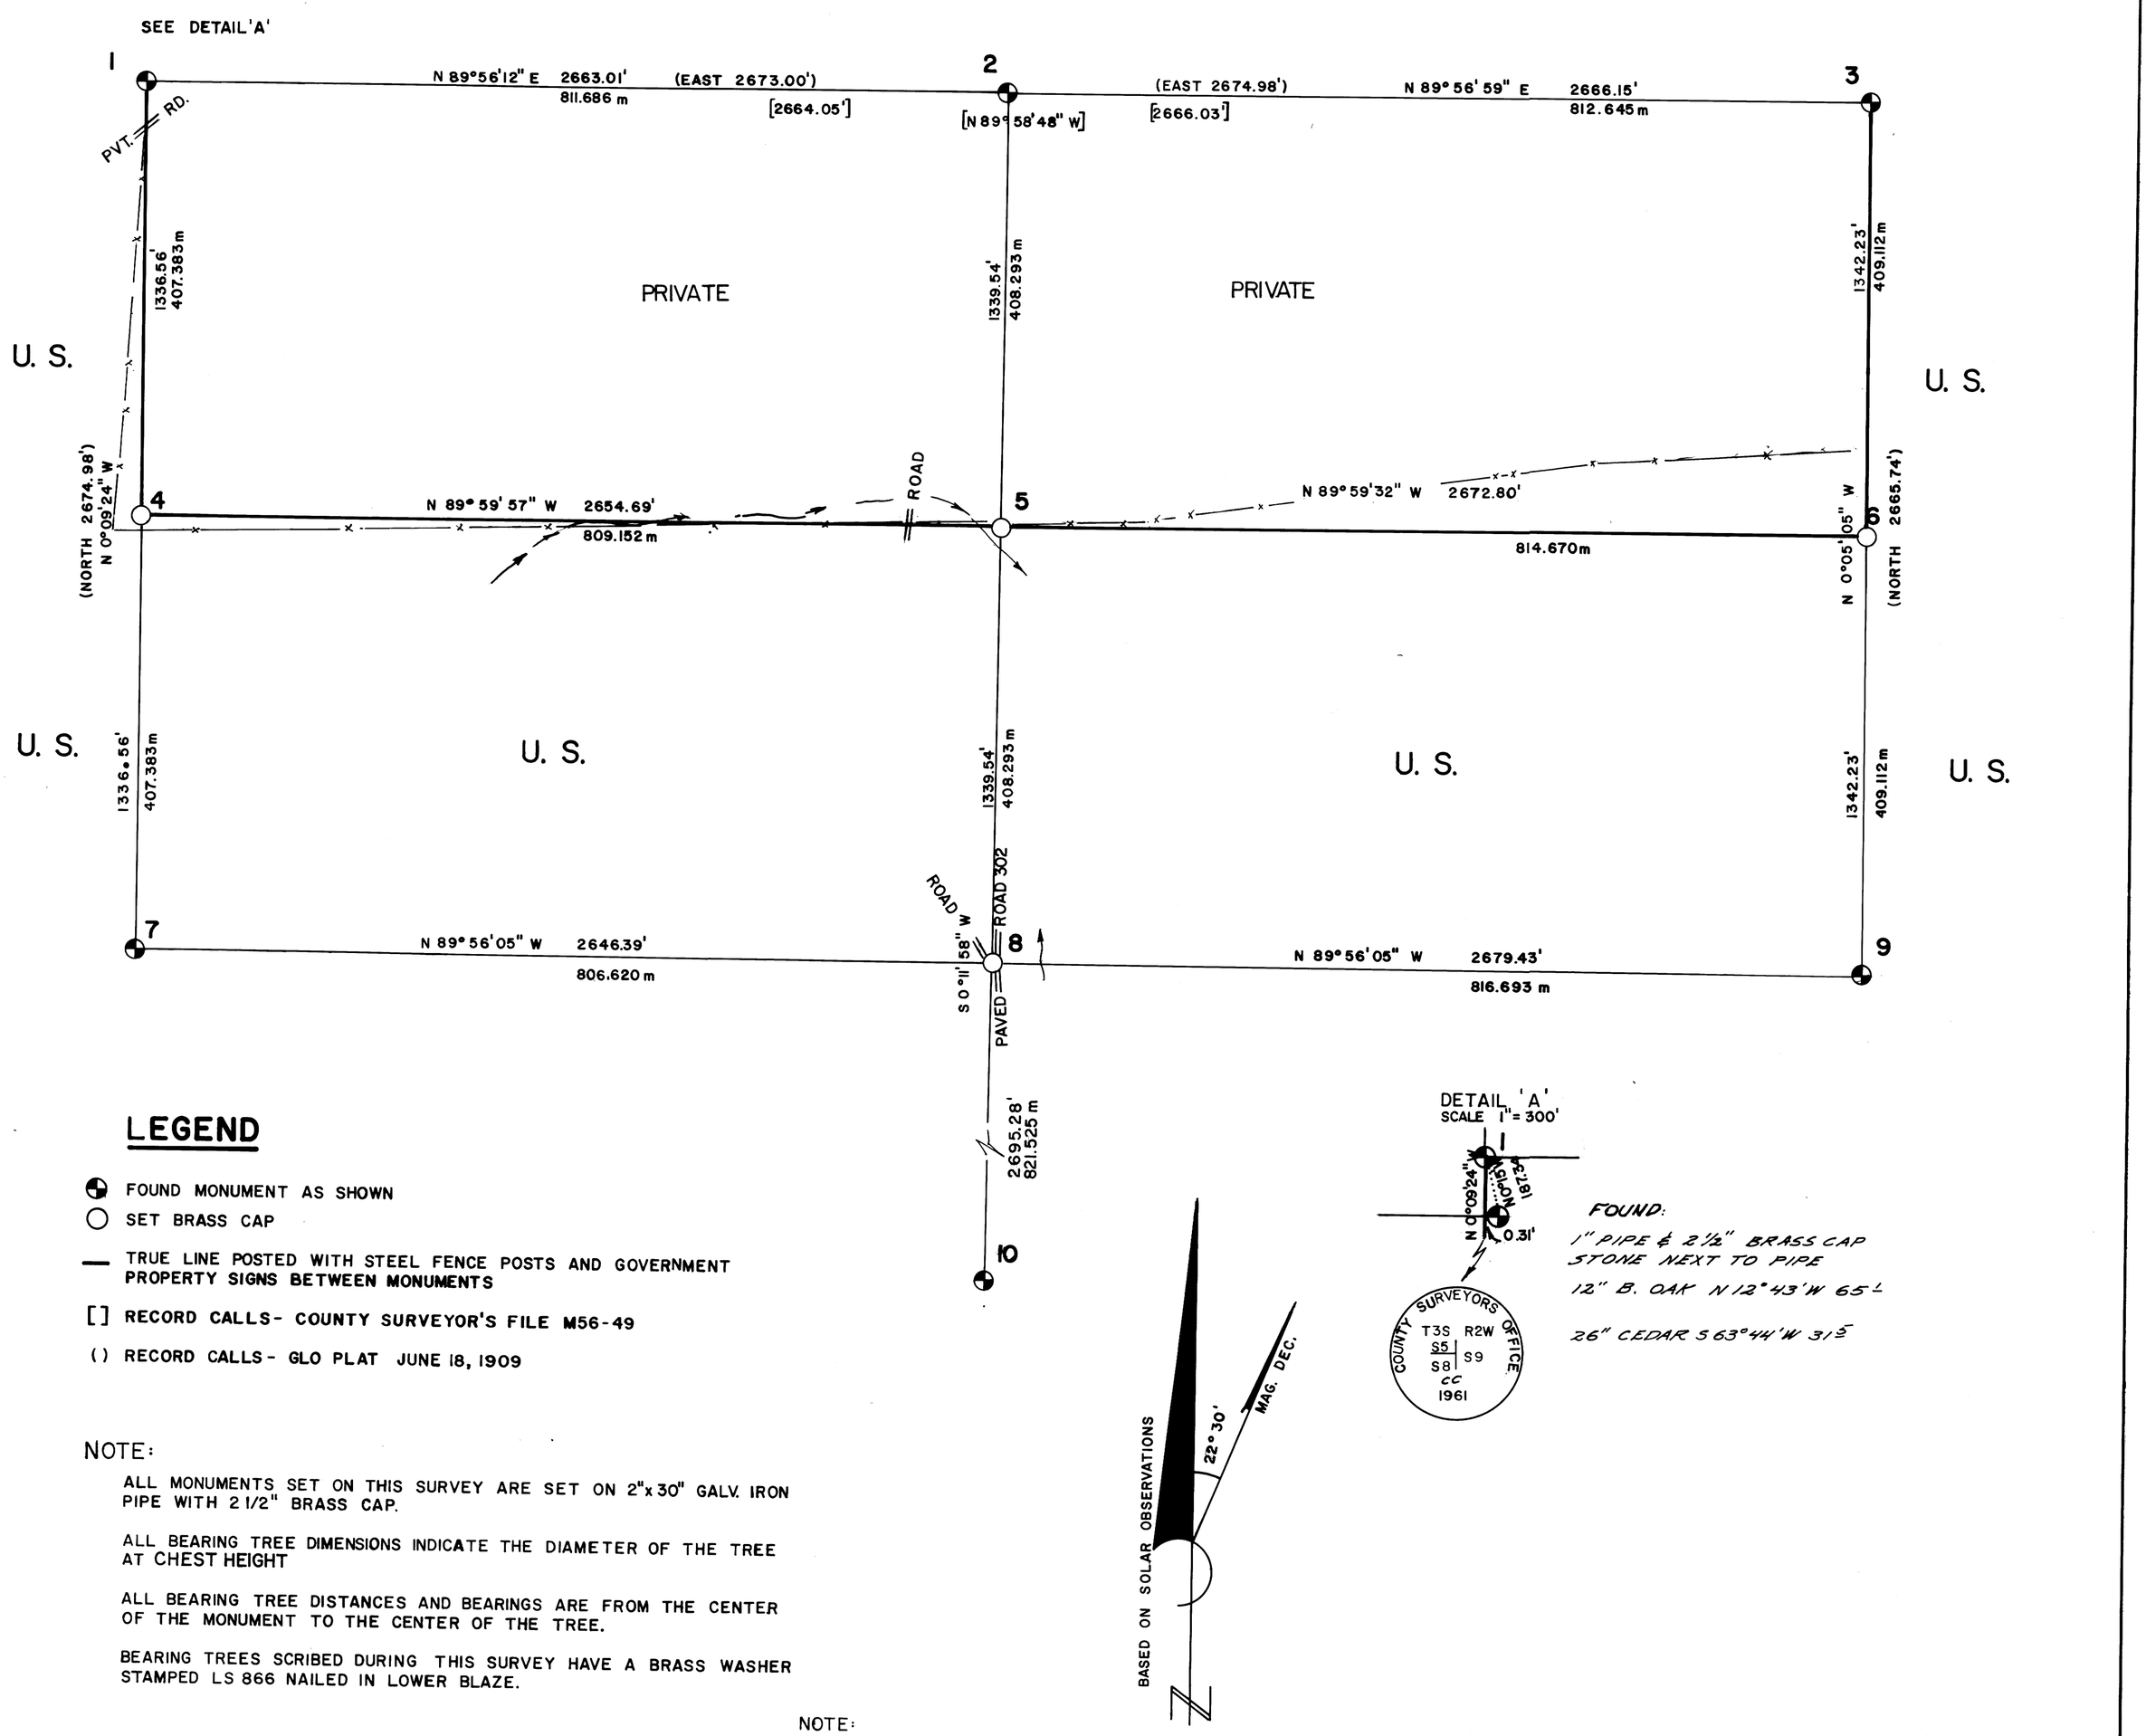

LEGEND

- FOUND MONUMENT AS SHOWN
- SET BRASS CAP
- TRUE LINE POSTED WITH STEEL FENCE POSTS AND GOVERNMENT PROPERTY SIGNS BETWEEN MONUMENTS
- [ ] RECORD CALLS- COUNTY SURVEYOR'S FILE M56-49
- ( ) RECORD CALLS- GLO PLAT JUNE 18, 1909

NOTE:

ALL MONUMENTS SET ON THIS SURVEY ARE SET ON 2"x 30" GALV. IRON PIPE WITH 2 1/2" BRASS CAP.

ALL BEARING TREE DIMENSIONS INDICATE THE DIAMETER OF THE TREE AT CHEST HEIGHT

ALL BEARING TREE DISTANCES AND BEARINGS ARE FROM THE CENTER OF THE MONUMENT TO THE CENTER OF THE TREE.

BEARING TREES SCRIBED DURING THIS SURVEY HAVE A BRASS WASHER STAMPED LS 866 NAILED IN LOWER BLAZE.

NOTE:

DISTANCES SHOWN ARE NOT REDUCED TO SEA LEVEL.

1

COUNTY SURVEYORS OFFICE T31S R2W S5 S4 S9 1961

FOUND: 2½" BRASS CAP & 1" PIPE
36" OAK S.8½° W. 56L GOOD SCAR
34" B. OAK N.60¾° W. 57L GOOD SCAR
10" CEDAR S.23½° E. 16R OPEN
42" STUMP S.72½° E. 142L BURNED
10" D. FIR N.26¼° E. 10R GOOD SCAR
NEW BT.
SCRIBED: "T.31S. R2W. S9 BT"
9" D. FIR S.8° E. 77L

2

1 / 4

FOUND: 5/8" IRON ROD & 1½" ALUMINUM CAP
16" CEDAR N41°48' E 23R
" ¼ S BT" VISIBLE
14" CEDAR S 38°23' W 8L
" ¼ S BT" VISIBLE

3

COUNTY SURVEYORS OFFICE T31S R2W S4 S3 S9 S10 1966

FOUND: 1" PIPE & 2½" BRASS CAP
32" PINE N.31°32' E. 279L SCAR.
10" UPROOT N.42°41' E. 238L SCAR.
35" PINE SNAG S. 44°13' E 330L
16" DBL. PINE S 41°03' W 220L SCAR.
24" STUMP S 76°15' W 147L
54" STUMP N 40°36' W 100L SCAR.
9" PINE N 48°58' W 129R "T31S R2W, S4 BT"
5/8" ROD S 40°53' E 2.16L

4

T31S R2W N1/16 S9 PLS 866 1979

SET 2" PIPE & 2½" BRASS CAP
5/8" IRON ROD & 1½" ALUM. CAP
WITH 6' STEEL GUARD POST
N.46°08' E. 15R FT.
S.42° 35' E. 14R FT
ALUMINUM CAPS MARKED:
RM 15R S 46°08 W
RM 14R N 42°35 W
18" DOUBLE OAK N.13°02' E. 305R
SCRIBED "N 1/16 S9 BT"

5

T31S R2W C CN1/16 S9 C PLS 866 1979

SET 2" PIPE & 2½" BRASS CAP
8" D FIR N.51°07' W. 16L
SCRIBED "CN 1/16 S9, BT"
NEW BT
6" CEDAR N39°14' E 49L
SCRIBED "CN 1/16 S9 BT"

6

T31S R2W N1/16 S9 S10 PLS 866 1979

SET 2" PIPE & 2½" BRASS CAP
12" CEDAR S 50°49' W 35L
SCRIBED "N 1/16 S9 BT"
16" PINE N82°49' E 30L
SCRIBED "N 1/16 S10 BT"

7

COUNTY SURVEYOR'S OFFICE T31S S9 1/4 R2W 1966

FOUND 1" PIPE & 2½" BRASS CAP
38" PINE N 23°45' E 159R
" ¼ S 9 CS BT" VISIBLE
20" CEDAR S 72°50' E 73R
" ¼ S9 CS BT" VISIBLE

8

T31S R2W C ¼ S9 PLS 866 1979

SET 2" PIPE & 2½" BRASS CAP
12" CEDAR S 42°37' W 223L
SCRIBED "C ¼ S9 BT"
16" D. FIR N 21°53' W 102L
SCRIBED "C ¼ S9 BT"
R.R. SPIKE IN ASPHALT E. 11L
6' STEEL FENCE POST W. 12L

9

COUNTY SURVEYOR'S OFFICE T31S R2W 1/4 S9 S10 1966

FOUND: 1" PIPE & 2½" BRASS CAP
12" CEDAR N.38°44' W. 31L
" ¼ S9 CS BT" VISIBLE
12" ROTTEN WINDFALL
S 65°30' W 31L
" ¼ S9 BT" VISIBLE
32" CEDAR S 15°39' E 21L
" ¼ S10 CS BT" VISIBLE

10

COUNTY SURVEYOR'S OFFICE T31S R2W 1/4 S9 S16 1966

FOUND: 1" PIPE & 2½" BRASS CAP
10" CEDAR N 36°11' W 21R " ¼ S9 CS BT" VISIBLE
38" CEDAR S 19°42' E 32L GOOD SCAR
30" D. FIR WINDFALL
N 30° E 25R

I, WILLIAM J RUPPERT, A REGISTERED PROFESSIONAL LAND SURVEYOR IN THE STATE OF OREGON HEREBY CERTIFY THAT THIS PLAT AND THE NOTES HEREON, OR ATTACHED, ARE A CORRECT REPRESENTATION OF A SURVEY I PERFORMED DURING JANUARY 1979 THRU MARCH 1979, FOR THE U.S. FOREST SERVICE, IN ACCORDANCE WITH STATUTES OF THE STATE OF OREGON AND WITH THE ARTICLES OF THE CONTRACT.

WILLIAM J. RUPPERT

CONTRACT 53-04HI-9-7198 N TILLER 33

REGISTERED OREGON LAND SURVEYOR
WILLIAM J. RUPPERT

MAP FILE 11-28-57

COUNTY SURVEYORS FILE DATA
DO NOT REMOVE FROM OFFICE