M70-64

COUNTY SURVEYORS FILE DATA
DO NOT REMOVE FROM OFFICE

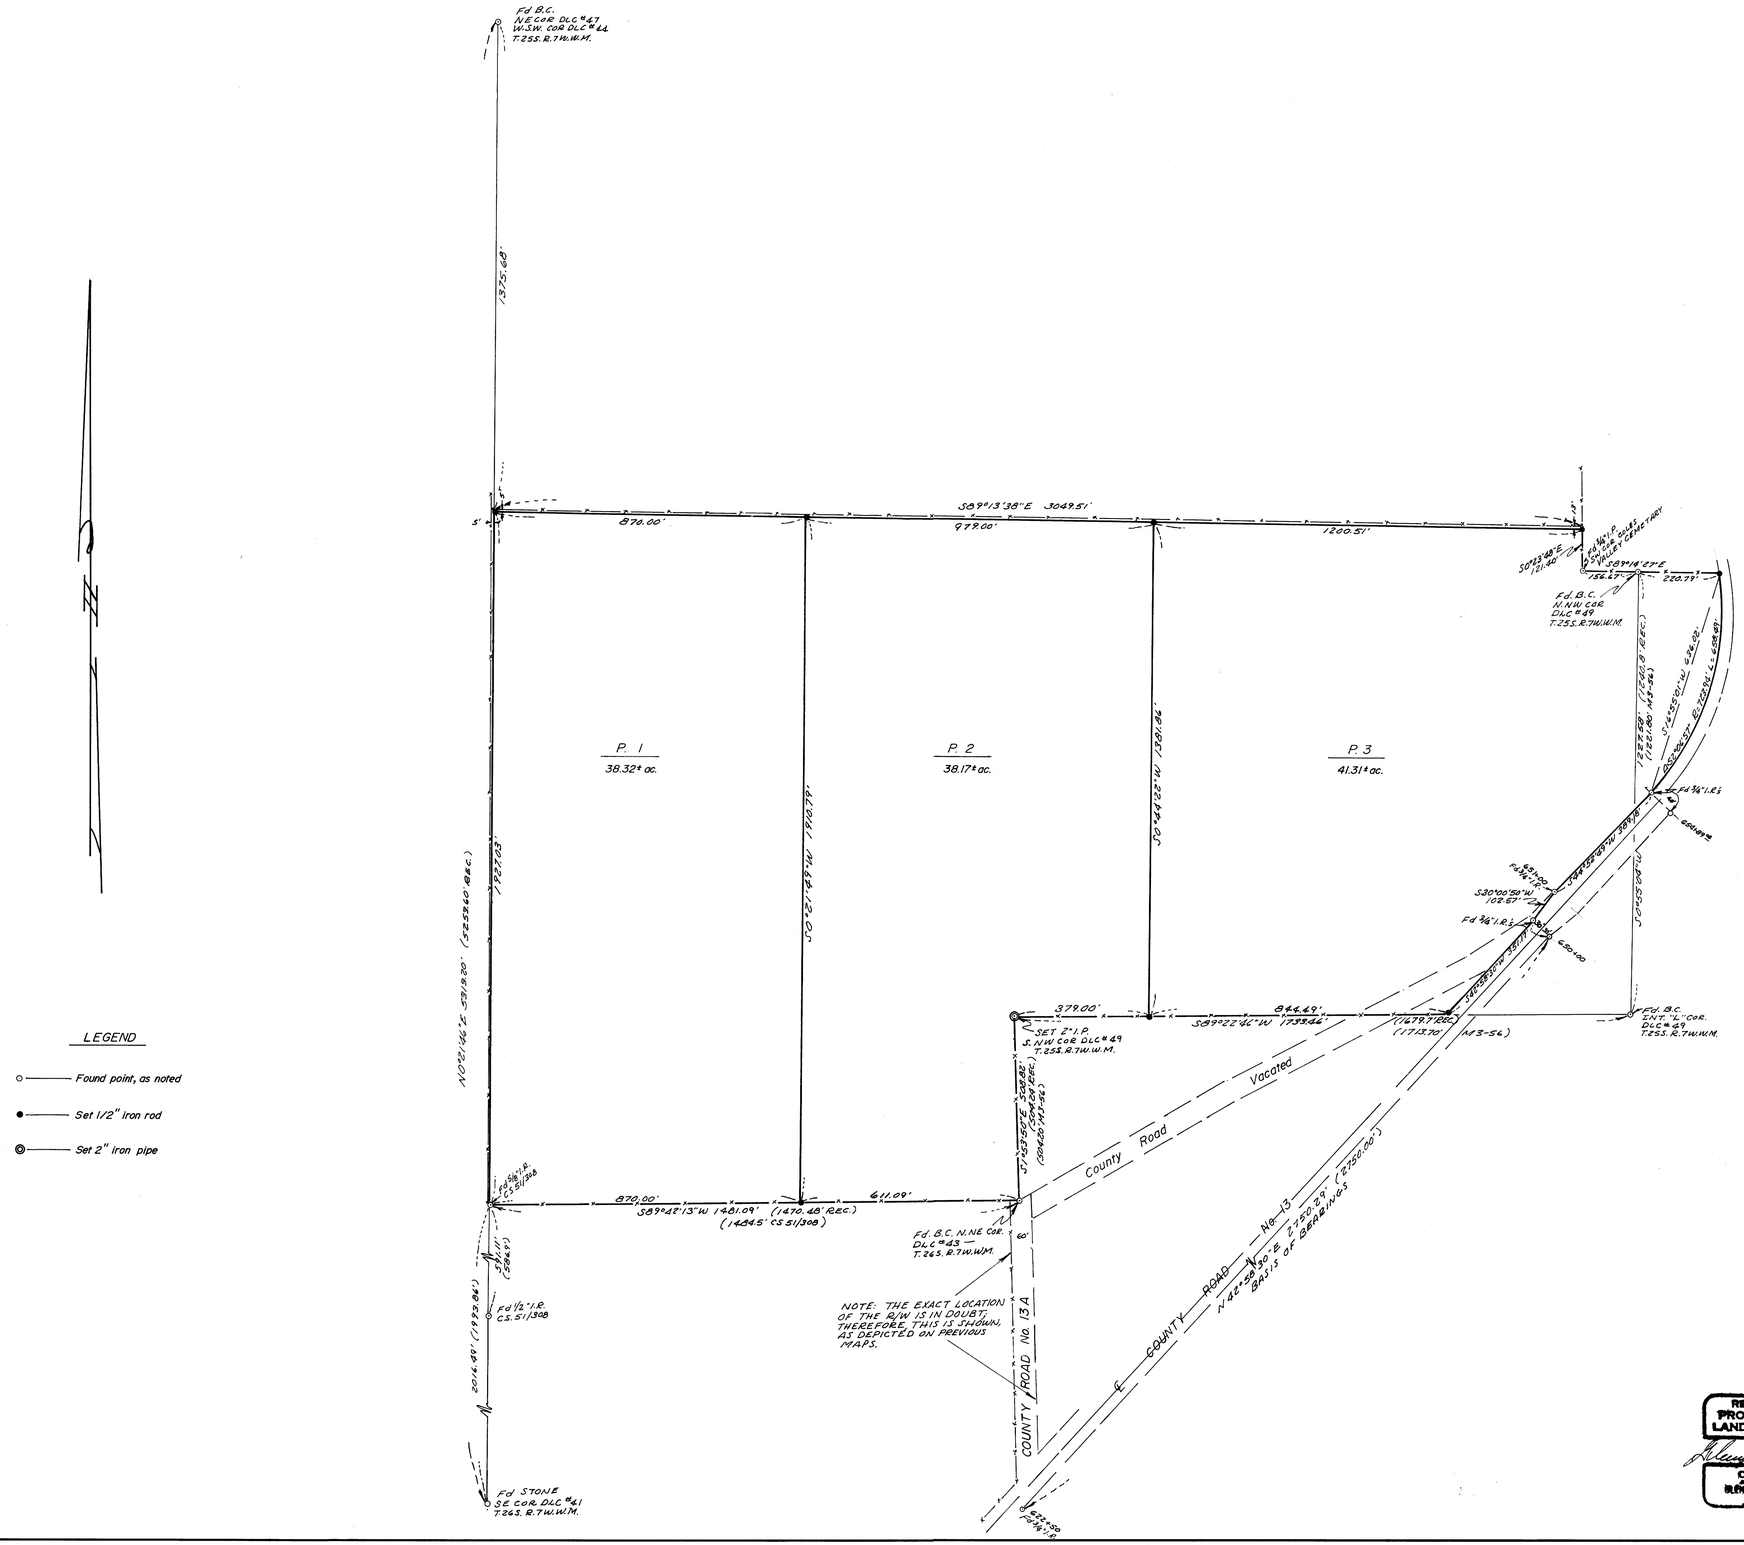


COUNTY SURVEYORS FILE DATA
DO NOT REMOVE FROM OFFICE

REGISTERED PROFESSIONAL LAND SURVEYOR
OREGON
GLENN L. BAUGHMAN
36

| | | |
|---|---|---|
| SURVEY FOR DESCRIPTION – SITUATED IN SECTIONS 35 & 36 T.25S.R.7W.W.M. & SECTION 2 T.26S.R.7W.W.M. | | |
| FOR: WINSTON SMITH | SCALE 1"=200' | DRAWN BY Eab<br>REVISED |
| BAUGHMAN TECHNICAL SERVICES INC. | | |
| DATE MAY 1979 | APPROVED BY | DRAWING NUMBER FM 1-71 |

K+E CRYSTALENE © 10 9458
ARCHITECTS' STANDARD FORM

MADE IN U.S.A.

M70-64