COUNTY SURVEYORS FILE DATA
DO NOT REMOVE FROM OFFICE

FILED
RECEIVED
JUN 26 1979
COUNTY SURVEYOR
ORE.

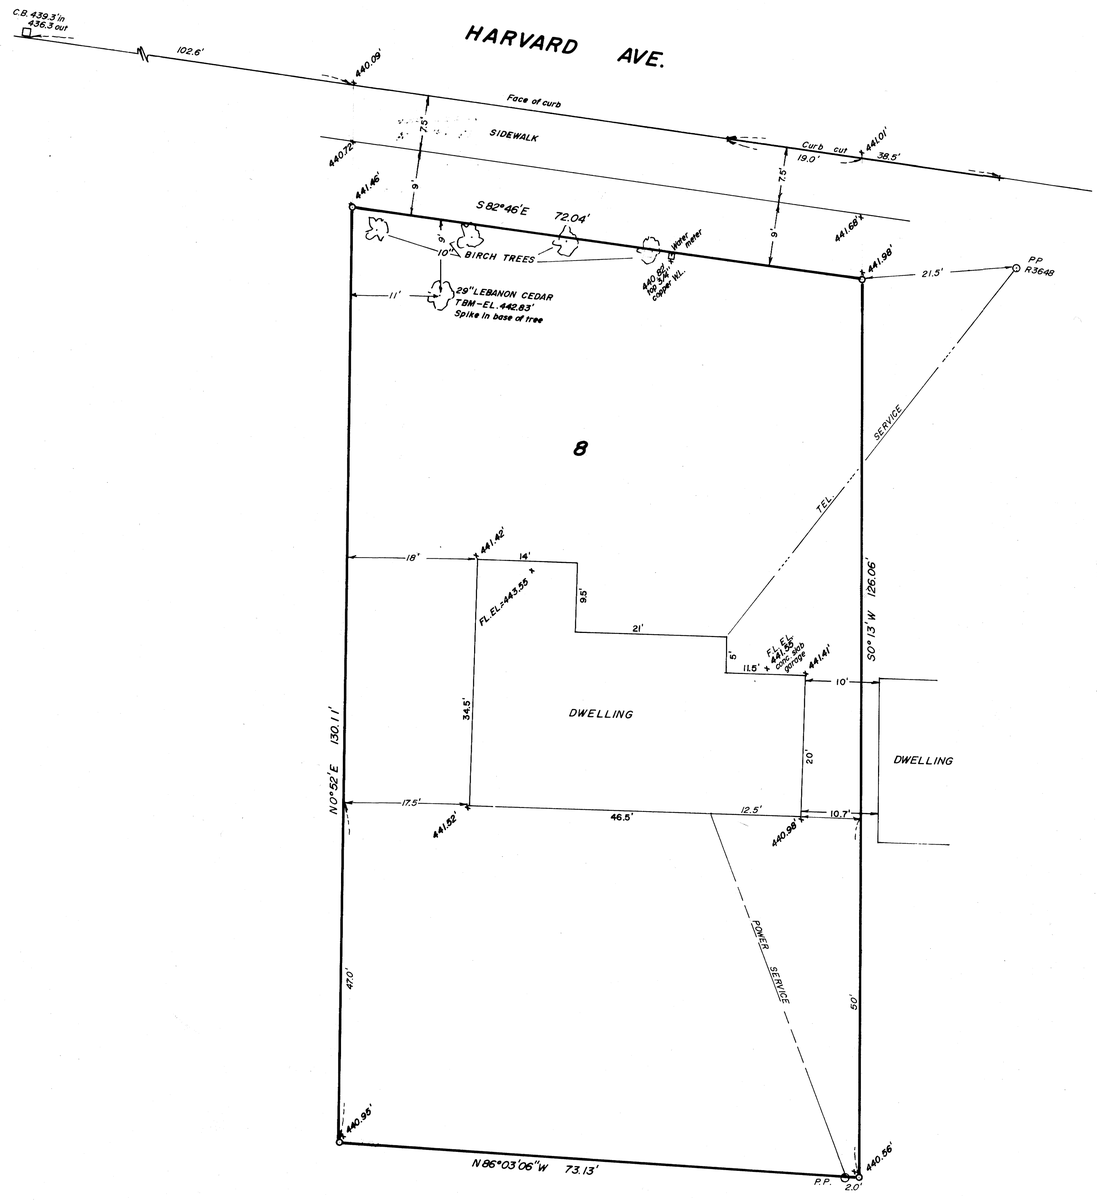

SCALE: 1" = 10'

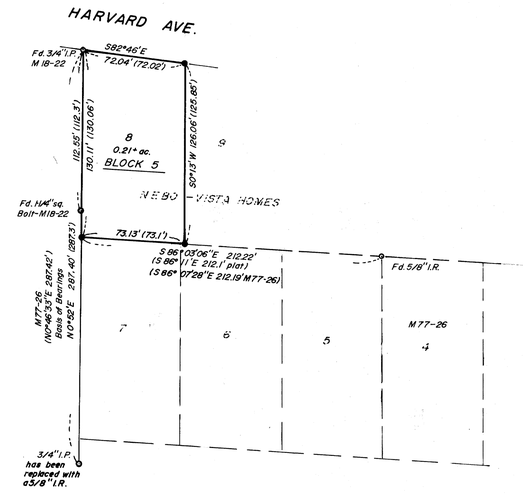

SCALE: 1" = 50'

LEGEND

● —— Set 1/2" iron rod

○ —— Found point, as noted

COUNTY SURVEYORS FILE DATA
DO NOT REMOVE FROM OFFICE

REGISTERED PROFESSIONAL LAND SURVEYOR
OREGON
GLENN E. BAUGHMAN
936

SURVEY OF LOT 8 BLOCK 5, NEBO-VISTA HOMES IN SECTION 23, T.27S. R.6W.W.M.		
FOR: GEORGE HEPNER	SCALE as shown	DRAWN BY edb / REVISED
BY: BAUGHMAN TECHNICAL SERVICES INC.		
DATE June 1979	APPROVED BY	DRAWING NUMBER FM 1-75

K+E CRYSTALENE ® 10 9458 ARCHITECTS' STANDARD FORM

MADE IN U.S.A.

MAP FILE M 76 - 71