MAP FILE M 70-77

COUNTY SURVEYORS FILE DATA
DO NOT REMOVE FROM OFFICE

FILED
RECEIVED BS
JUL 18 1979
COUNTY SURVEYOR
DOUGLAS COUNTY, ORE.
DK

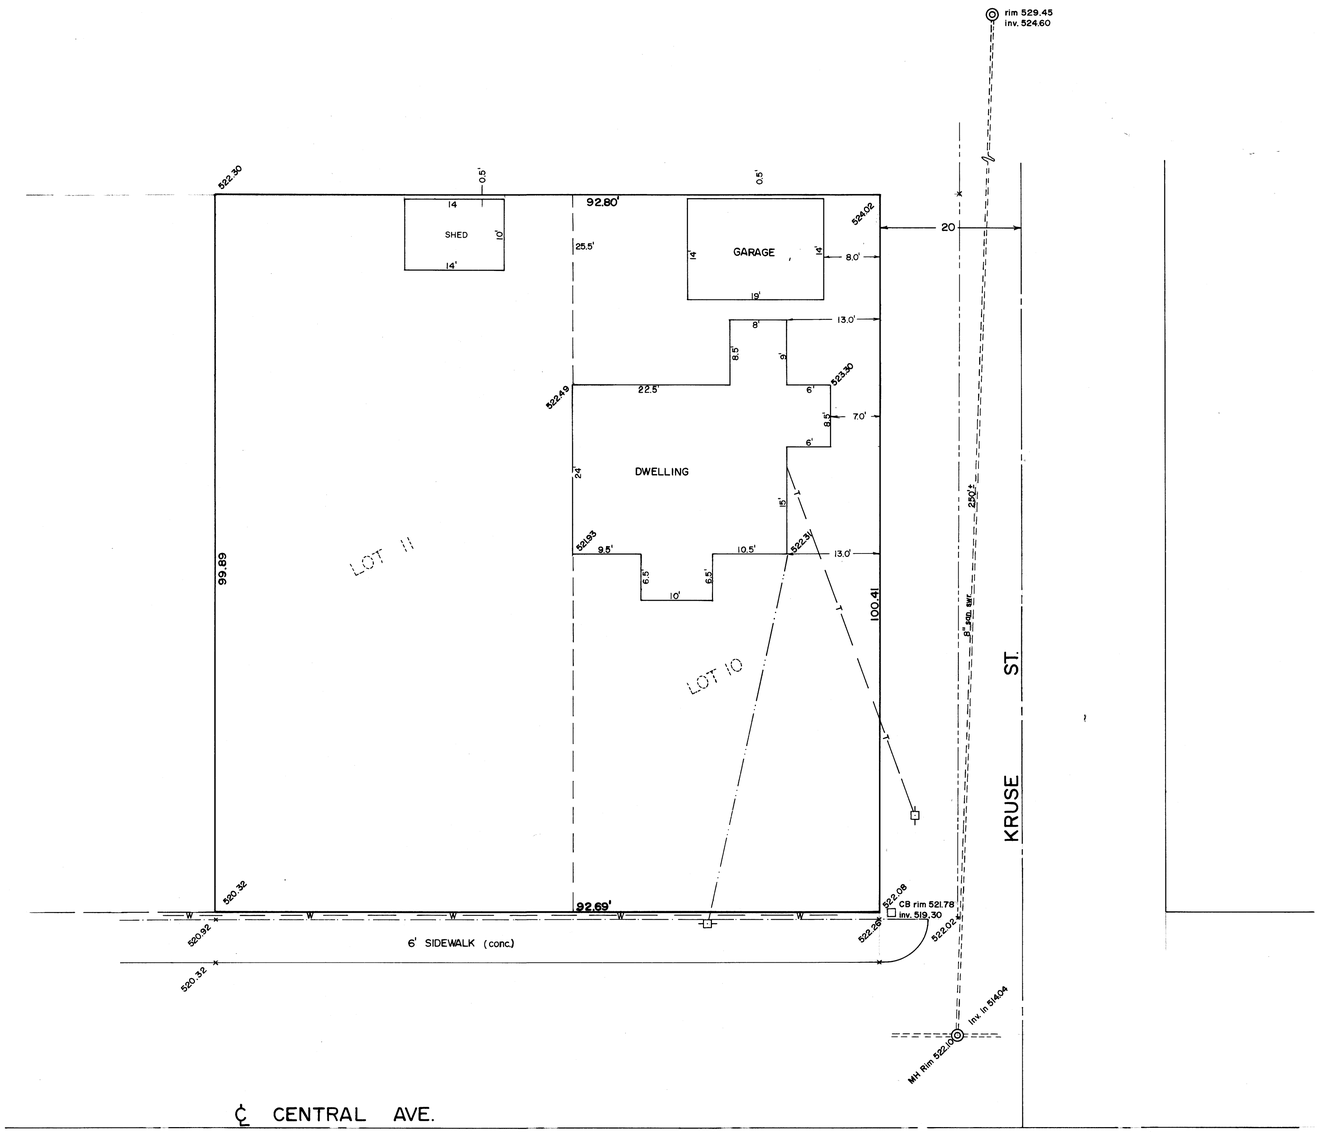

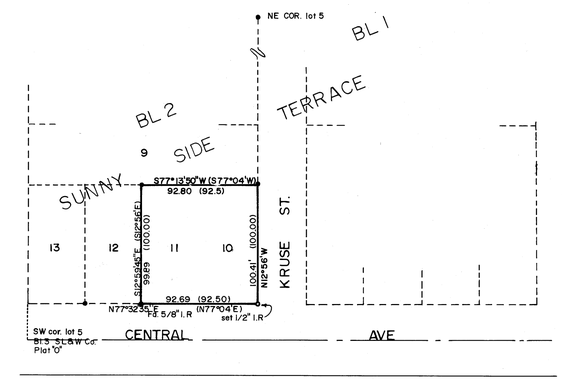

BEARINGS BASED ON WEST LINE OF KRUSE ST., S12°56'E

LEDGEND

● Fd 1/2" I.P. unless otherwise noted
○ Set mon as noted

SCALE 1"=60'

SYMBOLS

- BACK OF SIDEWALK
- W — W — 4" WATERLINE
- POWER LINE (service)
- T — T — TEL LINE
- EDGE OF A.C.
- POWER POLE
- MANHOLE
- CATCH BASIN

SCALE 1"=10'

COUNTY SURVEYORS FILE DATA
DO NOT REMOVE FROM OFFICE

REGISTERED PROFESSIONAL LAND SURVEYOR
OREGON
JULY 14, 1961
GLENN S. BAUGHMAN
536

A SURVEY OF LOTS 10 & 11, BL.2, SUNNY SIDE TERRACE, IN SECS. 18 & 19 T25S R5W WM		
FOR DR. WARREN KADAS	SCALE: AS SHOWN	DRAWN BY / REVISED
BY BAUGHMAN TECHNICAL SERVICES INC.		
DATE: 9/17/79	APPROVED BY	DRAWING NUMBER

K+E CRYSTALENE® 10 5458
ARCHITECTS' STANDARD FORM

MADE IN U.S.A.

MAP FILE M 70-77