MAP FILE M 71- 35

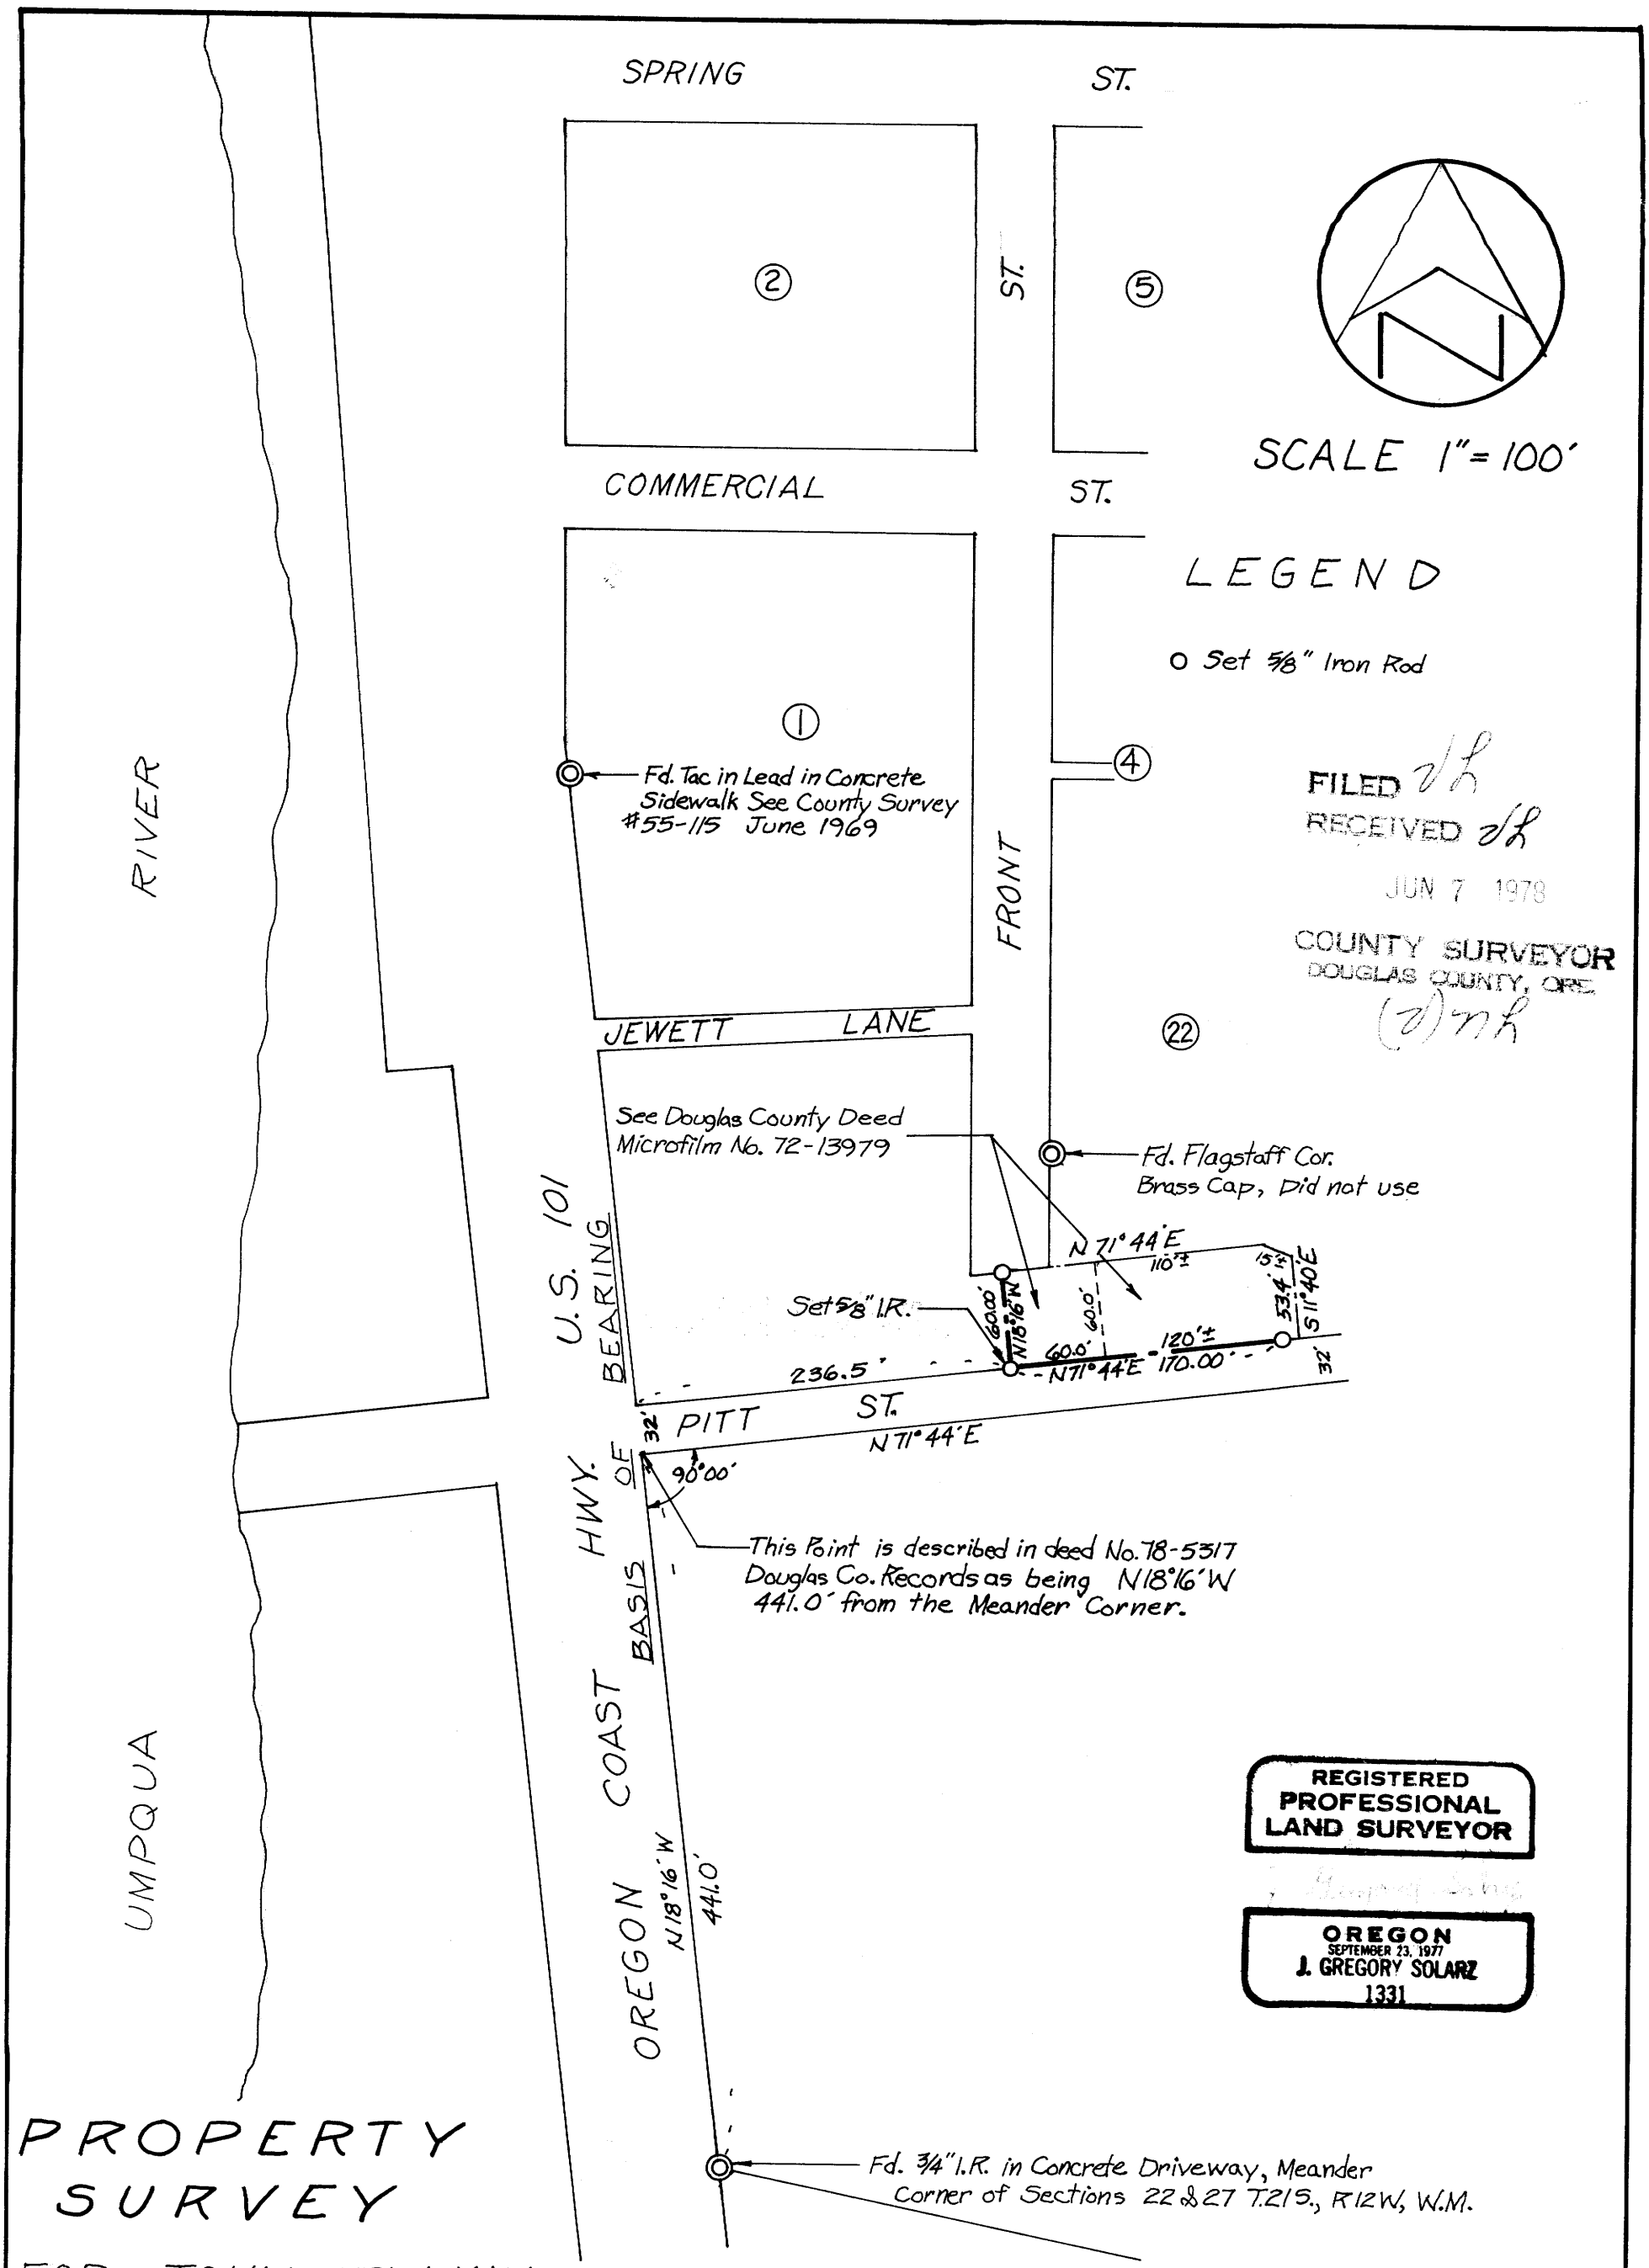

PROPERTY SURVEY

FOR: JOHN STULKIN

IN THE SW¼, SE¼ SEC. 22 T21S, R12W, W.M.
GARDINER, DOUGLAS COUNTY,
OREGON SCALE 1"=100' 5/18/78

COUNTY SURVEYORS FILE DATA
DO NOT REMOVE FROM OFFICE

KOOS ENGINEERING 2561 BROADWAY, NORTH BEND, OREGON

MAP FILE M 71- 35 # 143