COUNTY SURVEYORS FILE DATA
DO NOT REMOVE FROM OFFICE

M71-55

FILED
RECEIVED LC
JUN 23 1978
COUNTY SURVEYOR
DOUGLAS COUNTY, ORE.

SURVEY IN SECTION 31, T. 24 S., R. 3 W., W.M.
SURVEYED FOR JOE COLE & STAN MOHR
SURVEYED BY R. H. GEE
JUNE, 1978 SCALE 1" = 200'

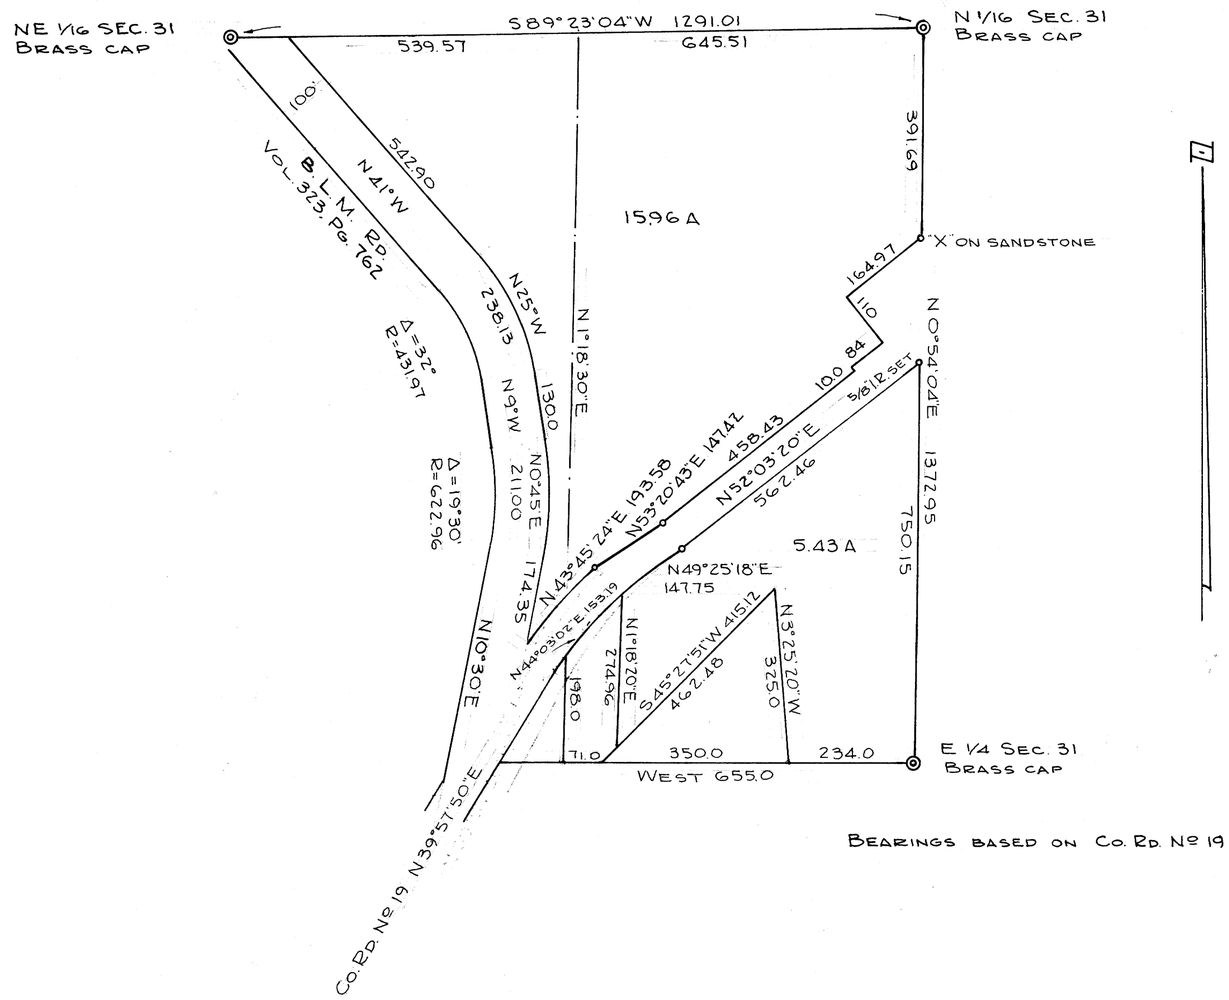

BEARINGS BASED ON Co. Rd. No 19

REGISTERED PROFESSIONAL LAND SURVEYOR
R. H. Gee
OREGON
R. H. GEE

MAP FILE M71-55