9 - 1L

COUNTY SURVEYOR FILE COPY
DO NOT REMOVE FROM OFFICE

FILED & RECORDED
MAY 1 1 1978
COUNTY SURVEYOR
DOUGLAS COUNTY, ORE.

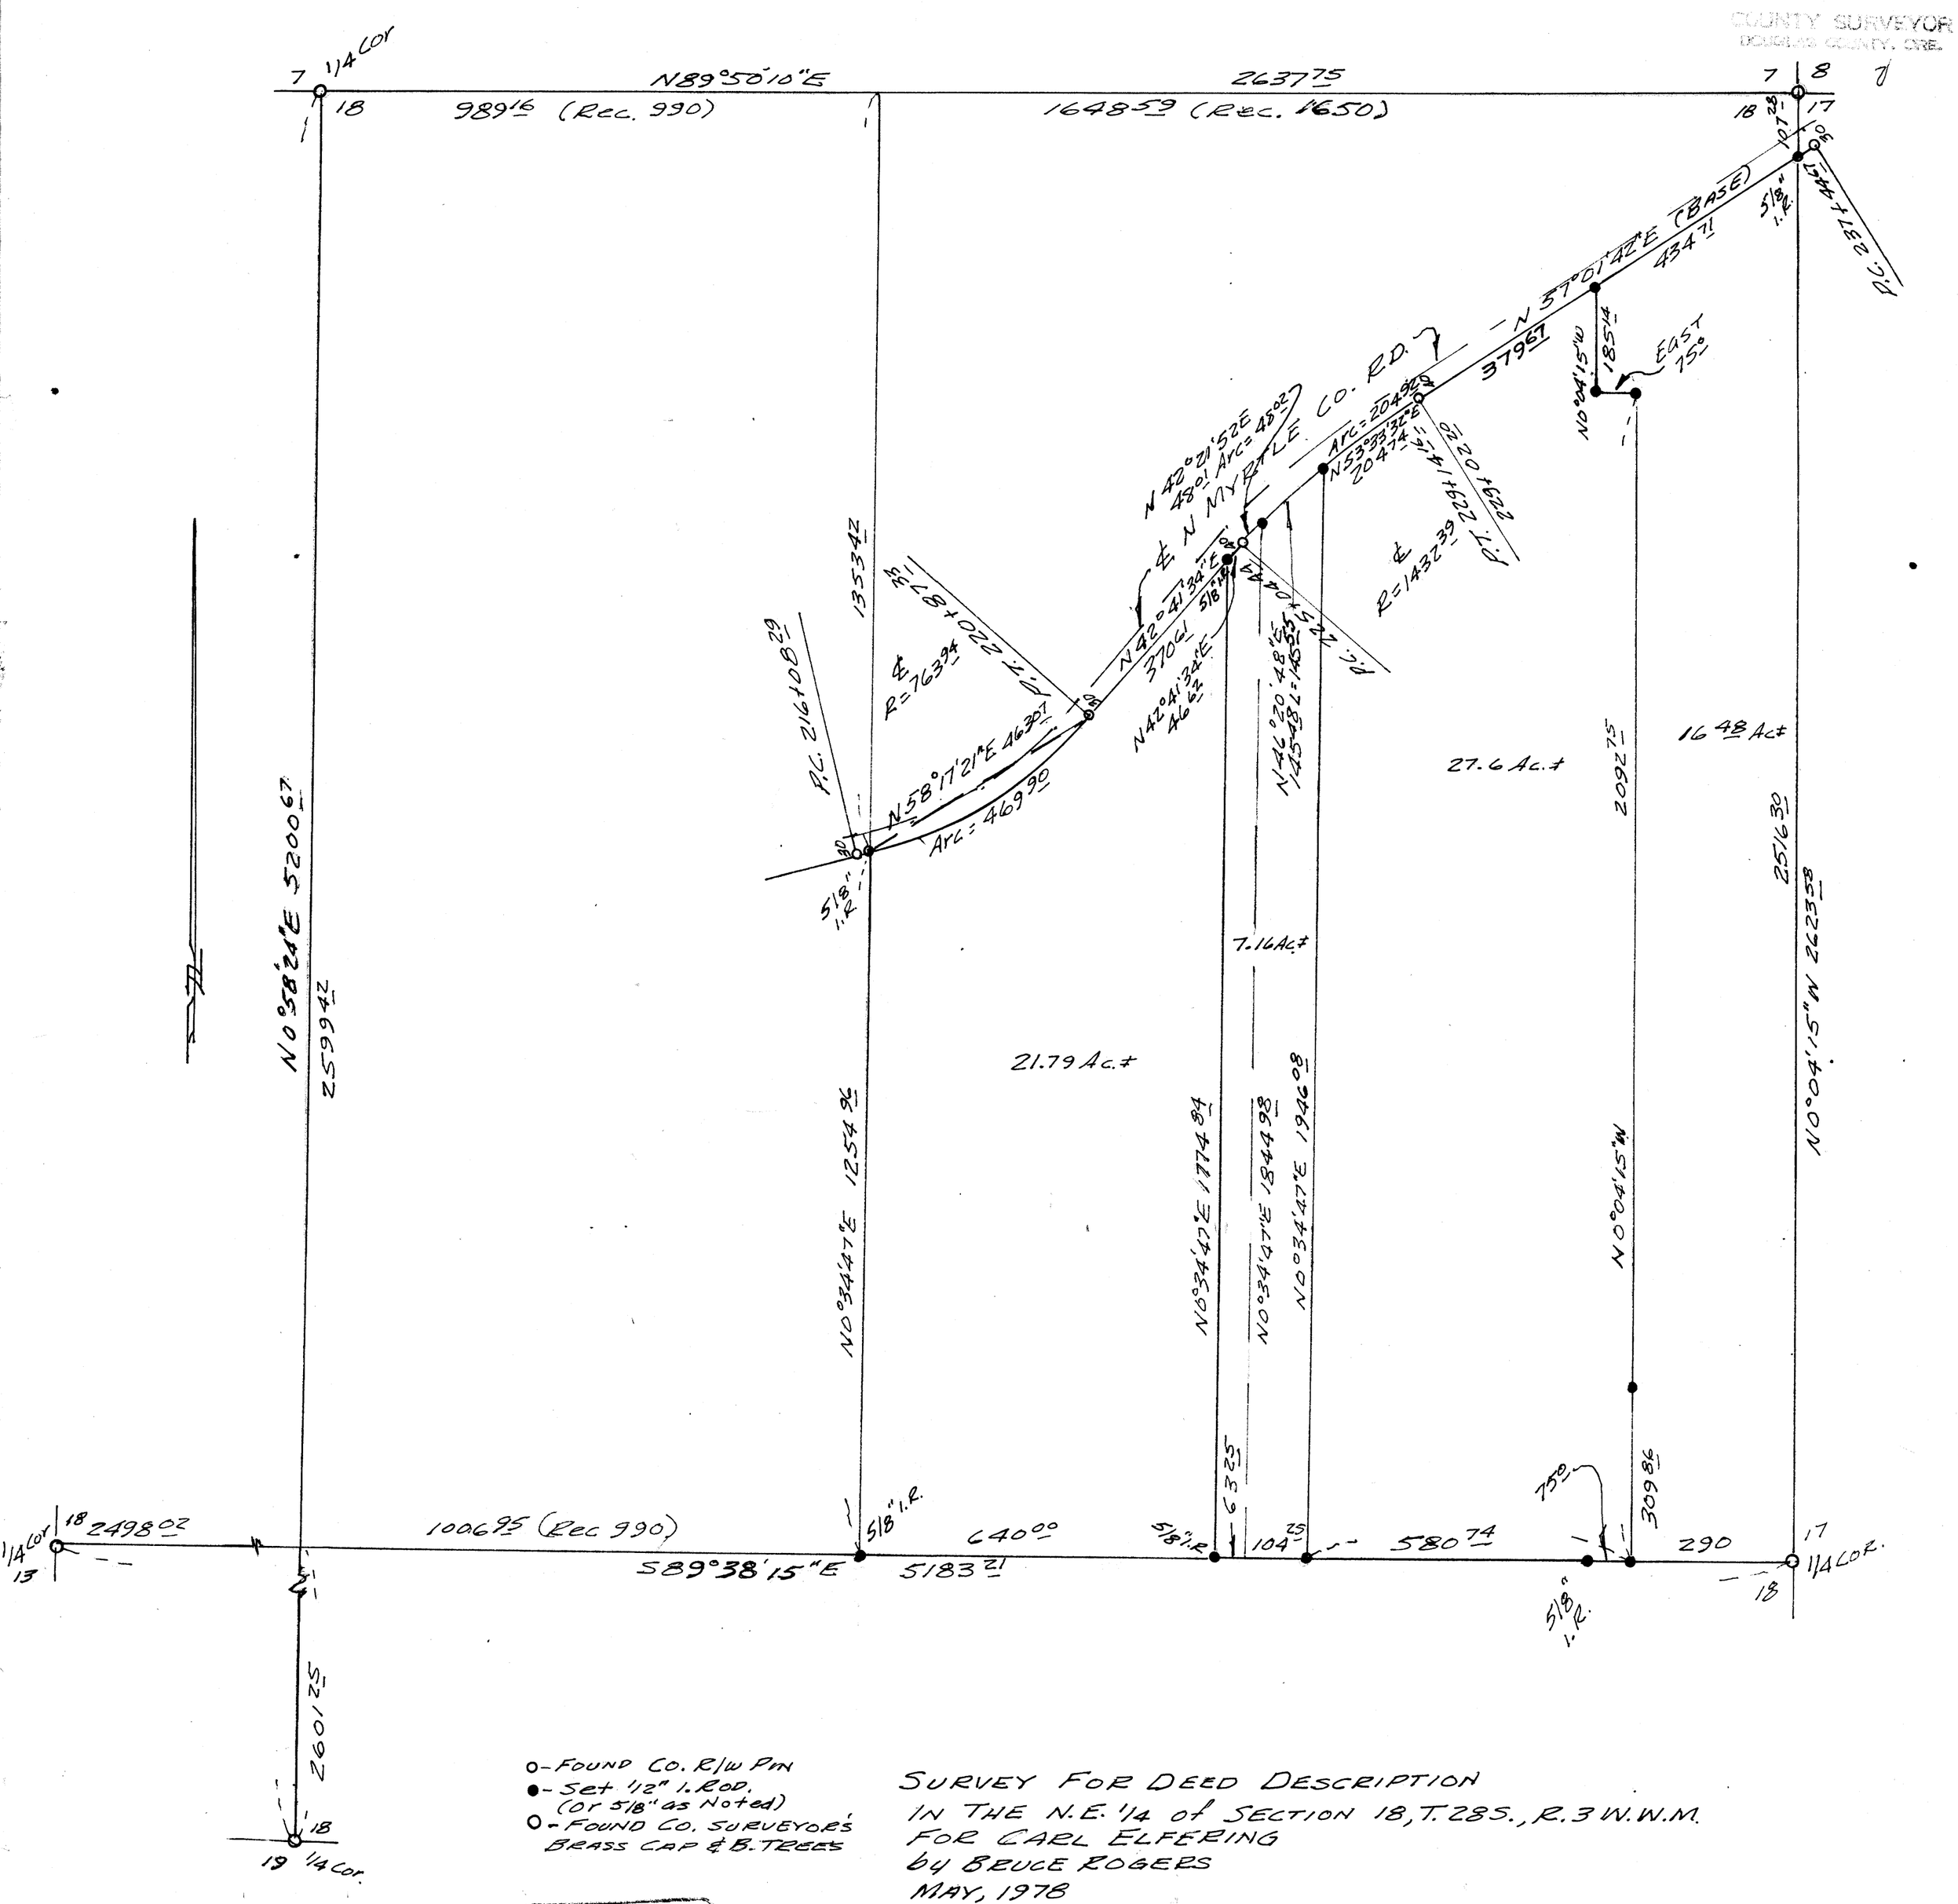

O - Found Co. R/W Pin
● - Set 1/2" I. Rod. (or 5/8" as Noted)
O - Found Co. Surveyor's Brass Cap & B. Trees

SURVEY FOR DEED DESCRIPTION
IN THE N.E. 1/4 of SECTION 18, T.28S., R.3W.W.M.
FOR CARL ELFERING
by BRUCE ROGERS
MAY, 1978
1" = 200'

REGISTERED
OREGON
LAND SURVEYOR

Bruce R. Rogers

JULY 10, 1964
BRUCE R. ROGERS
660

MAP FILE 71 - 6