COUNTY SURVEYORS FILE DATA
DO NOT REMOVE FROM OFFICE

SURVEY FOR J. CLIFTON HATCHER
LOCATED IN SECTION 7, T30S, R5W, WM
JULY, 1978

BY HAROLD BALL L.S.

FILED
RECEIVED
JUL 5 1978
COUNTY SURVEYOR
DOUGLAS COUNTY, ORE.

MAP FILE M 77-68

REGISTERED
PROFESSIONAL
LAND SURVEYOR
Harold L Ball
OREGON
SEPT. 23, 1977
HAROLD L. BALL
1123

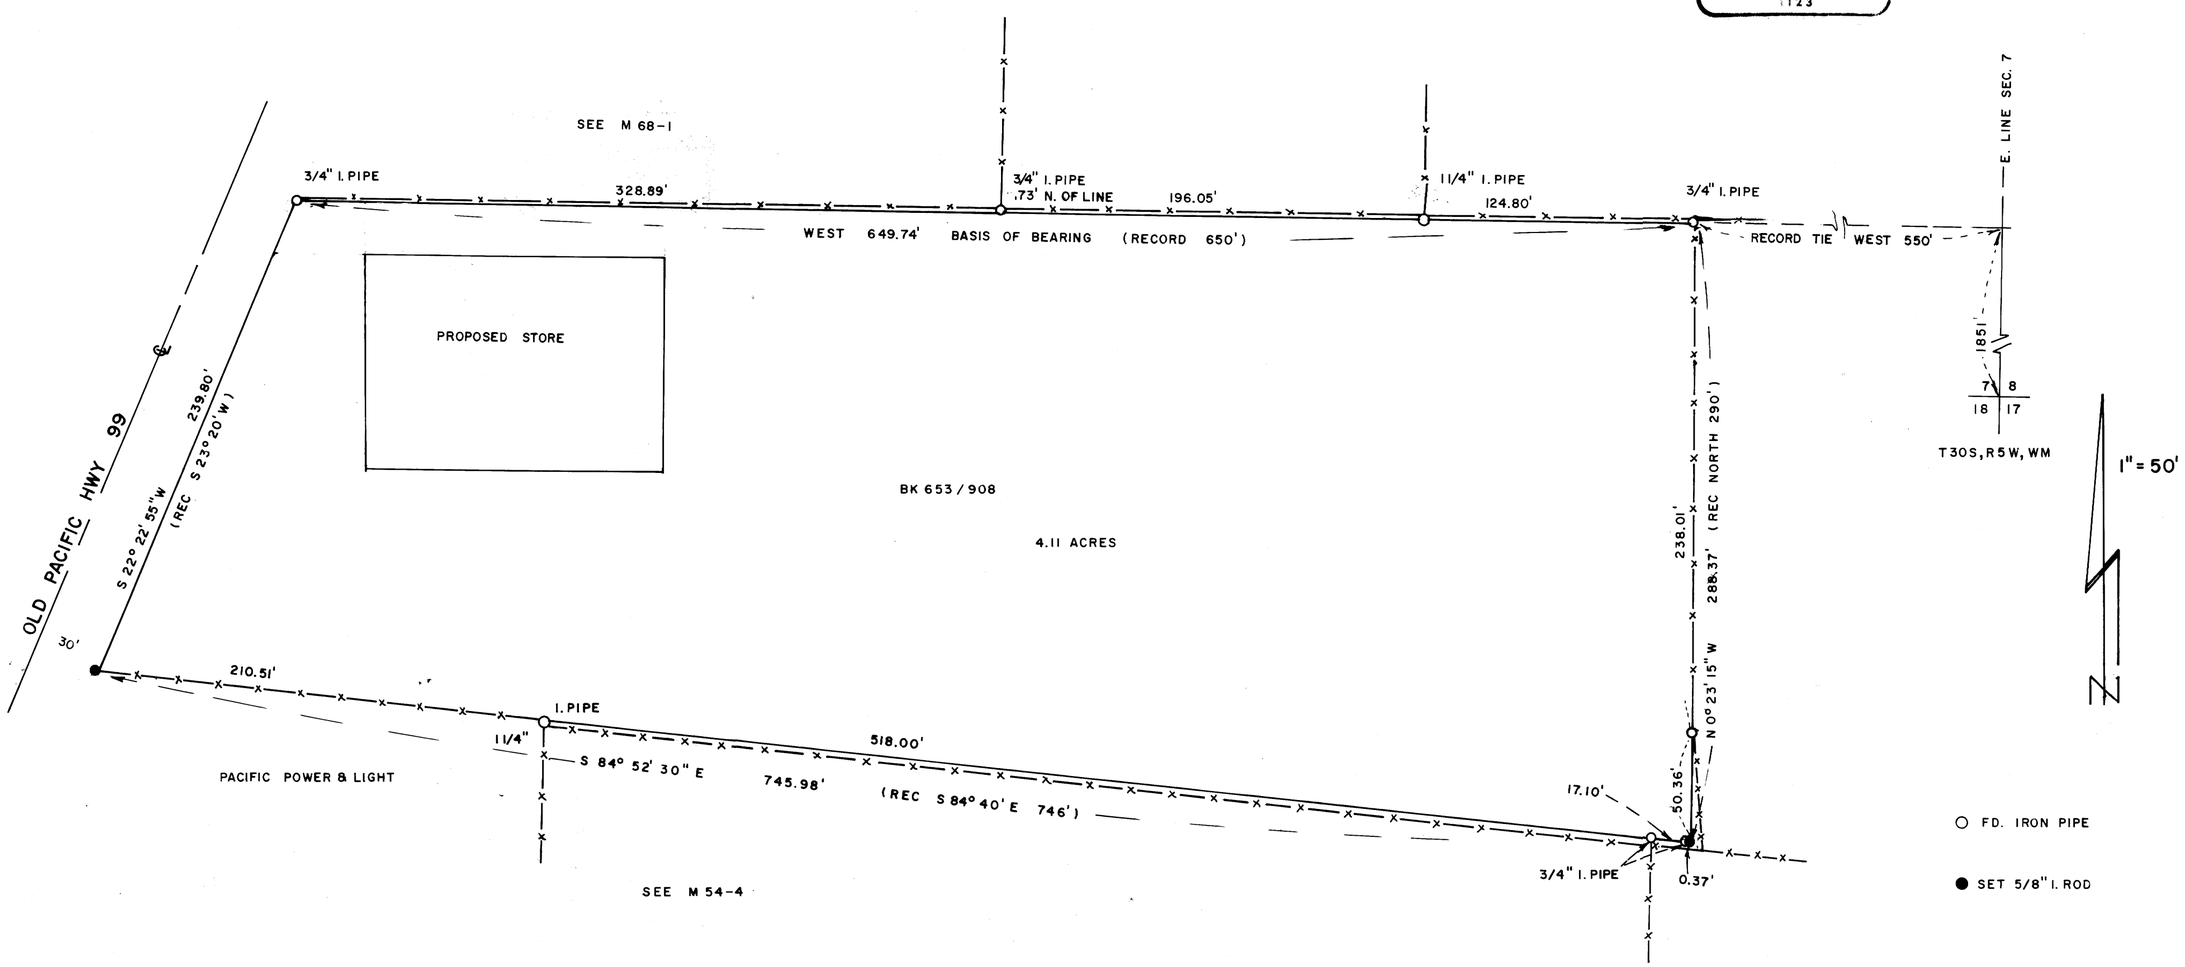

MAP FILE M 77-68