MAP FILE M 71 - 80

SURVEY TO SET PROPERY CORNERS

IN LOT 1 WADE ADDITION — SECTION 19 T25S R5WWM - JULY 1978

SCALE: 1"=100'

COUNTY SURVEYORS FILE DATA
DO NOT REMOVE FROM OFFICE

FOR: SELMAR A. HUTCHINS

BY: BAUGHMAN TECHNICAL SERVICES INC.

FILED
RECEIVED
JUL 12 1978
COUNTY SURVEYOR
DOUGLAS COUNTY, ORE.
TB

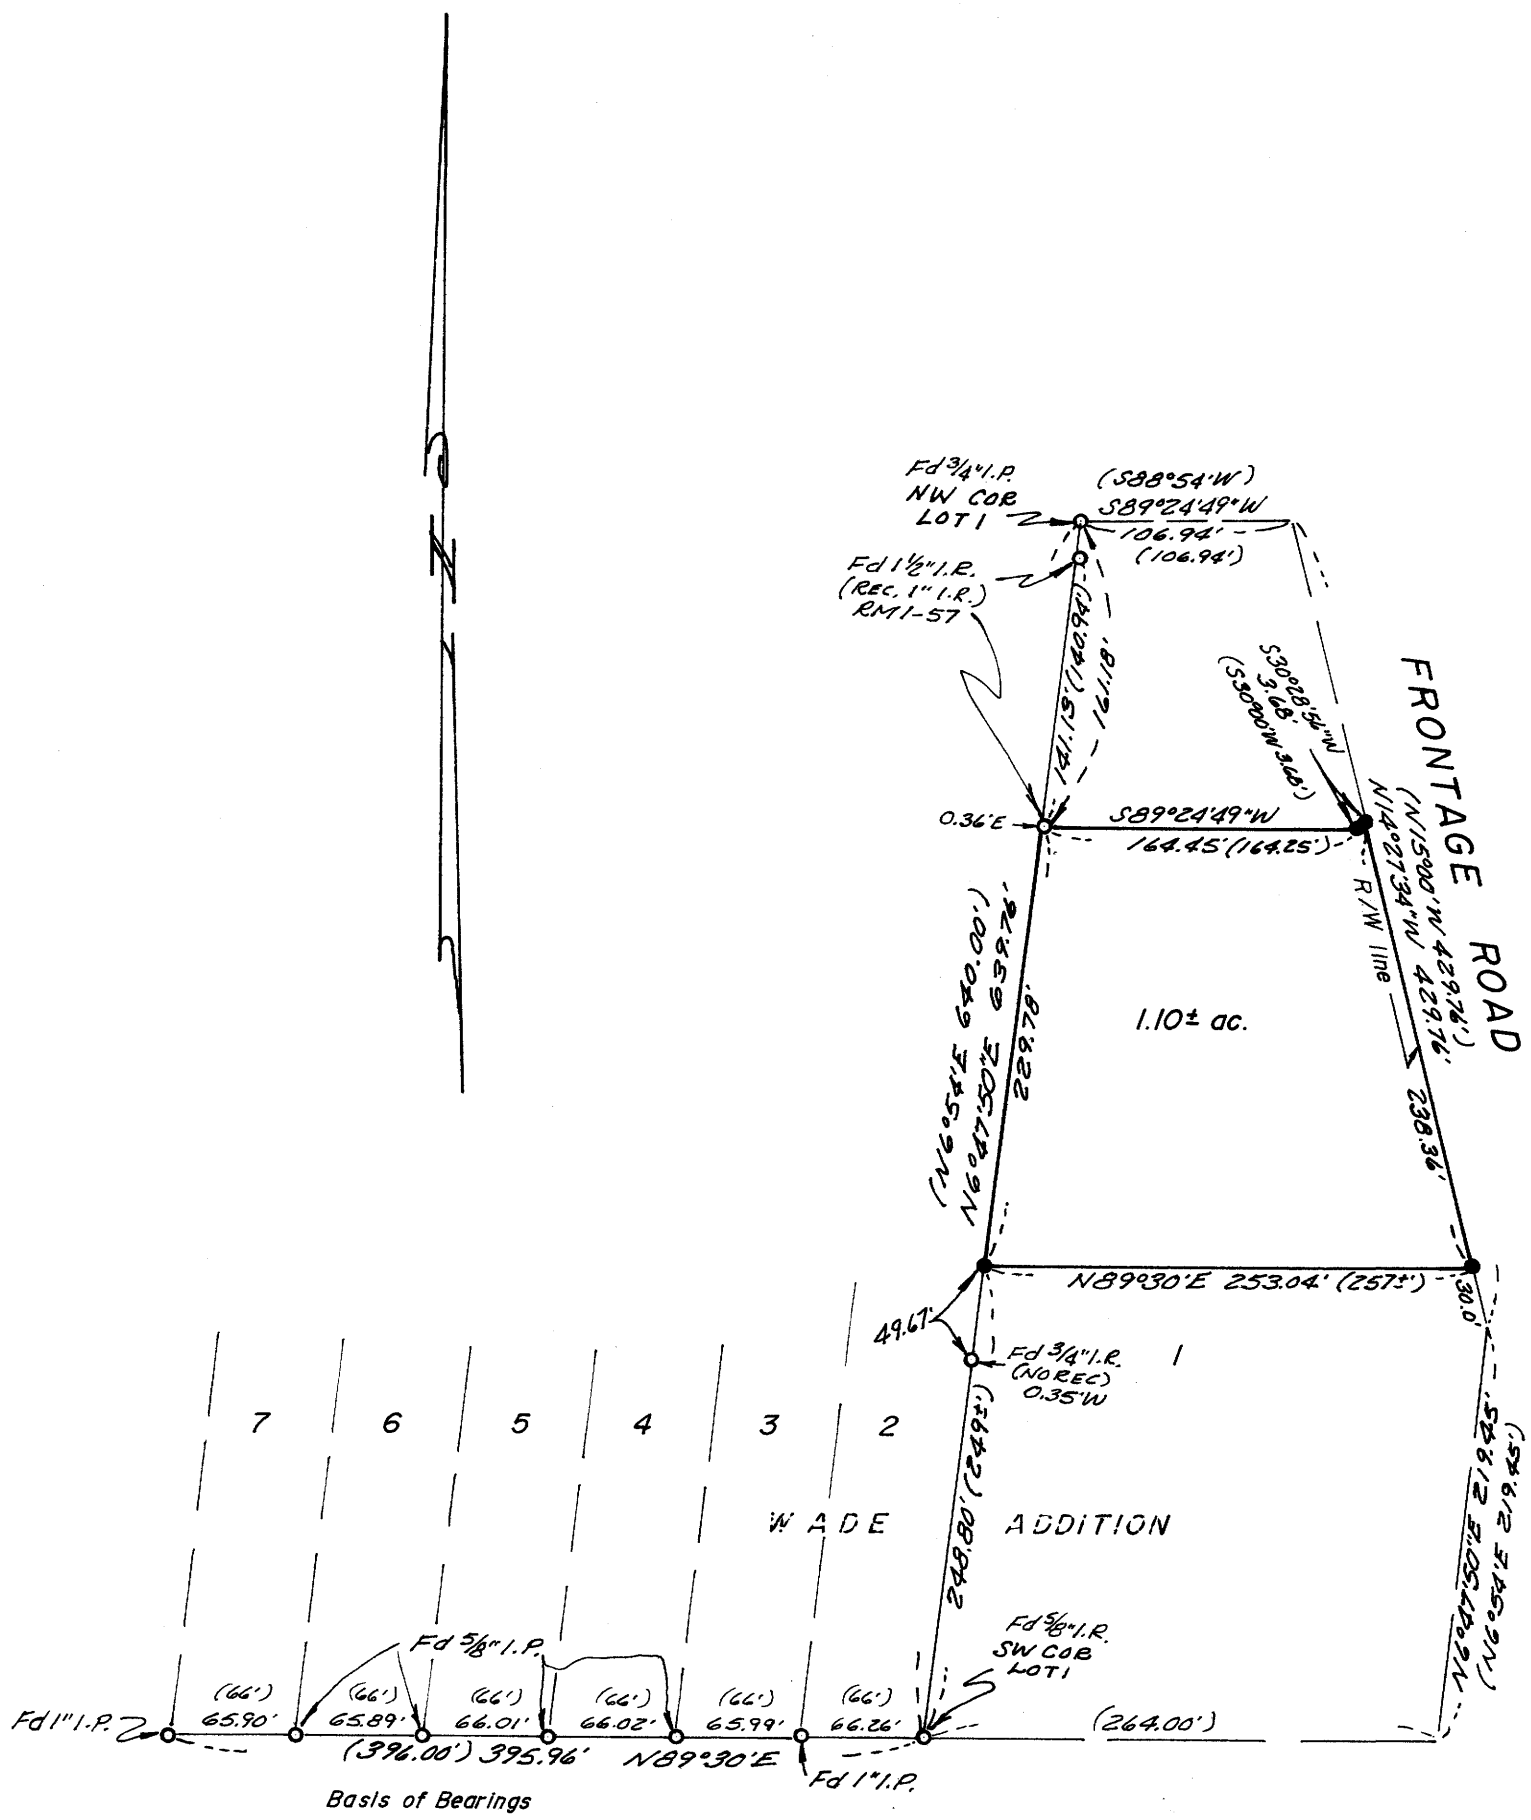

LEGEND

● —— Set 1/2" iron rod

○ —— Found point, as noted.

REGISTERED PROFESSIONAL LAND SURVEYOR

Glenn S. Baughman

OREGON
JULY 14, 1951
GLENN S. BAUGHMAN
536

MAP FILE M 71 - 80

FM 4-797