MAP FILE M72-11

SURVEY FOR DESCRIPTION

IN SECTION 19, T.28S. R.6W.W.M. - JULY 1978

FOR: RICHARD ROPP

BY: BAUGHMAN TECHNICAL SERVICES INC.

FILED
RECEIVED
JUL 17 1978
COUNTY SURVEYOR
DOUGLAS COUNTY, ORE.

SCALE: 1"=100'

COUNTY SURVEYORS FILE DATA
DO NOT REMOVE FROM OFFICE

REGISTERED
PROFESSIONAL
LAND SURVEYOR

Glenn S. Baughman

OREGON
JULY 14, 1961
GLENN S. BAUGHMAN
536

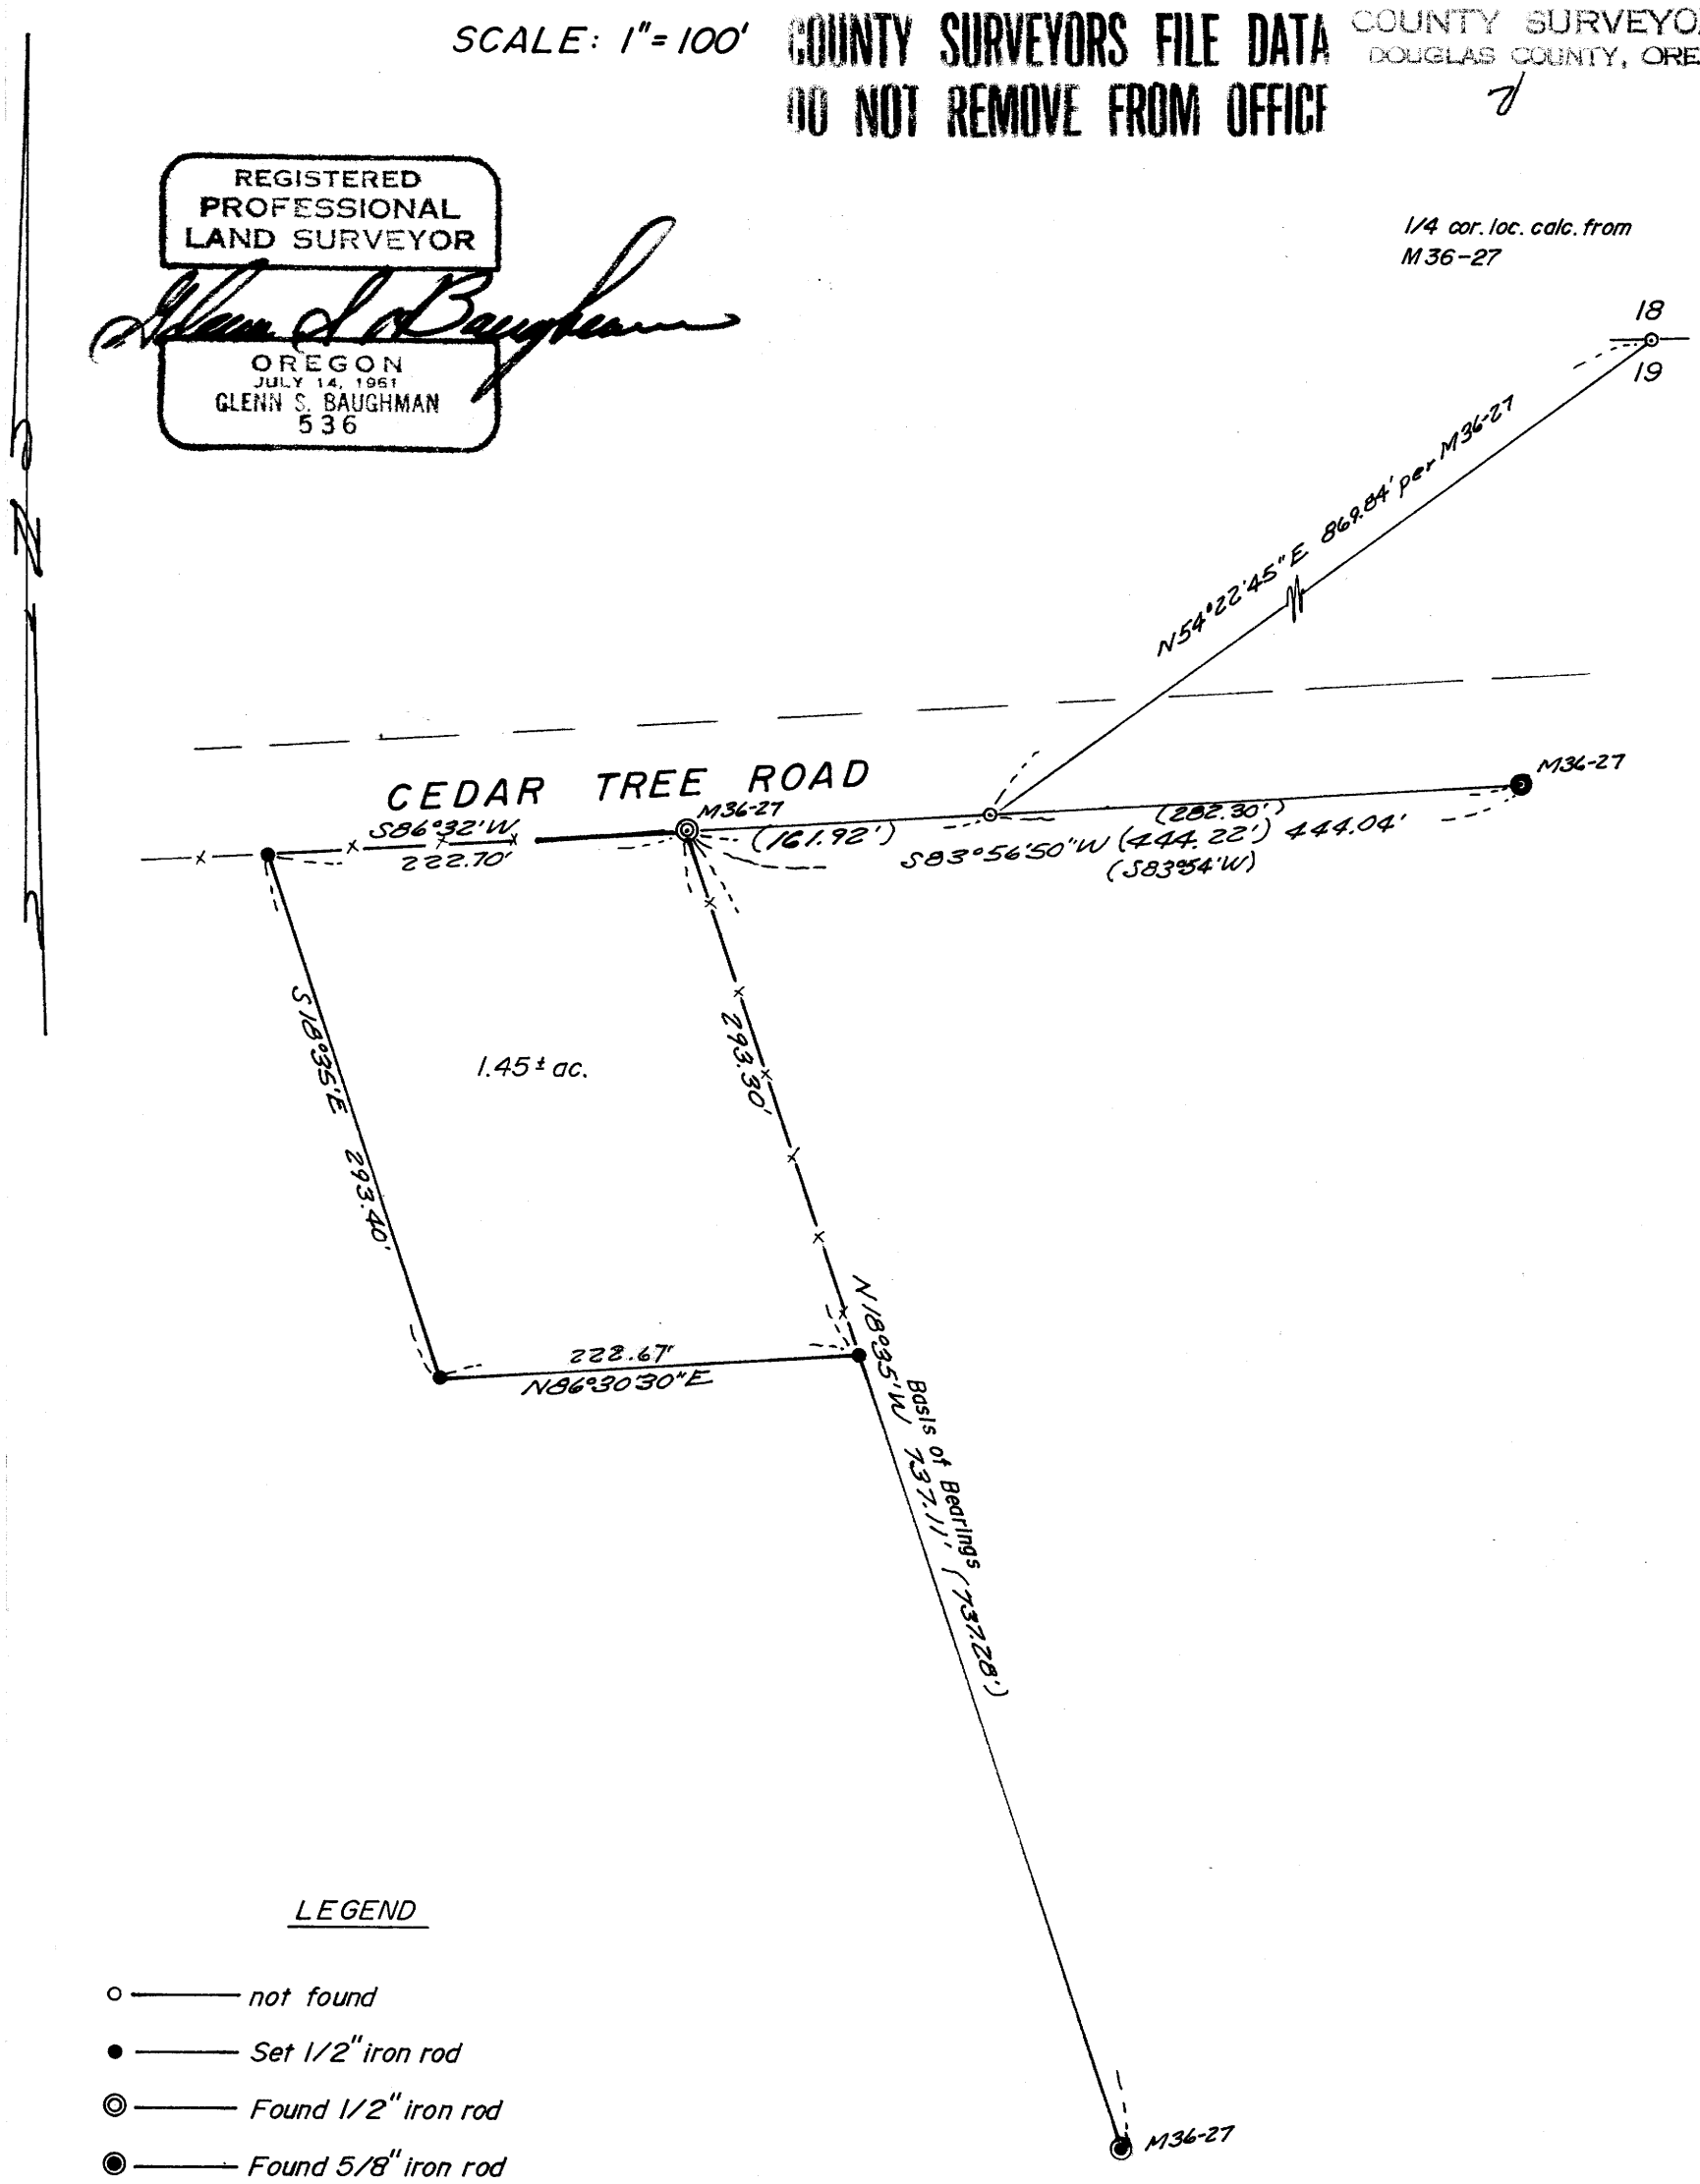

LEGEND

- ○ —— not found
- ● —— Set 1/2" iron rod
- ◎ —— Found 1/2" iron rod
- ◉ —— Found 5/8" iron rod
- ⊙ —— Found "X" chiseled in rock

FM 4-798

MAP FILE M72-11