FILED
RECEIVED
JUL 18 1978
COUNTY SURVEYOR
DOUGLAS COUNTY, ORE.
TB

MAP FILE M72-15

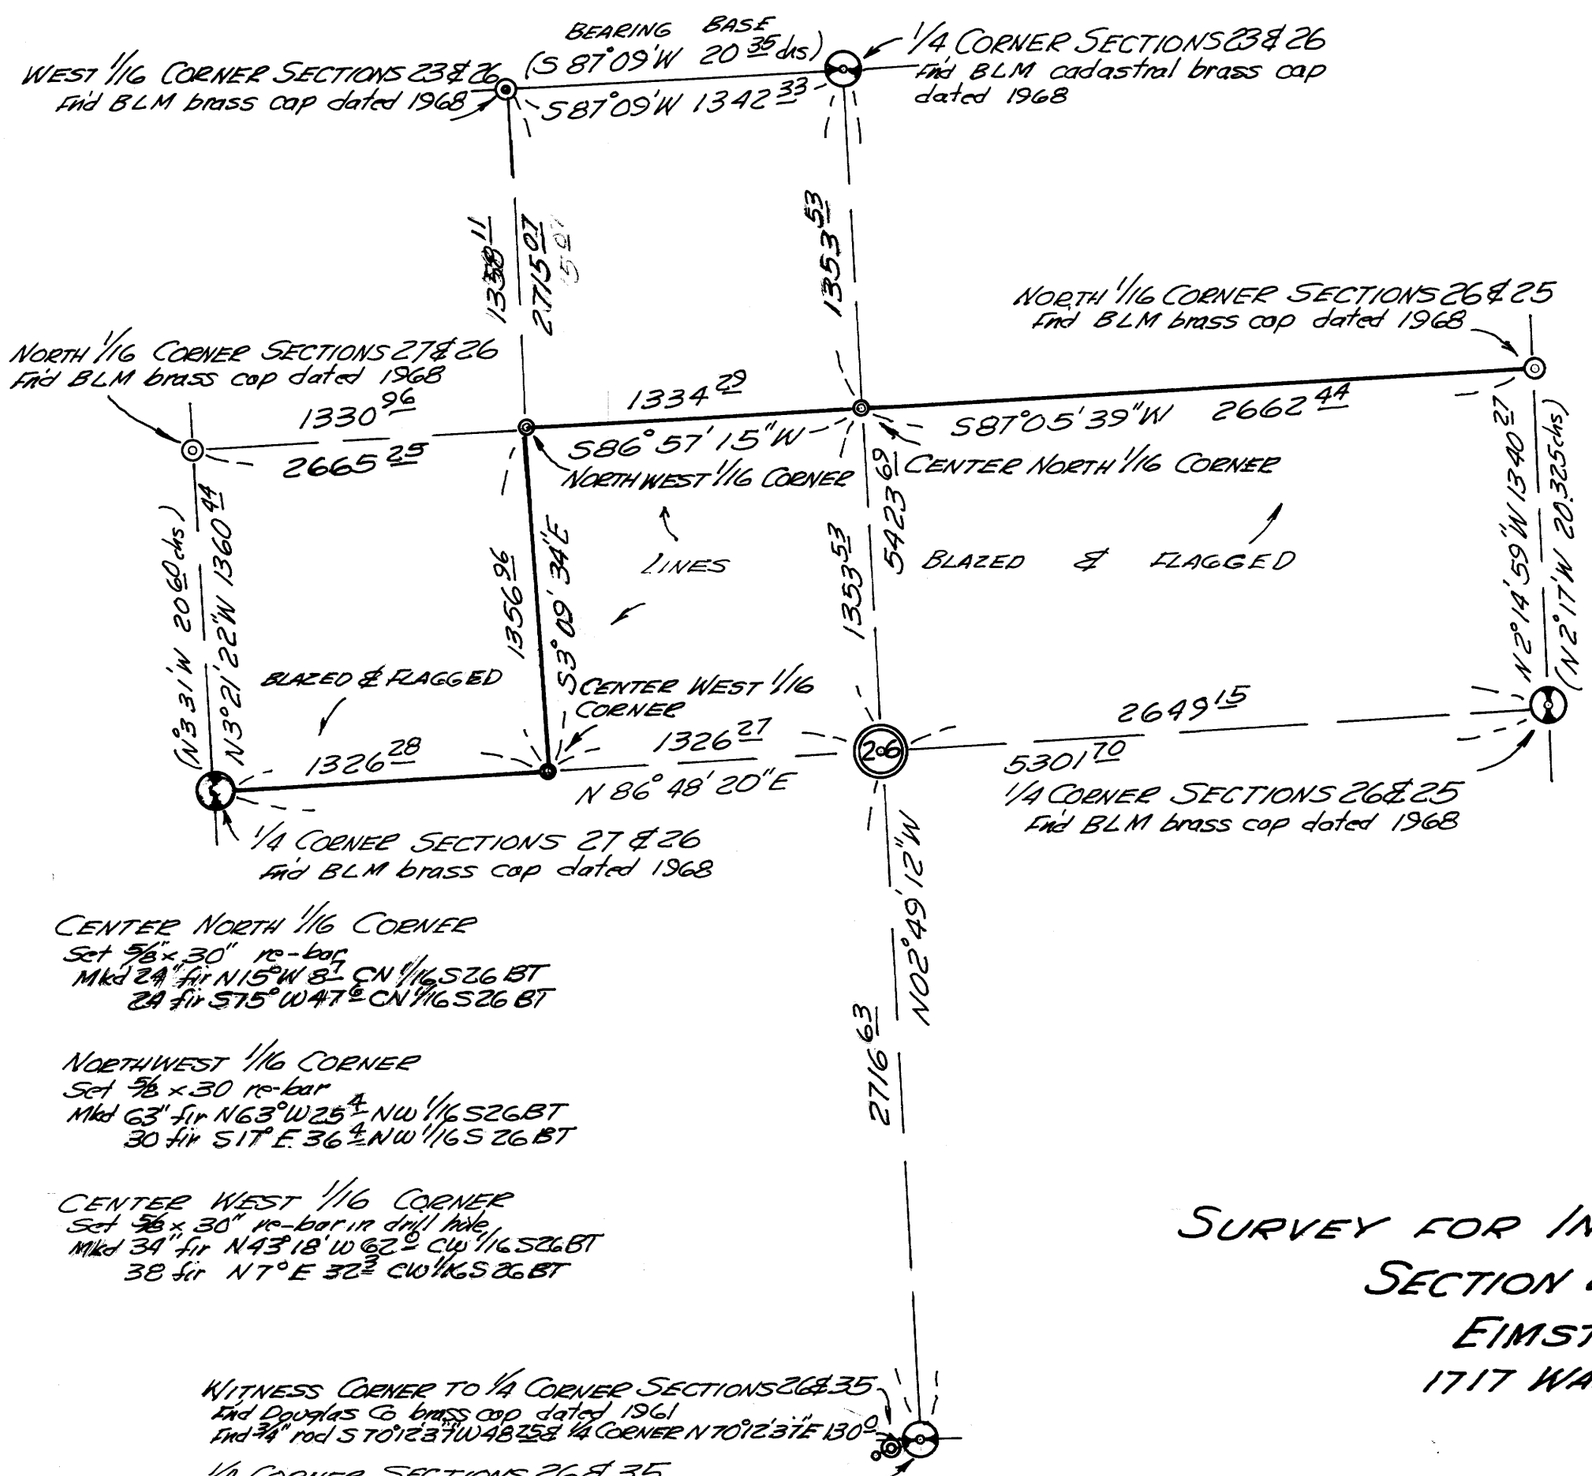

CENTER NORTH 1/16 CORNER
Set 5/8 x 30" re-bar
Mkd 24 fir N15°W 8 1/2 CN 1/16 S26 BT
24 fir S75°W 47 1/2 CN 1/16 S26 BT

NORTHWEST 1/16 CORNER
Set 5/8 x 30 re-bar
Mkd 63" fir N63°W 25 1/4 NW 1/16 S26 BT
30 fir S17°E 36 1/4 NW 1/16 S26 BT

CENTER WEST 1/16 CORNER
Set 5/8 x 30" re-bar in drill hole
Mkd 34" fir N43°18'W 62 1/2 CW 1/16 S26 BT
38 fir N7°E 32 3/4 CW 1/16 S26 BT

REGISTERED PROFESSIONAL LAND SURVEYOR
William A. Eimstad
OREGON
MAY 4, 1956
WILLIAM A. EIMSTAD
377

SURVEY FOR INTERNATIONAL PAPER COMPANY
SECTION 26 T19S, R9W, WM.
EIMSTAD & ASSOCIATES
1717 WASHINGTON ST. EUGENE, OR.
MAY 1978
SCALE
1 INCH = 600 FEET

COUNTY SURVEYORS FILE DATA
DO NOT REMOVE FROM OFFICE

MAP FILE M72-15

TO DOUGLAS COUNTY