COUNTY SURVEYORS FILE DATA
DO NOT REMOVE FROM OFFICE

FILED
RECEIVED
JUL 20 1978
COUNTY SURVEYOR
DOUGLAS COUNTY, ORE.
TB

BOUNDARY SURVEY
FOR
FLORENCE COGGSWELL

LOCATED IN E.½, SEC. 30, T. 23 S.
R. 5 W., WILLAMETTE MERIDIAN
DOUGLAS COUNTY, OREGON

JULY, 1978 SCALE: 1" = 200'

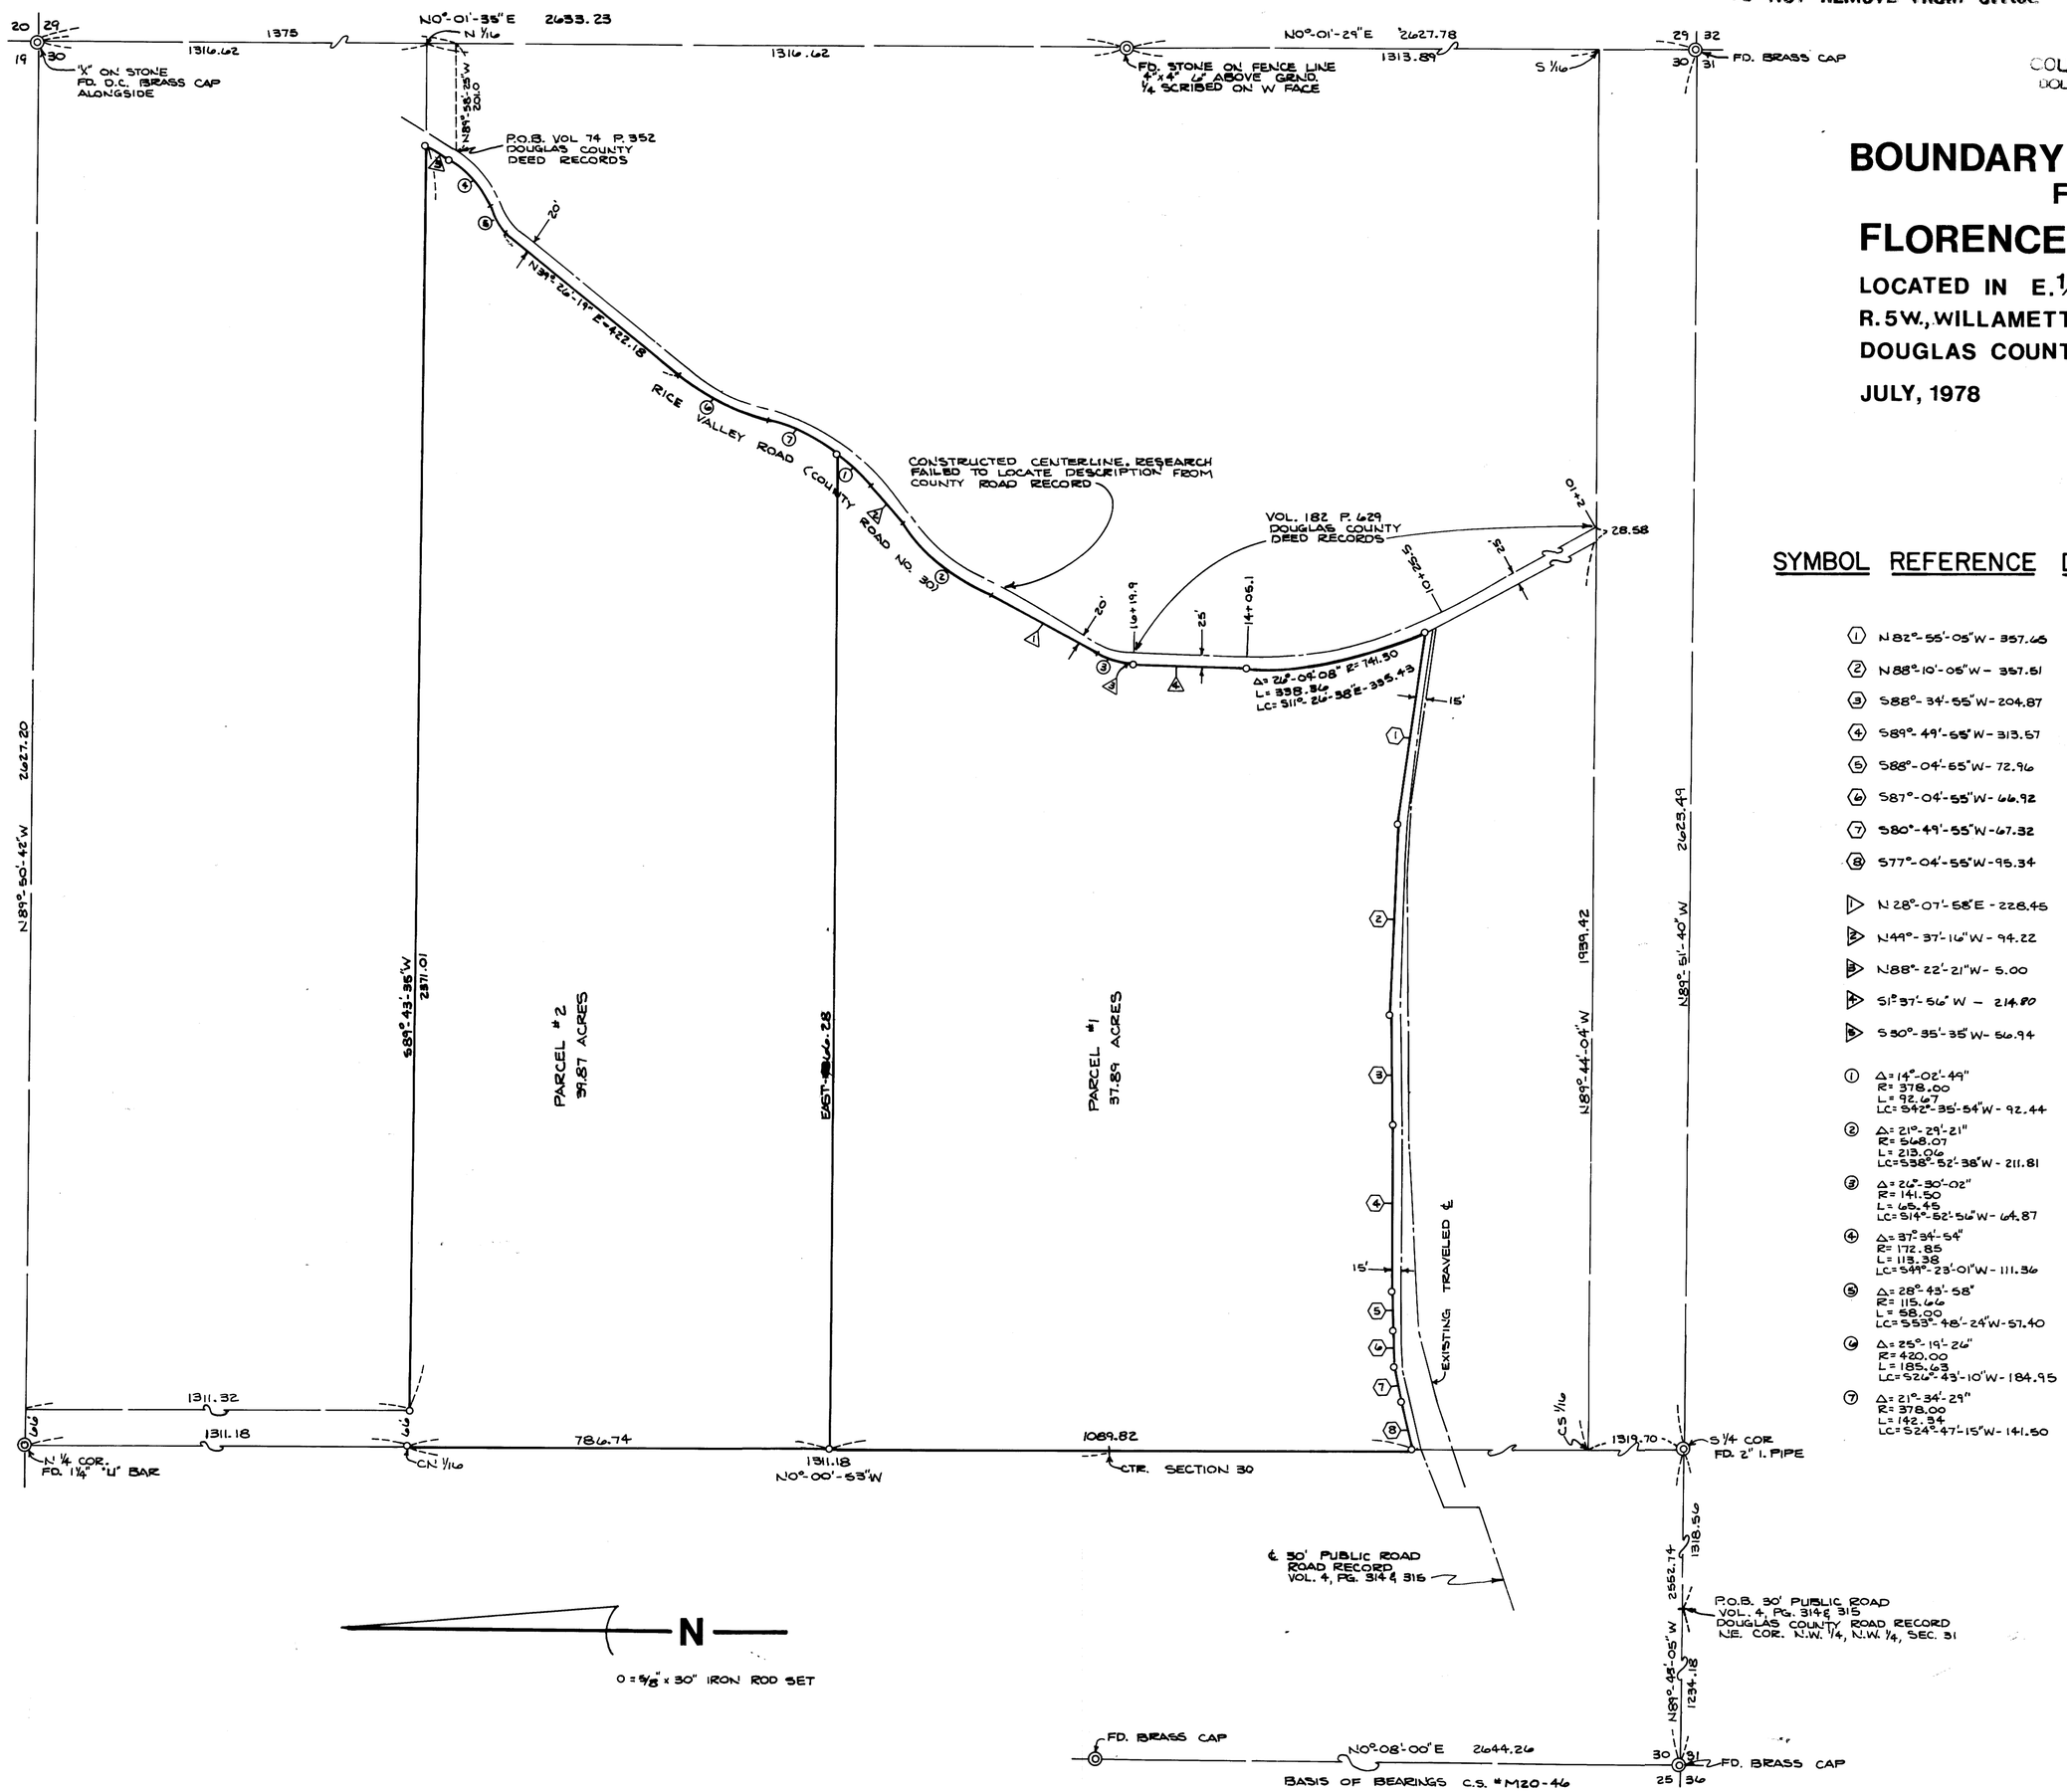

SYMBOL REFERENCE DATA

1. N 82°-55'-05"W - 357.65
2. N 88°-10'-05"W - 357.51
3. S 88°-34'-55"W - 204.87
4. S 89°-49'-55"W - 313.57
5. S 88°-04'-55"W - 72.96
6. S 87°-04'-55"W - 66.92
7. S 80°-49'-55"W - 67.32
8. S 77°-04'-55"W - 95.34

▷ N 28°-07'-58"E - 228.45
▷ N 49°-37'-16"W - 94.22
▷ N 88°-22'-21"W - 5.00
▷ S 1°-37'-56"W - 214.80
▷ S 50°-35'-35"W - 56.94

1. Δ= 14°-02'-49"
R= 378.00
L= 92.67
LC= S42°-35'-54"W - 92.44
2. Δ= 21°-29'-21"
R= 568.07
L= 213.06
LC= S38°-52'-38"W - 211.81
3. Δ= 26°-30'-02"
R= 141.50
L= 65.45
LC= S14°-52'-56"W - 64.87
4. Δ= 37°-34'-54"
R= 172.85
L= 113.38
LC= S49°-23'-01"W - 111.36
5. Δ= 28°-43'-58"
R= 115.66
L= 58.00
LC= S53°-48'-24"W - 57.40
6. Δ= 25°-19'-26"
R= 420.00
L= 185.63
LC= S26°-43'-10"W - 184.95
7. Δ= 21°-34'-29"
R= 378.00
L= 142.34
LC= S24°-47'-15"W - 141.50

REGISTERED
PROFESSIONAL
LAND SURVEYOR
Douglas C. Rossmann
OREGON
OCTOBER 26, 1977
DOUGLAS C. ROSSMANN
1472

MAP # M22-17