COUNTY SURVEYORS FILE DATA
DO NOT REMOVE FROM OFFICE

U.S. FOREST SERVICE

Section 9, T. 30 S., R. 1 W., W.M.

Douglas County, Oregon

June 16, 1978

INCHES 0 1 2
FEET 0 500 1000
SCALE

20° MAGNETIC NORTH
Based on Solar Observation

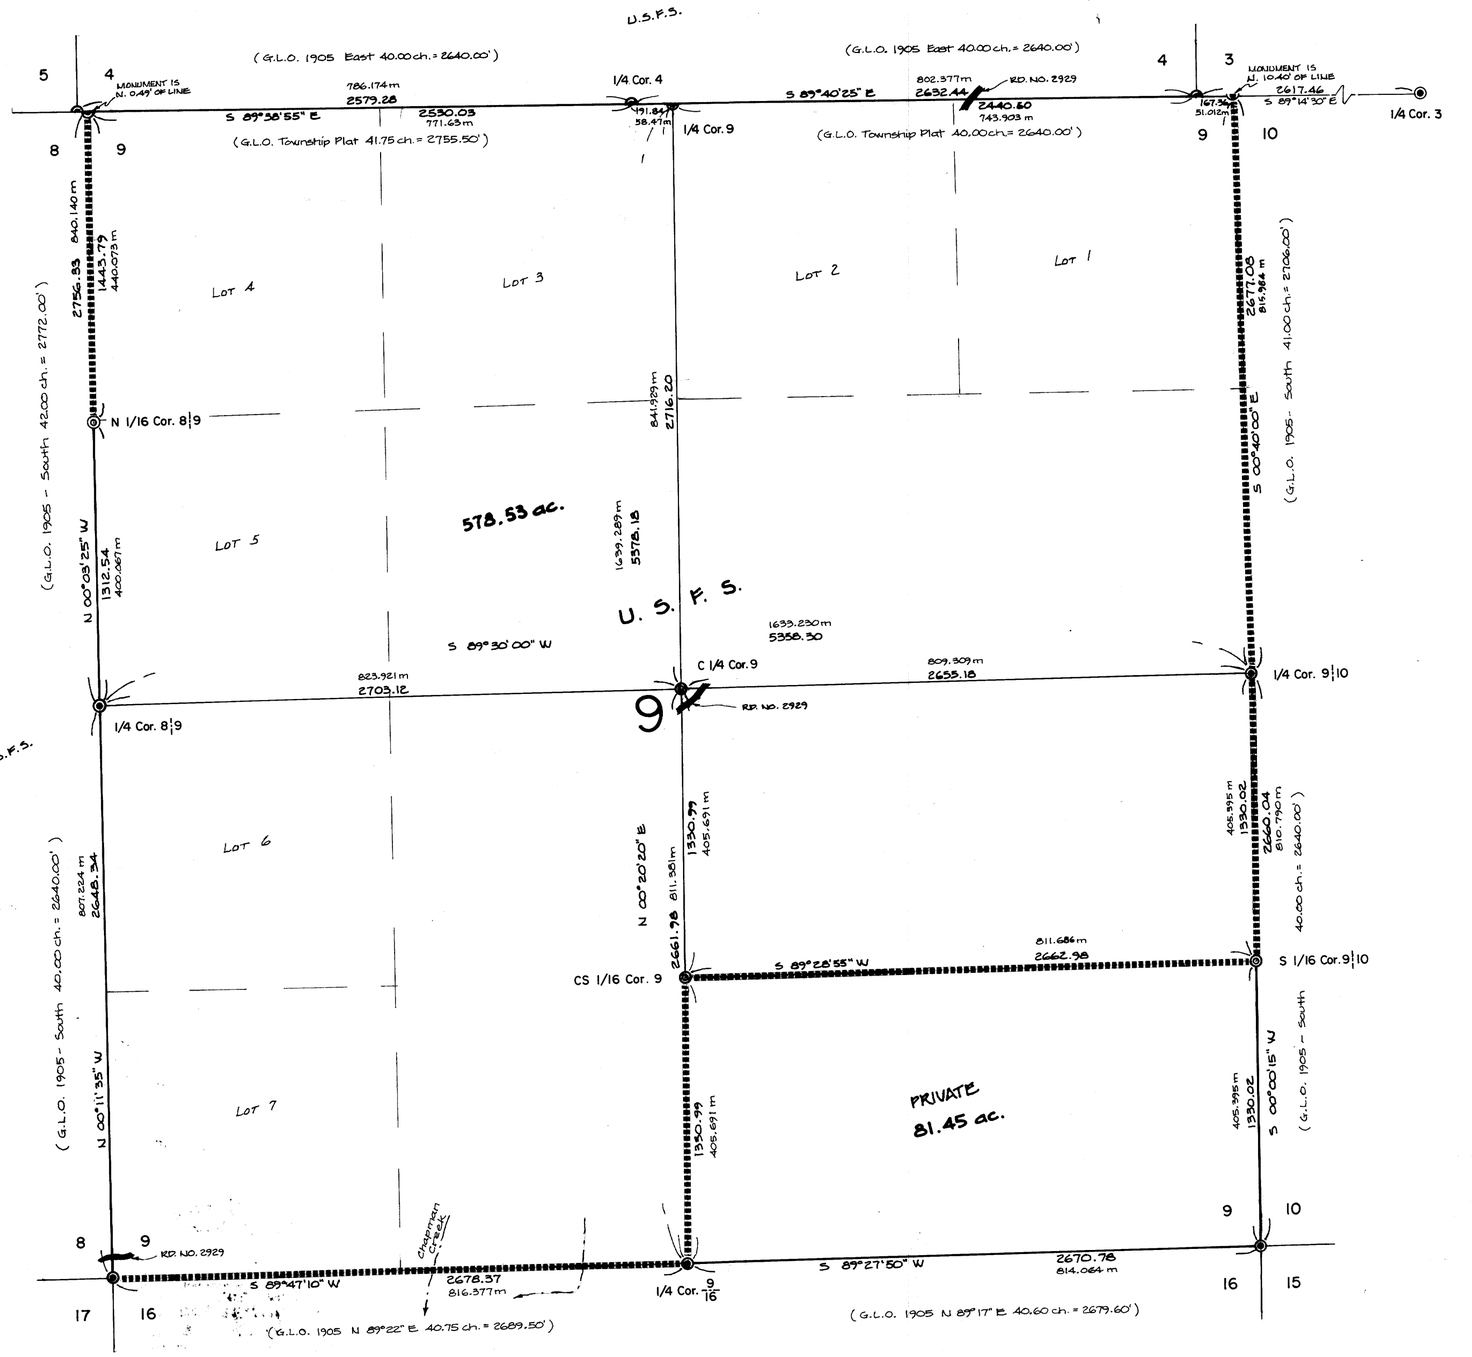

I, DAVID K. BATEMAN, A REGISTERED LAND SURVEYOR IN THE STATE OF OREGON, HEREBY CERTIFY THAT THIS PLAT AND NOTES HEREON, OR ATTACHED, ARE A CORRECT REPRESENTATION OF A SURVEY I PERFORMED DURING MAY - JUNE, 1978 FOR THE U.S. FOREST SERVICE, IN ACCORDANCE WITH THE STATUTES OF THE STATE OF OREGON AND WITH THE ARTICLES OF MY CONTRACT.

David K. Bateman
Registered Land Surveyor No. 1068

LEGEND

◎ Set Brasscap

◉ Found Brasscap

Property line marked with 6' metal fence posts and National Forest boundary signs

All Bearing Trees tagged & banded with red paint
Bearing Trees marked during this survey have a brass washer, stamped "PLS 1068", nailed to lower blaze.

PROJECT NAME: Tiller Land Survey No. 27
CONTRACT NO.: 006800 N
FIELD BOOKS: 3, 5, 6, 7, 8, 13

FILED
RECEIVED
JUL 27 1978
COUNTY SURVEYOR
DOUGLAS COUNTY, ORE.

4 | 8 | 9 — Fd. 1968 County Brasscap
8" Yew, S 42° E 8.1', scribing visible
26" Double Yew, S 64° W 41.6', scribing visible
Rotten W. Fir stump, S 11° E 24.1' (original)

5 | 4 | 8 — Fd. 1968 County Brasscap
10" Yew, N 13° W 33.9', scribing visible (original)
26" D. Fir, N 83° E 42.2', healed face (original)

1/4 Cor. 4 only — Fd. 1968 County Brasscap
18" Cedar, S 53° W 4.0', healed face (original)
24" Cedar, N 56° W 31.7', healed face (original)
8" Maple, N 38° W 14.5', scribing visible

1/4 Cor. 9 only — Set 2½" x 30" Galvinized Iron Pipe with Brasscap
Marked: 10" Hemlock, S 67½° W 21.1', "¼ S9 BT"
10" Hemlock, S 46° E 16.7', "¼ S9 BT"

4 | 5 | 9 — Fd. 1977 County Brasscap
18" D. Fir stump, N 41° E 43.0', scribing visible (original)
6" W. Fir, N 64° E 12.9', scribing visible
6" W. Fir, N 67° W 25.0', scribing visible

3 | 9 | 10 — Fd. 1969 County Brasscap
12" D. Fir (down), S 41° W 36.3', scribing visible (original)
13" Cedar, S 67° W 49.5', scribing visible
19" D. Fir stump, S 62° E 38.3', scribing visible
10" Yew, S 18° E 95.1, scribing visible

1/4 Cor. 9|10 — Fd. 1968 County Brasscap
30" D. Fir, N 43° W 14.1', scribing visible
42" D. Fir snag, West 13.2' (original)
28" D. Fir stump, S 76° E 14.9', healed face (original)
Marked: 12" D. Fir, N 32° W 44.7', "¼ S9 BT"

S 1/16 Cor. 9|10 — Set 2½" x 30" Galvinized Iron Pipe with Brasscap
Marked: 23" D. Fir, S 46½° W 19.2', "S 1/16 S9 BT"
36" D. Fir, N 89° E 7.4', "S 1/16 S10 BT"

9 | 10 | 16 | 15 — Fd. 1968 County Brasscap
42" P. Pine, S 40° E 33.7', scribing visible (original)
19" Fir, N 89½° E 38.9', has face (original)
13" P. Pine, S 59° W. 25.6', scribing visible
13" S. Pine, N 59° W 36.4, scribing visible

1/4 Cor. 9|16 — Fd. 1968 County Brasscap
40" B. Oak, S 22° W 54.1', rotted face (original)
29" W. Oak, N 57° W 10.2', scribing visible (original)
10" D. Fir, S 38° W 30.0', healed face

8 | 9 | 17 | 16 — Fd. 1968 County Brasscap
24" Pine snag, S 82° W 9.2' (original)
31" Pine stump, N 54° W 102.3', scribing visible (original)
15" D. Fir, N 40½° W 29.2', healed face
10" D. Fir, N 35° E 19.5', healed face
9" D. Fir, S 38° E 15.4', healed face
14" D. Fir, S 14° W 29.2', healed face

1/4 Cor. 8|9 — Fd. 1968 County Brasscap
22" Yew stump, N 52° E 51.6'
10" Hemlock (down), N 74° W 34.6', scribing visible
12" Maple, S 52° W 24.4', rotten (original)
Marked: 12" Yew, N 57° E 104.0', "¼ S9 BT"
30" Incense Cedar, N 8° W 148.3', "¼ S8 BT"

N 1/16 Cor. 8|9 — Set 2½" x 30" Galvinized Iron Pipe with Brasscap
Marked: 19" D. Fir, N 25° W 49.7', "N 1/16 S8 BT"
50" S. Pine, N 58° E 36.0', "N 1/16 S9 BT"

C 1/4 Cor. 9 — Set 2½" x 30" Galvinized Iron Pipe with Brasscap
Marked: 10" W. Oak, ~~S 67° W 55.2',~~ "C ¼ S9 BT" S. 23° W 32.9
19" P. Pine ~~, N 68½° W 94.4',~~ "C ¼ S9 BT" S. 54° W 57.8

CS 1/16 Cor. 9 — Set 2½" x 30" Galvinized Iron Pipe with Brasscap
Marked: 13" Incense Cedar, N 35½° E 7.7', "CS 1/16 S9 BT"
23" P. Pine, S 04° W 8.0', "CS 1/16 S9 BT"

CORRECTIONS MADE 9/15/78 PER SURVEYOR'S INSTRUCTIONS, D.K.B.

REGISTERED PROFESSIONAL LAND SURVEYOR
David K. Bateman
OREGON
JULY 30, 1976
DAVID K. BATEMAN
1068

TIMBERLAND SERVICES, INC.
1010 Airport Road P. O. Box 868
Albany, Oregon 97321
Telephone (503) 928-9404
LAND SURVEYING ENGINEERING
LAND USE PLANNING - ROADS
FORESTRY CONSULTING

MAP FILE 22-235

MAP FILE 22-235