MAP FILE M 72 - 32

COUNTY SURVEYORS FILE DATA
DO NOT REMOVE FROM OFFICE

SURVEY IN SECTIONS 16, 17, 20, & 21
TOWNSHIP 22 SOUTH, RANGE 8 WEST, WILL. MER.

SURVEY FOR GEORGE FENN
SURVEY BY BHW ENG. & SURVEYING
JUNE, 1978

FILED
RECEIVED JHH
JUL 31 1978
COUNTY SURVEYOR
DOUGLAS COUNTY, ORE.
TB

○ — SET 5/8" I. ROD
● — FD. MONUMENT AS NOTED:

SCALE 1" = 200'

REGISTERED
PROFESSIONAL
LAND SURVEYOR
Romanso E. Ware
OREGON
NOV. 16, 1973
ROMANSO E. WARE
1005

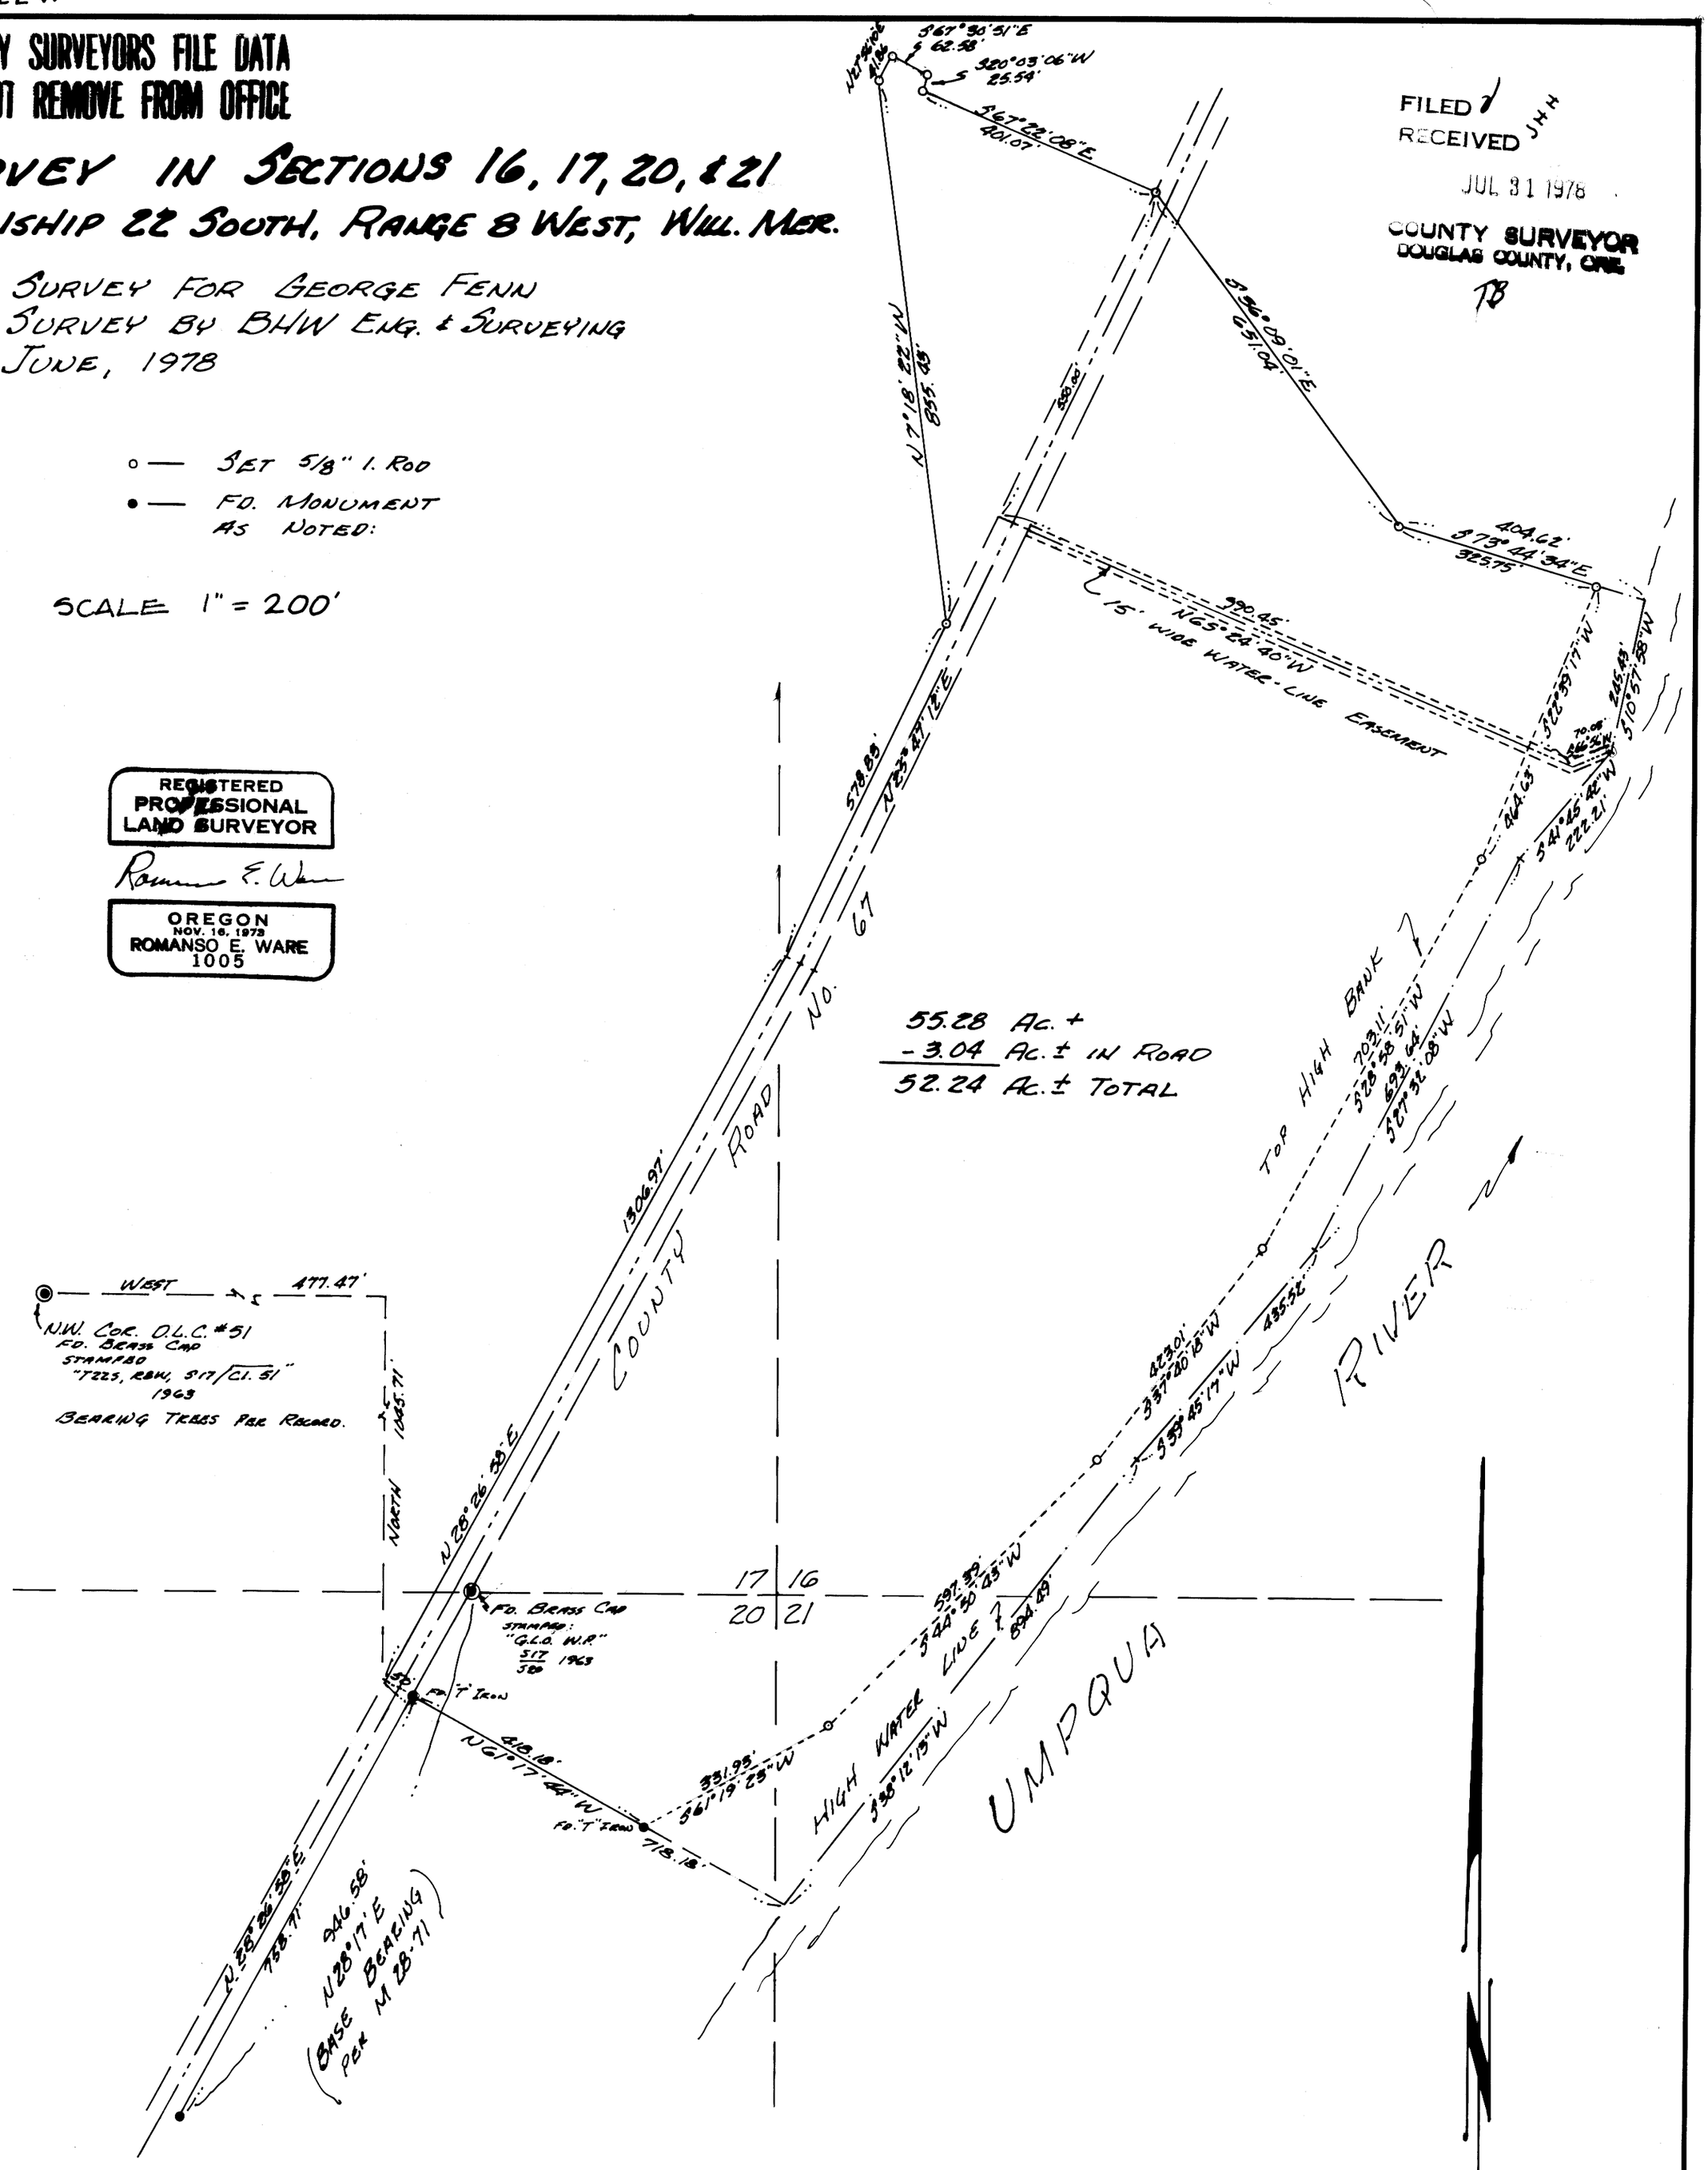

MAP FILE M 72 - 32