COUNTY SURVEYORS FILE DATA
DO NOT REMOVE FROM OFFICE

PROPERTY SURVEY

LOT 4 OF QUIST HEIGHTS
A SUBDIVISON OF BLK. NO. 6
BEULAH ADDITION TO
ROSEBURG, OREGON
SEC. 18, T27S, R5W, WM.
FOR VANCE FABER
BY ALPHA AND OMEGA ENGINEERS
JUNE 1978

FILED
RECEIVED JHH
AUG 7 1978
COUNTY SURVEYOR
DOUGLAS COUNTY, ORE.
TB

MAP FILE M72-41

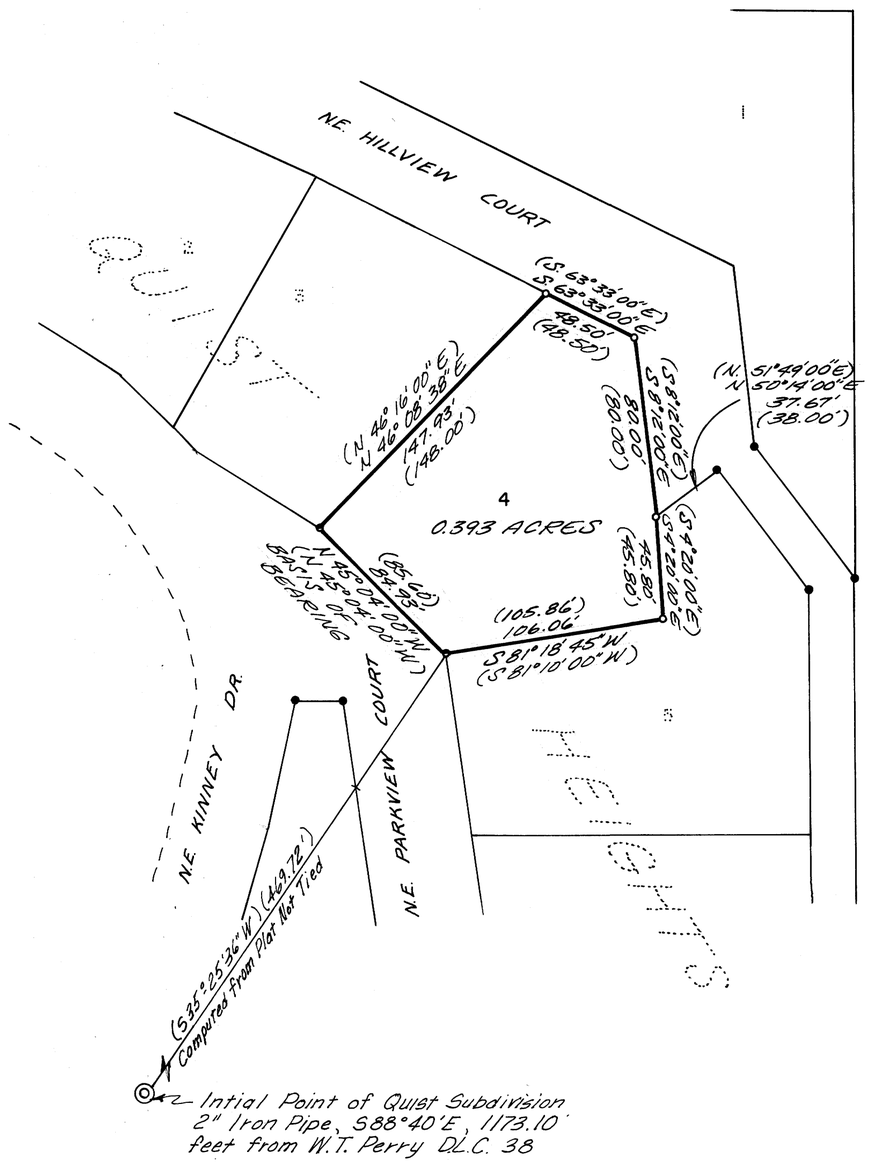

SCALE 1" = 50'

REGISTERED
PROFESSIONAL
LAND SURVEYOR
Russell T. Pinard
OREGON
JULY 16, 1971
RUSSELL T. PINARD
958
7-13-78

LEGEND

- ● FOUND 5/8" REBAR OR AS NOTED.
- ⊖ FOUND & REPLACED WITH 5/8" BY 30" REBAR.
- ○ SET 5/8" X 30" REBAR
- ( ) RECORD DATA
- —— BOUNDRY OF PROPERTY SURVEYED

MAP FILE M72-41