COUNTY SURVEYORS FILE DATA
DO NOT REMOVE FROM OFFICE

# PROPERTY LINE SURVEY IN SEC. 12, T30S, R6W. W.M.

SURVEYED FOR - HERBERT LBR. CO.
SURVEYED BY - W. S. BARNES

AUG. 1978
SCALE 1" = 200'

FILED
RECEIVED
AUG 18 1978
COUNTY SURVEYOR
DOUGLAS COUNTY, ORE.
TB

MAP FILE M-72-62

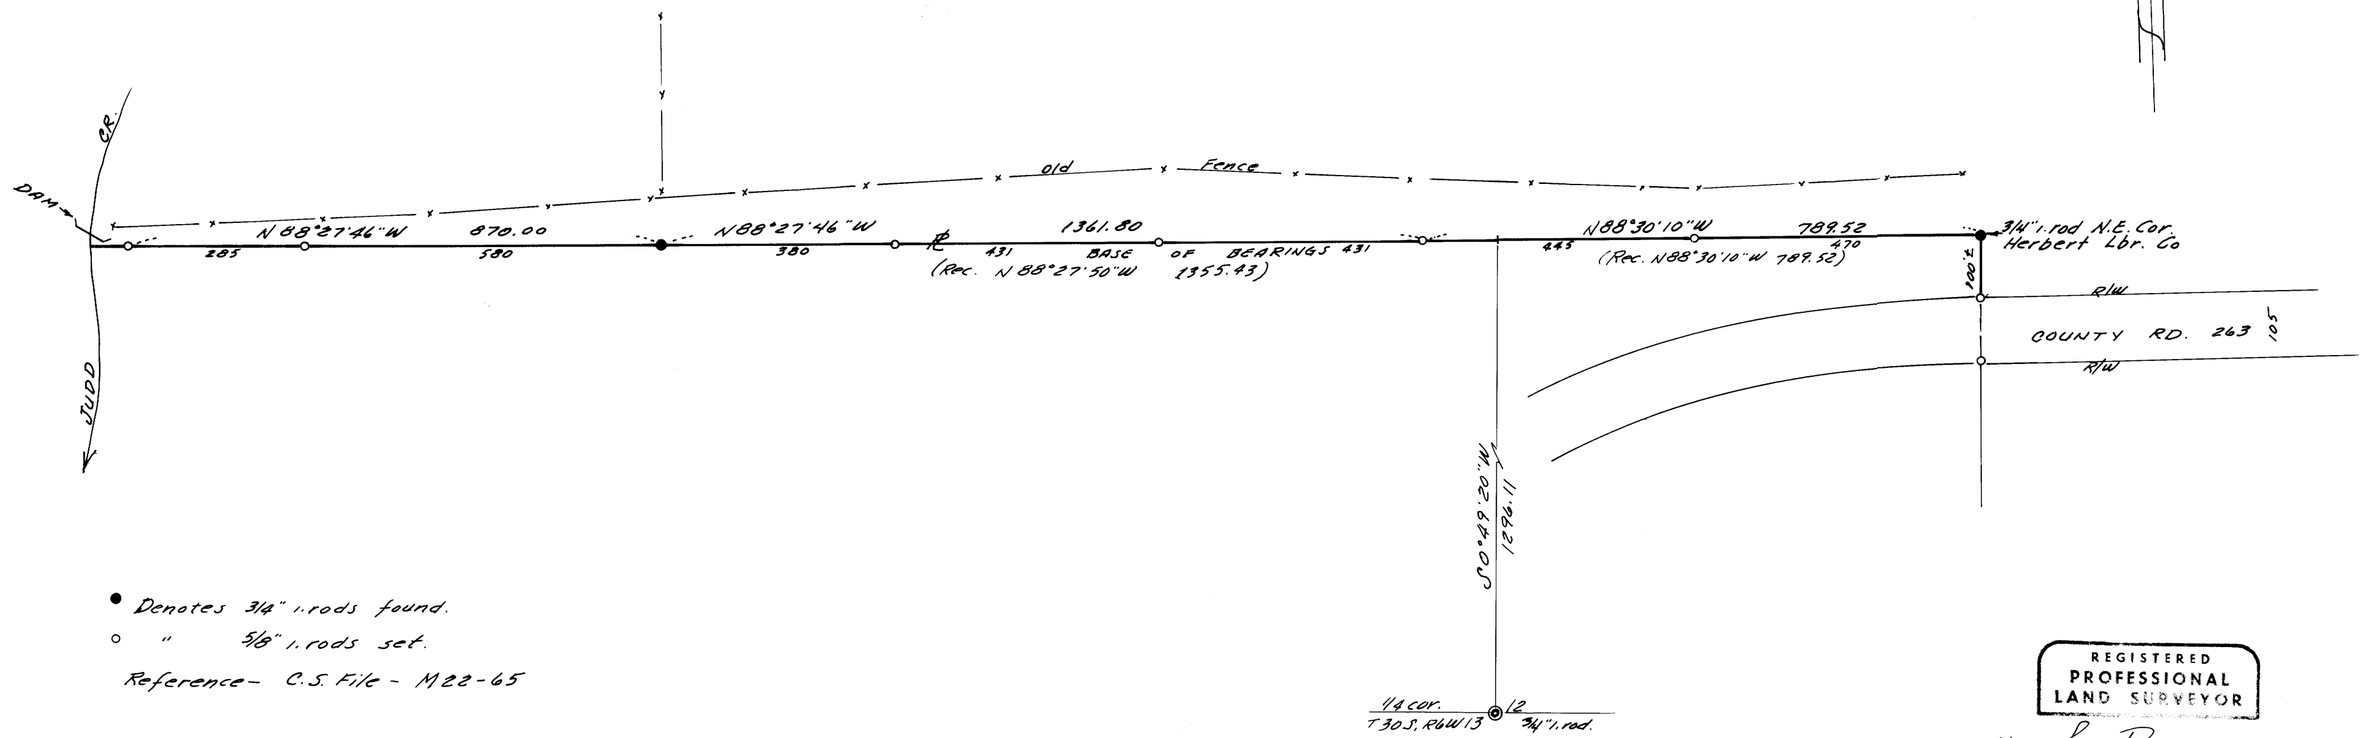


● Denotes 3/4" i.rods found.
○ " 5/8" i.rods set.

Reference - C.S. File - M22-65

REGISTERED
PROFESSIONAL
LAND SURVEYOR

W. S. Barnes

OREGON
SEPT. 29, 1977
WILLIAM S. BARNES
1931

MAP FILE M-72-62