MAP FILE M73-26

SURVEY FOR DESCRIPTION FOR MORTGAGE PURPOSES—SECTION 23 T27S R5W WM

FOR: CRAIG Mc LAUGHLIN
BY: BAUGHMAN SURVEYING SERVICES INC.

COUNTY SURVEYORS FILE DATA
DO NOT REMOVE FROM OFFICE

SEPTEMBER 1978 — SCALE: 1" = 50'

FILED
RECEIVED
SEP 15 1978
COUNTY SURVEYOR
DOUGLAS COUNTY, ORE.
TH

REGISTERED PROFESSIONAL LAND SURVEYOR
OREGON
JULY 12, 1967
GLENN S. BAUGHMAN
536

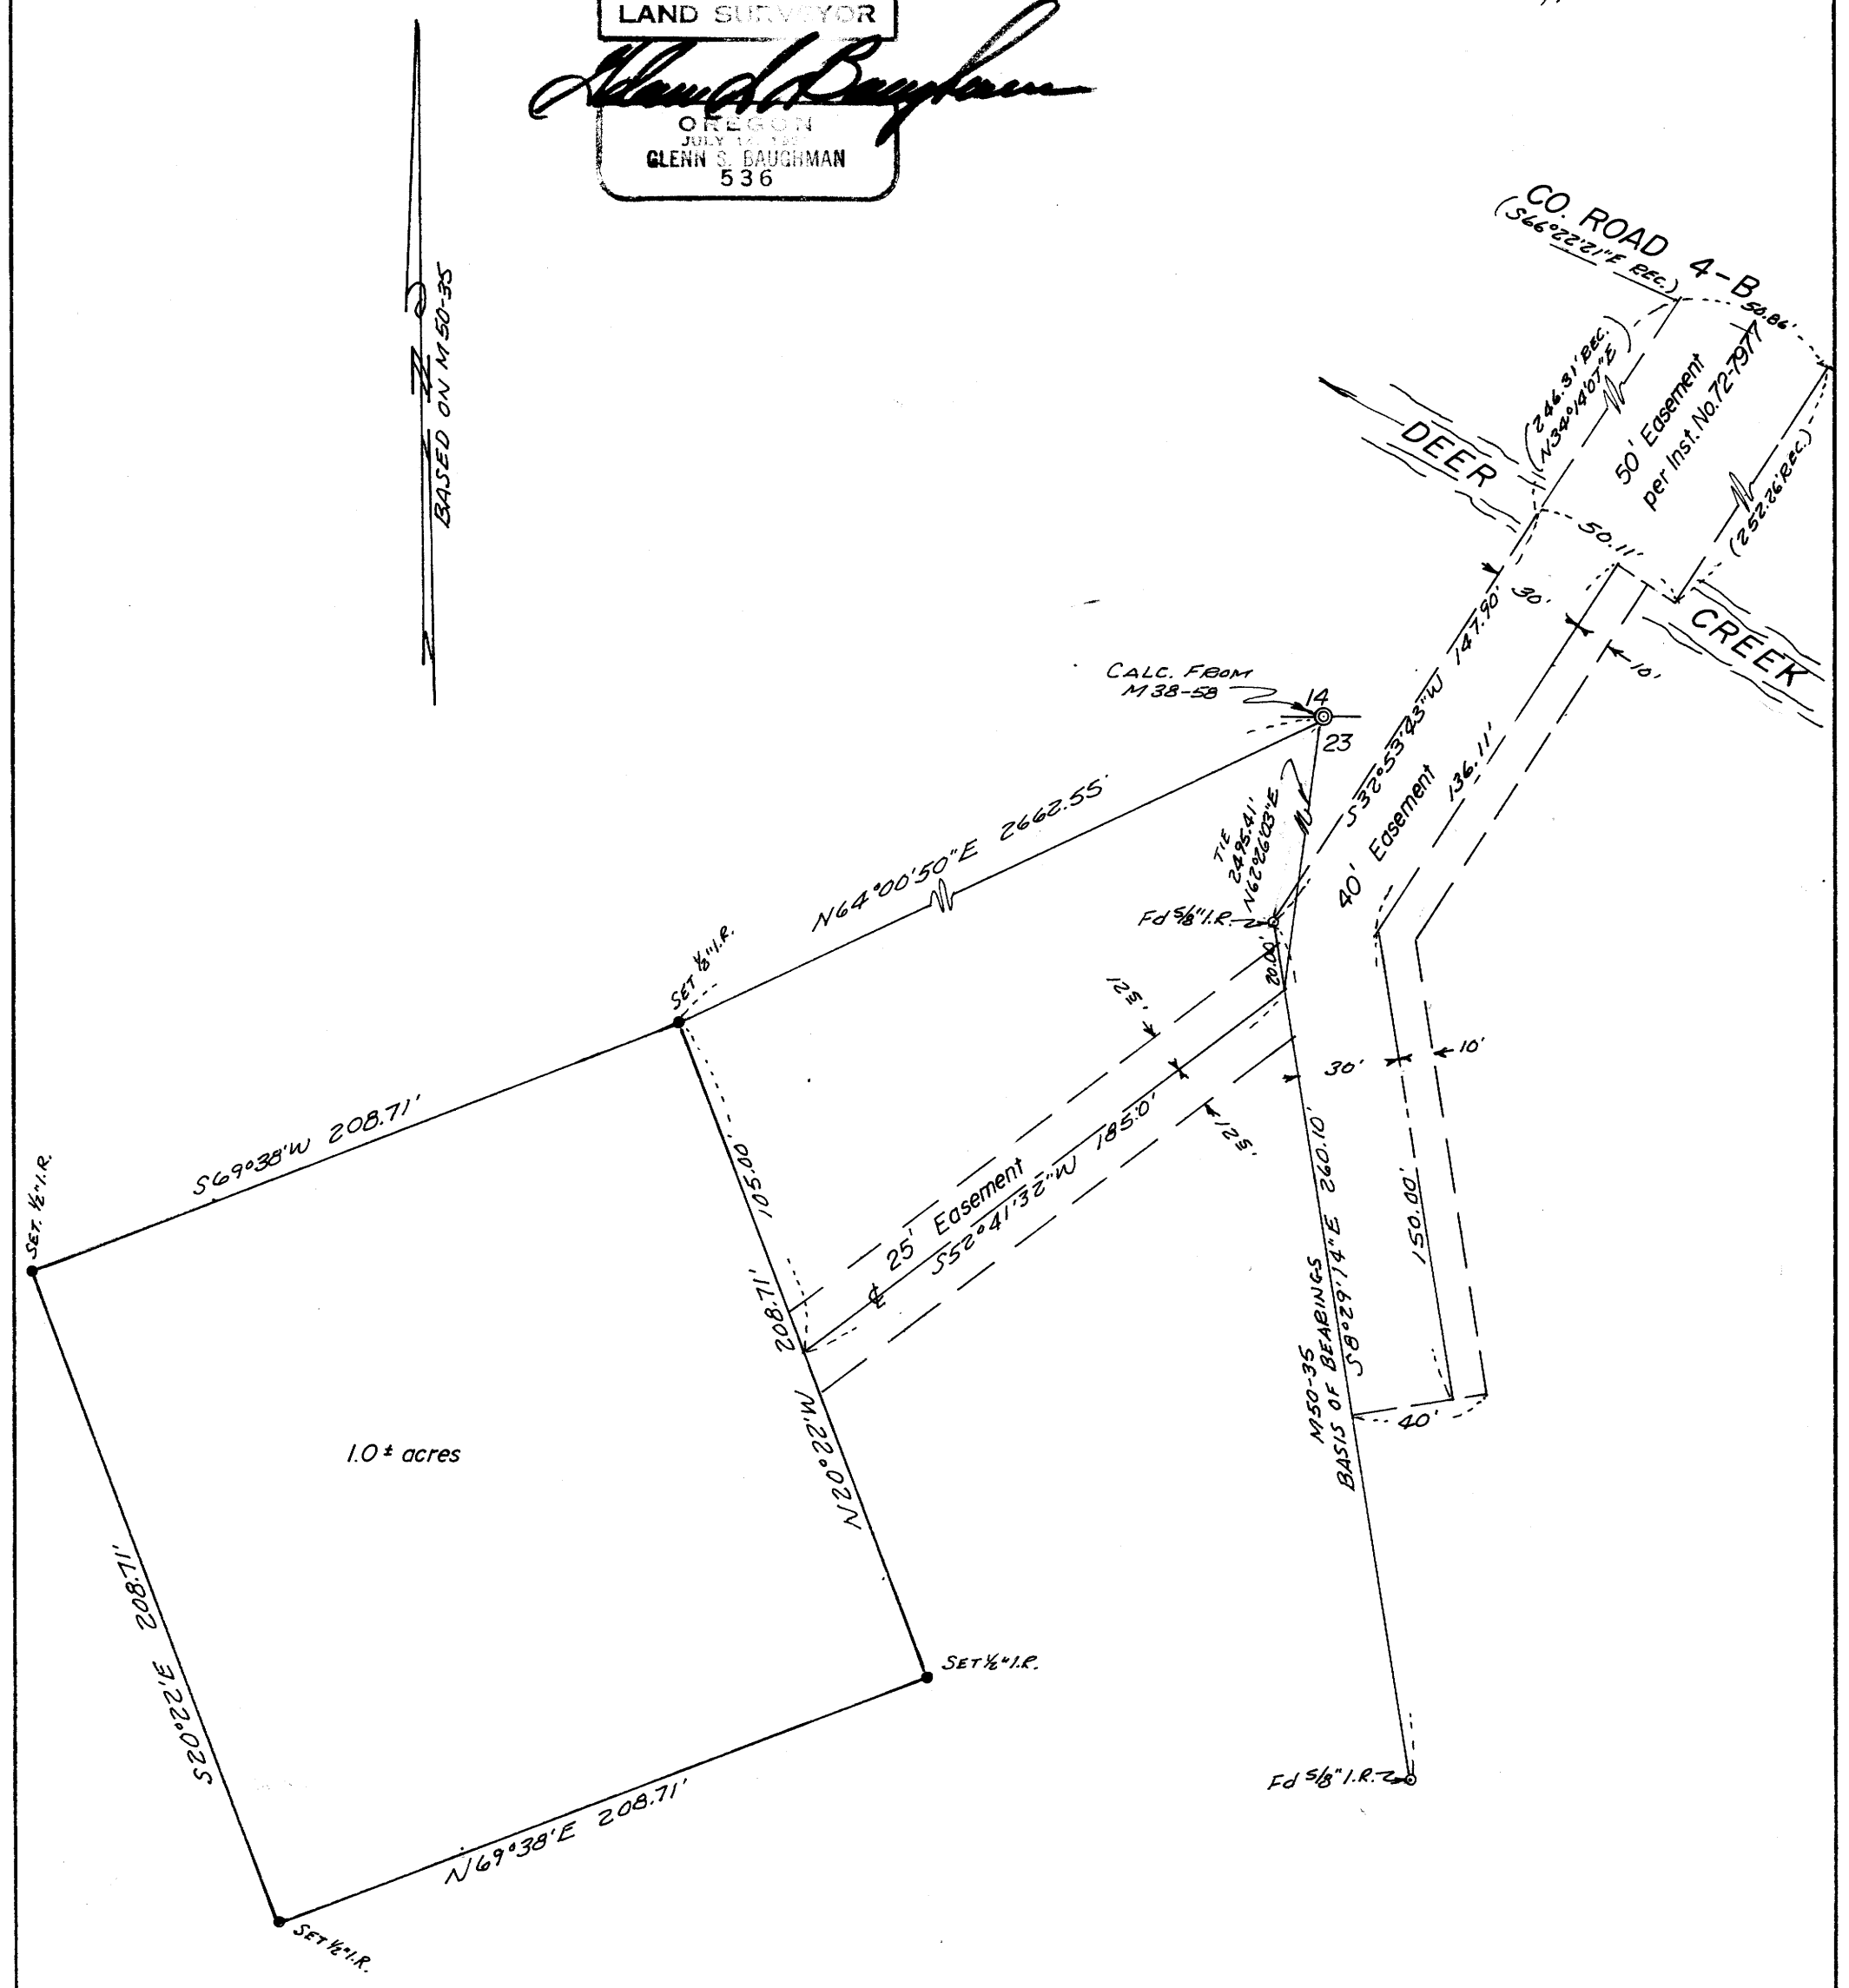

FM 4-807

MAP FILE M73-26