COUNTY SURVEYORS FILE DATA
DO NOT REMOVE FROM OFFICE

SURVEY TO SET LOT CORNERS IN FIR GROVE SUBDIVISION, SEC. 19, T25S, R5W. W.M.

SURVEYED FOR - LEO PRATT
SURVEYED BY - W. S. BARNES ENGINEERING SERVICE
Sept. 28, 1978

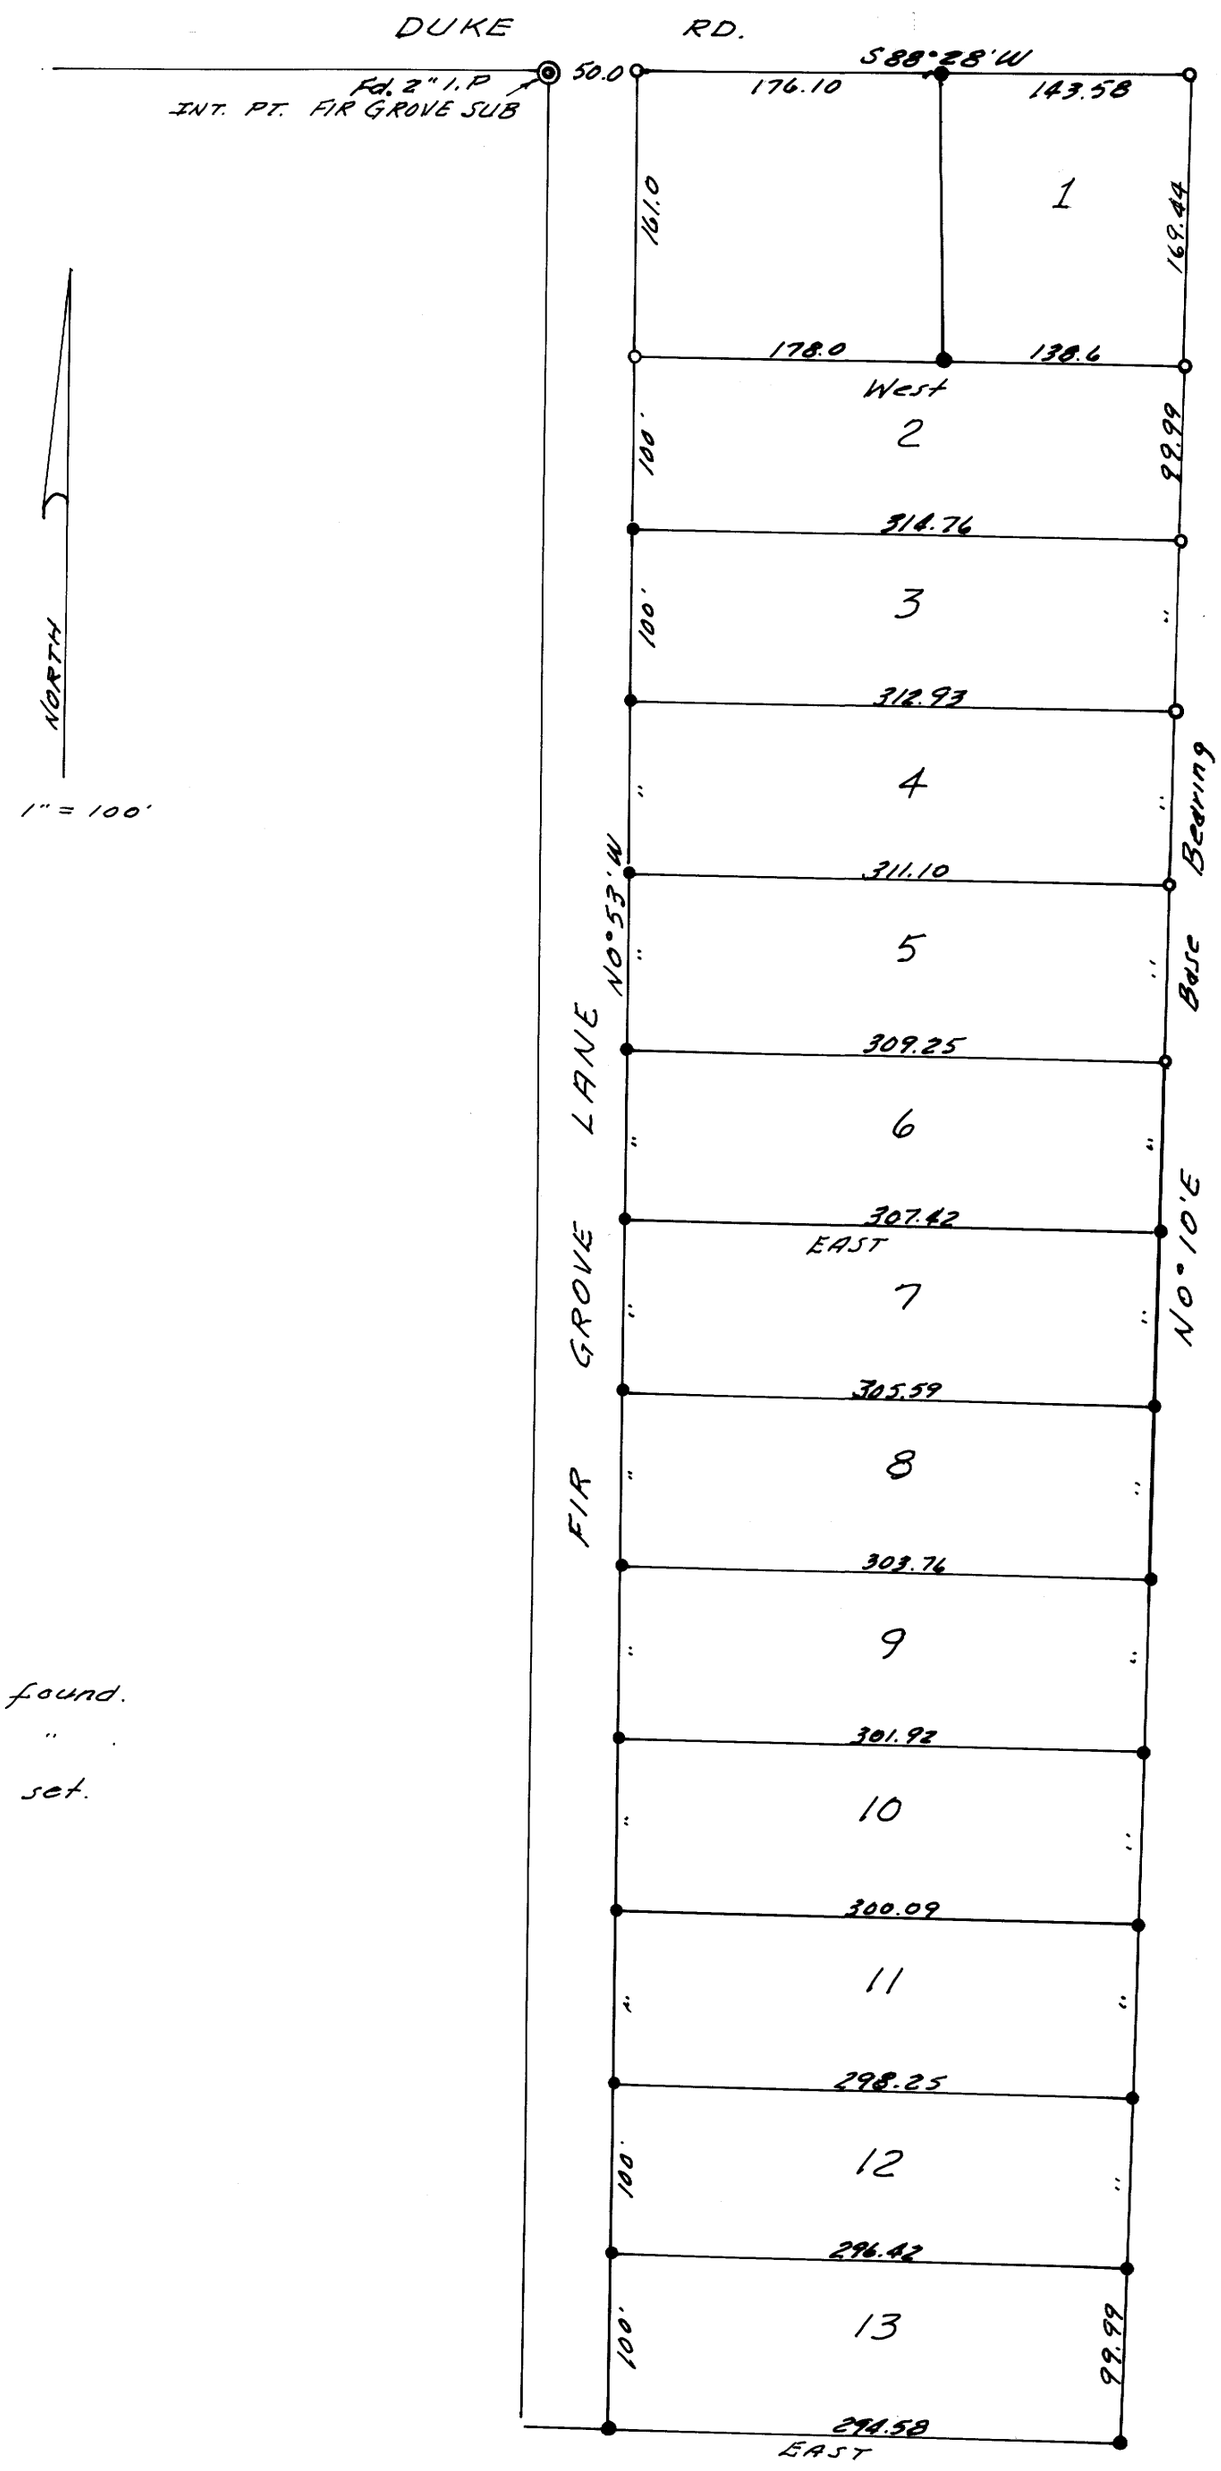

- ● Denotes 1/2" I. rods found.
- ● " 3/4" " " " .
- ○ " 5/8" " " set.

REGISTERED PROFESSIONAL LAND SURVEYOR
W. S. Barnes
OREGON
SEPT. 28, 1978
WILLIAM S. BARNES
1931

FILE M73-35