MAP FILE M 73-57

COUNTY SURVEYORS FILE DATA
DO NOT REMOVE FROM OFFICE

FILED
RECEIVED
OCT 9 1978
COUNTY SURVEYOR
DOUGLAS COUNTY, ORE.

SURVEY IN SECTION 7, T.27S.R.4W.W.M.

FOR: MARVIN DARNELL

BY: BAUGHMAN TECHNICAL SERVICES INC.

SEPTEMBER 1978 – SCALE: 1"=200'

REGISTERED
PROFESSIONAL
LAND SURVEYOR
GLENN A. BAUGHMAN
530

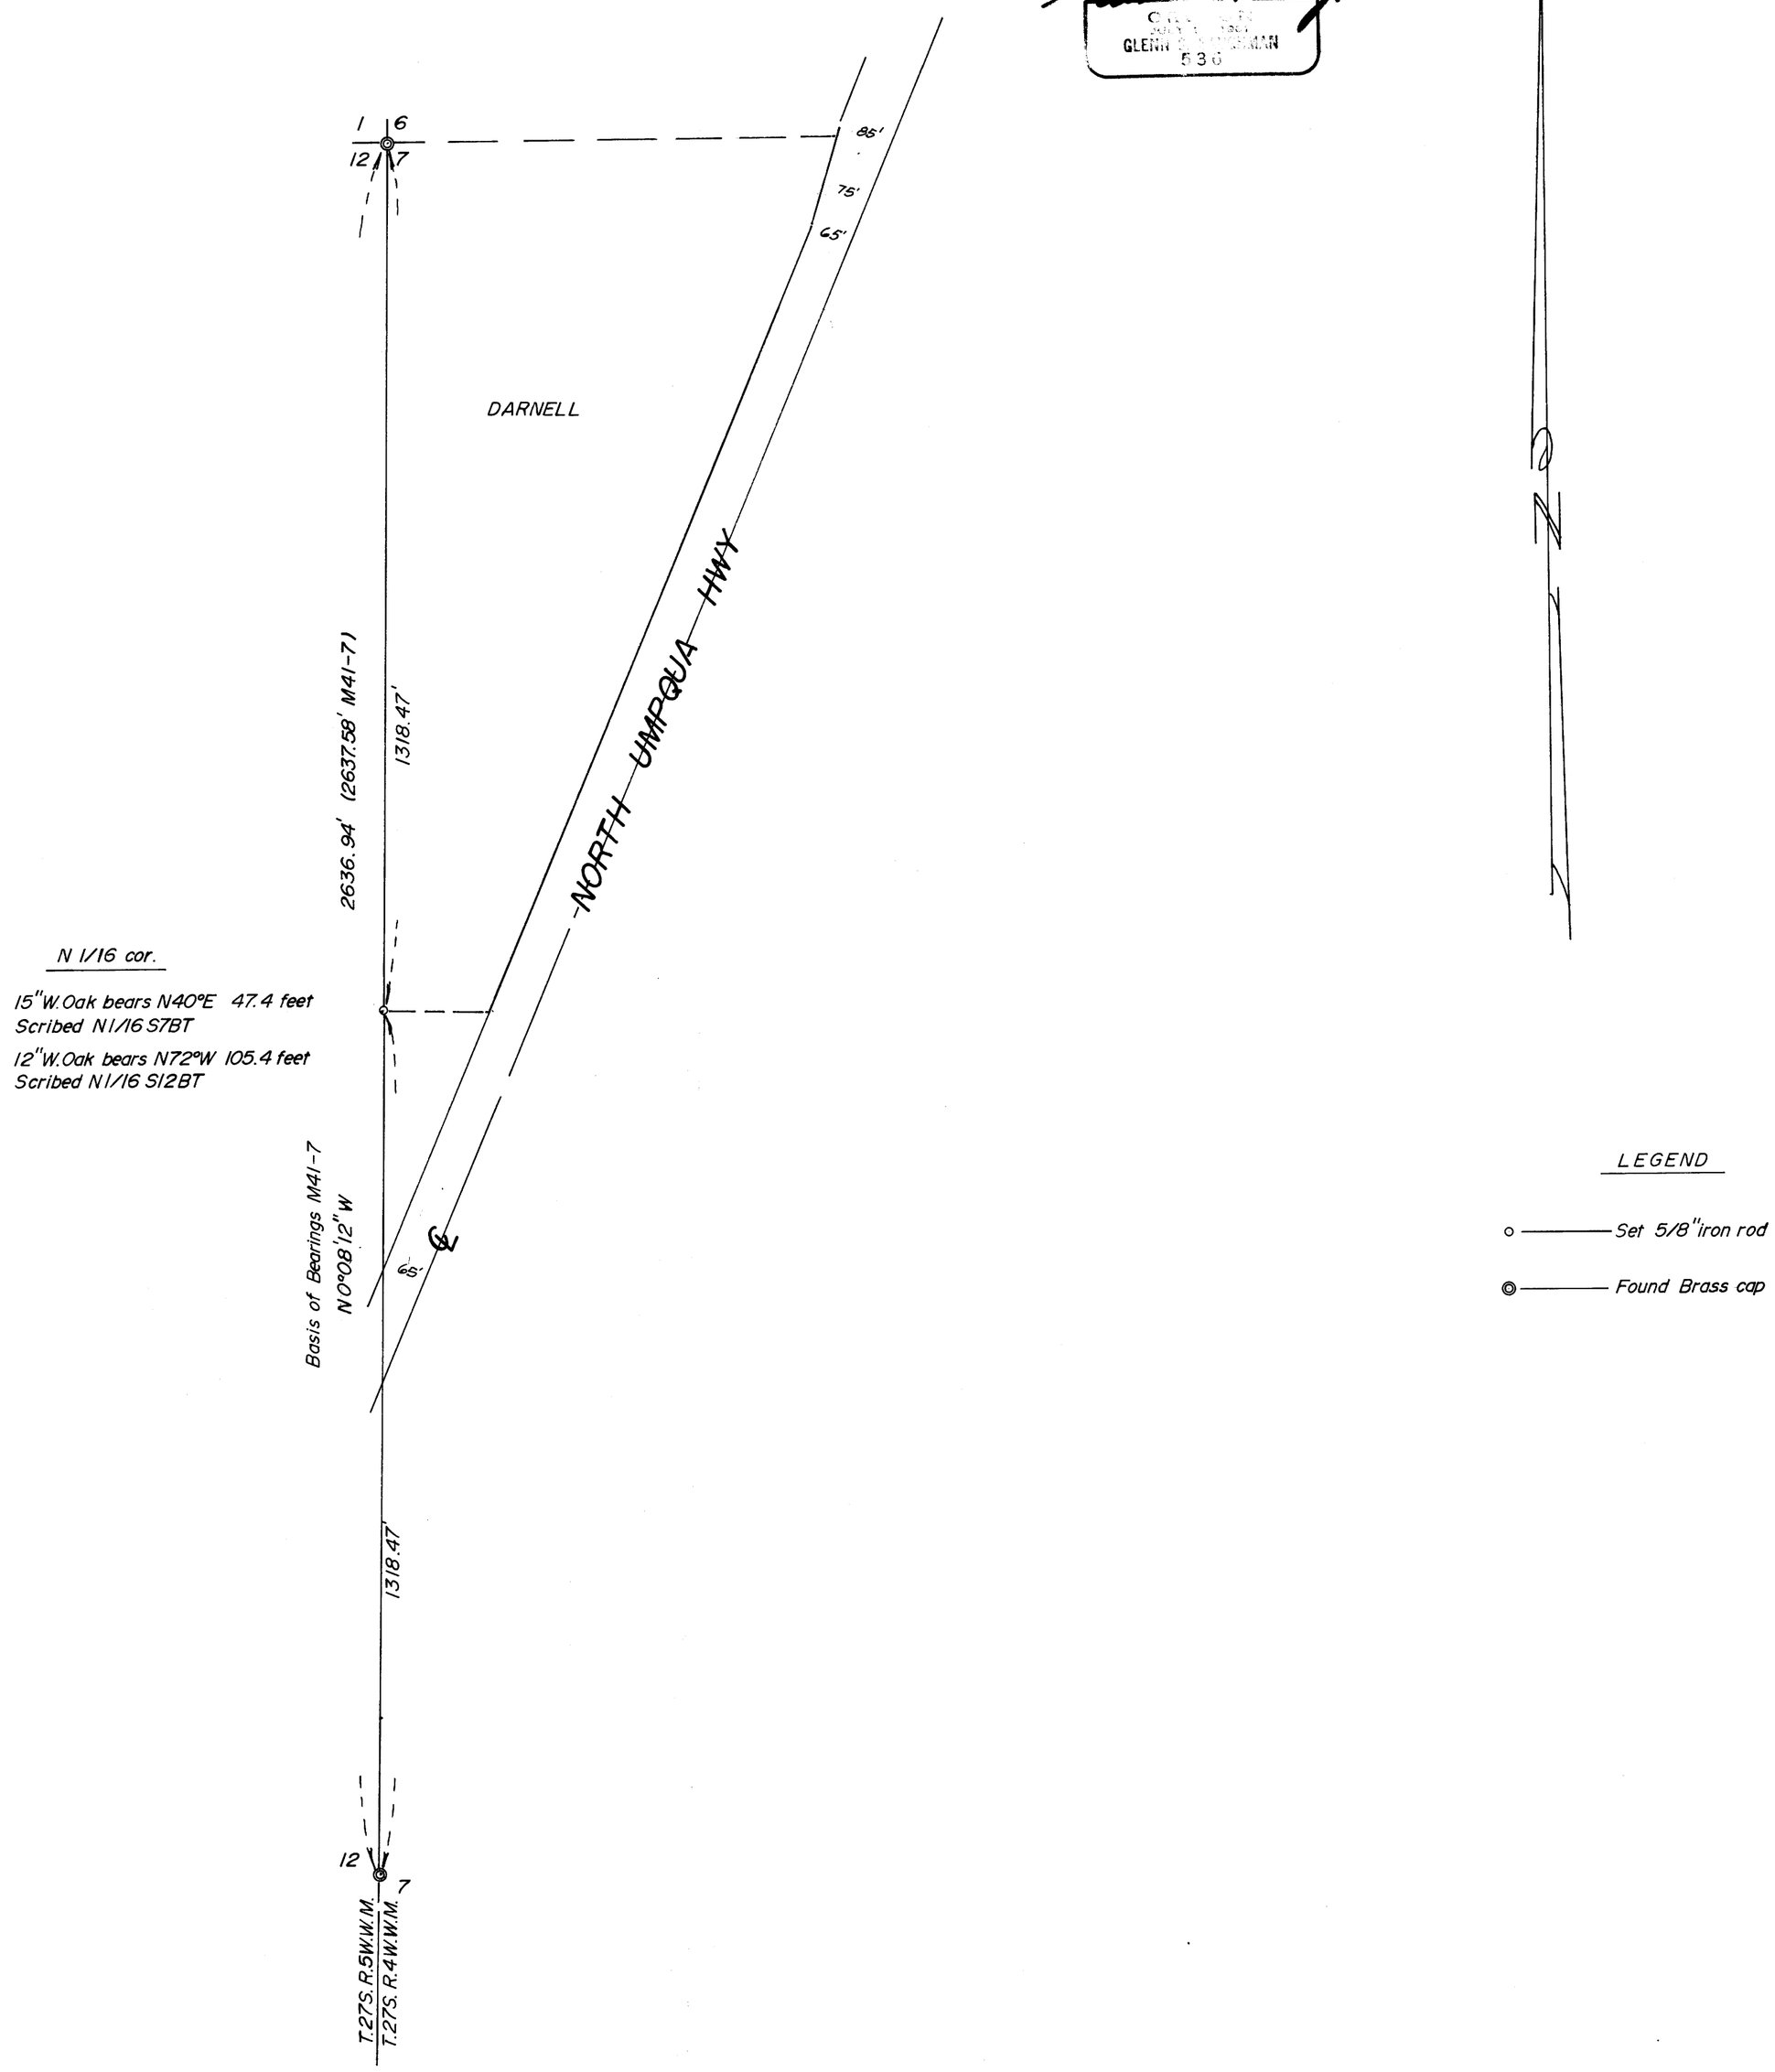

FM 6-60

MAP FILE M 73-57