MAP FILE M 73-58

COUNTY SURVEYORS FILE DATA
DO NOT REMOVE FROM OFFICE

SURVEY TO SET PROPERTY CORNERS

OF LOTS 19,20 & 21, BLOCK 1, BOGARD ADDITION
SECTION 19, T.27S. R.5W.W.M.

FILED
RECEIVED
OCT 9 1978
COUNTY SURVEYOR
DOUGLAS COUNTY, ORE.

FOR: DICK STRITZKE

BY: BAUGHMAN TECHNICAL SERVICES INC.

SEPTEMBER 1978 – SCALE: 1"=40'

REGISTERED
PROFESSIONAL
LAND SURVEYOR
OREGON
JULY 31, 1964
GLENN S. BAUGHMAN
536

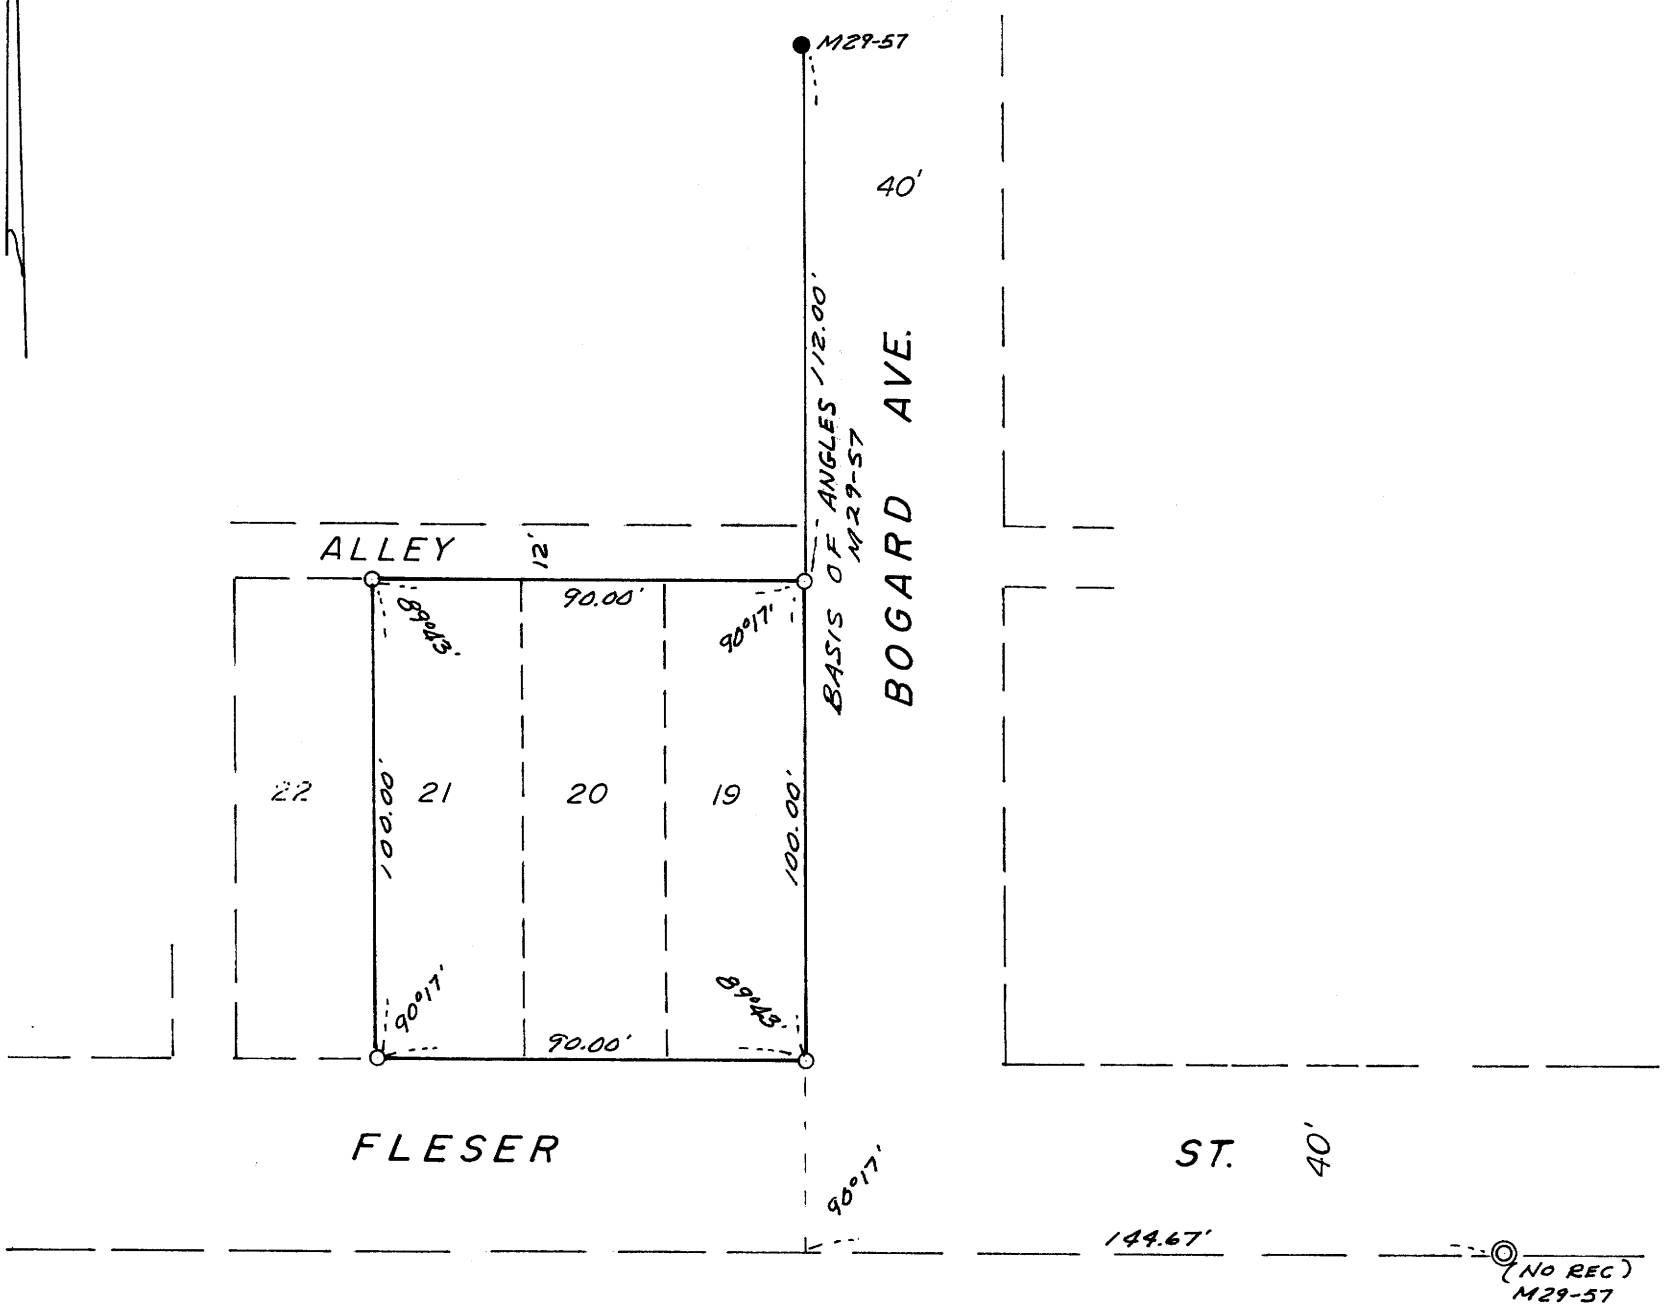

LEGEND

- ○——— Set 1/2" iron rod
- ●——— Found 5/8" iron rod
- ◎——— Found 3/4" iron pipe

FM4-809

MAP FILE M 73-58