MAP FILE M73-59

SURVEY FOR PROPERTY CORNERS

IN SECTION 14 T27S R6W WM – SEPTEMBER 1978

FOR: BETTENCOURT CONSTRUCTION

BY: BAUGHMAN TECHNICAL SERVICES INC.

FILED
RECEIVED
OCT 9 1978
COUNTY SURVEYOR
DOUGLAS COUNTY, ORE.

SCALE: 1" = 40'

COUNTY SURVEYORS FILE DATA
DO NOT REMOVE FROM OFFICE

REGISTERED
PROFESSIONAL
LAND SURVEYOR
OREGON
JULY 16, 1961
GLENN S. BAUGHMAN
536

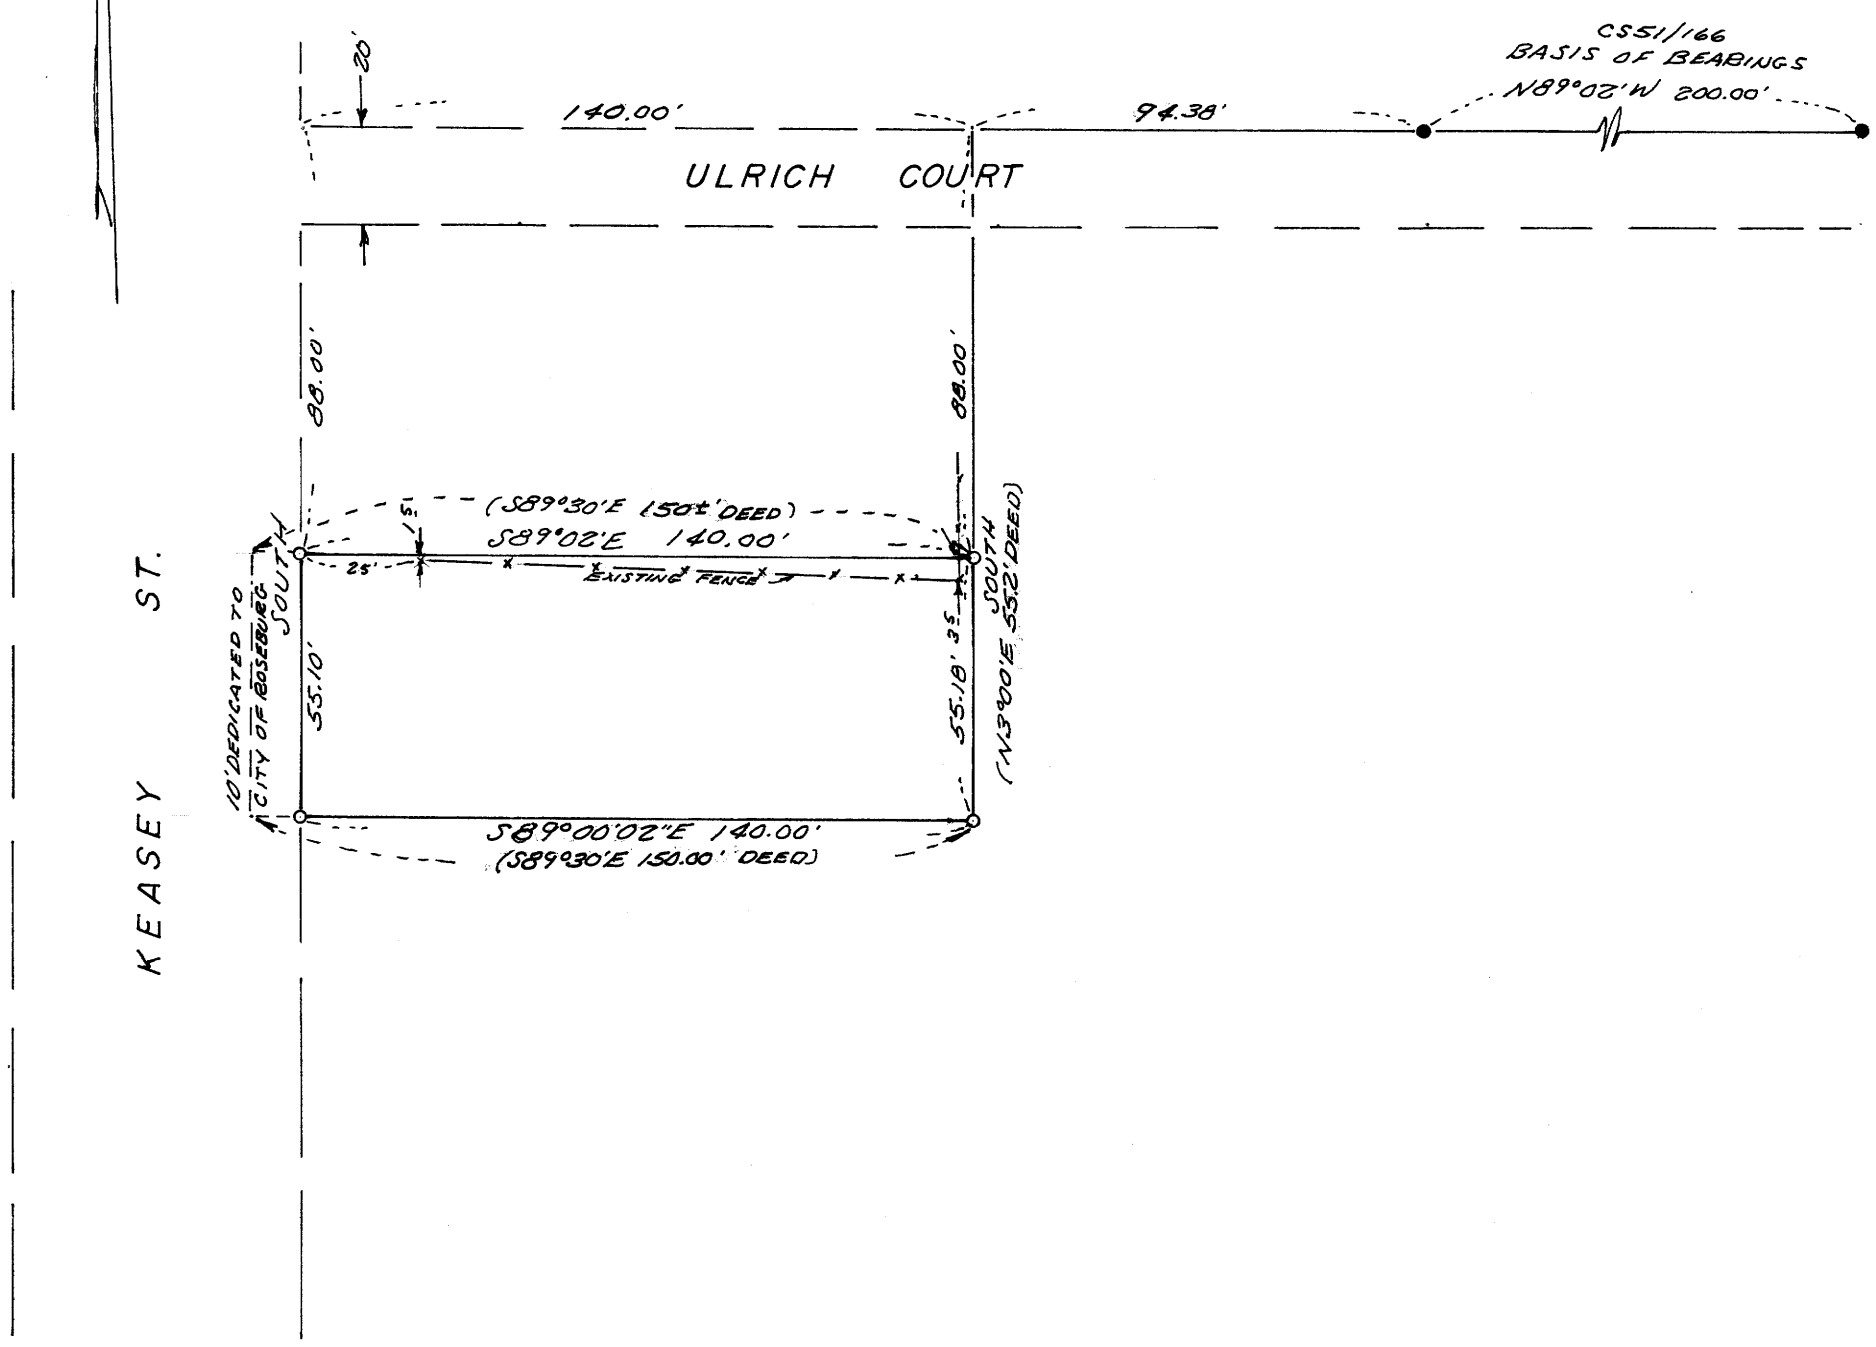

LEGEND

● ——— Found 1/2" iron rod

○ ——— Set 1/2" iron rod

MAP FILE M73-59

FM 4-808