COUNTY SURVEYORS FILE DATA
DO NOT REMOVE FROM OFFICE

FILED
RECEIVED
COUNTY SURVEYOR
TB

SURVEY FOR PROPERTY CORNERS

IN BLOCK C AMENDED PLAT OF FLINTS ADDITION
SECTION 19 T.27S. R.5W.W.M.

FOR: H. H. HOBI
BY: BAUGHMAN TECHNICAL SERVICES INC.

NOVEMBER 1978 — SCALE: 1"=50'

REGISTERED
PROFESSIONAL
LAND SURVEYOR
OREGON
JULY 14, 1961
GLENN S. BAUGHMAN
536

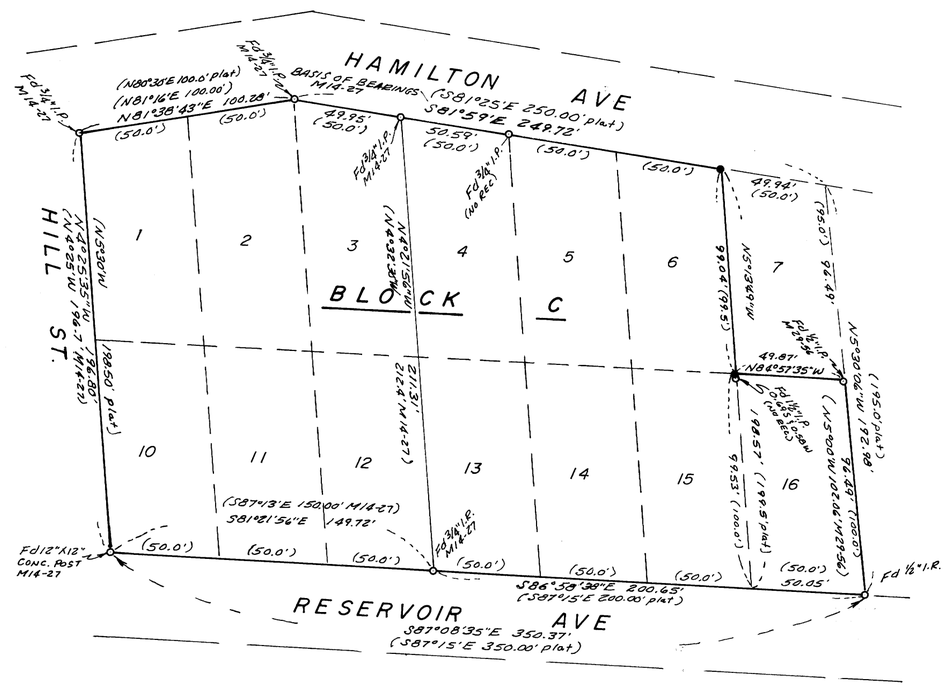
HAMILTON AVE
BASIS OF BEARINGS
(S81°25'E 250.00' plat)
S81°59'E 249.72'
(N80°30'E 100.0' plat)
(N81°16'E 100.00')
N81°38'43"E 100.28'
HILL ST.
BLOCK C
1
2
3
4
5
6
7
10
11
12
13
14
15
16
(S87°13'E 150.00' M14-27)
S81°21'56"E 149.72'
Fd 3/4" I.P. M14-27
Fd 1/2" I.P. (No Rec)
Fd 1/2" I.P. (Plats Rec)
Fd 1/2" I.P. M14-27
Fd 1/2" I.P. M14-27
Fd 1/2" I.P. M14-27
Fd 1/2" I.P. M14-27
