COUNTY SURVEYORS FILE DATA
DO NOT REMOVE FROM OFFICE

FILED
RECEIVED
NOV 29 1978
COUNTY SURVEYOR
DOUGLAS COUNTY, ORE.
TB

SURVEY TO SET ℄ OF STREET MONUMENTS

For R.H.R. JOINT VENTURE
By B.H.W. ENGINEERING & SURVEYING INC.

SURVEY IN FOUR SEASONS SUBDIVISION VOL. 16 PAGE 15
SECTION 14, T. 27 S., R. 6 W., W.M.

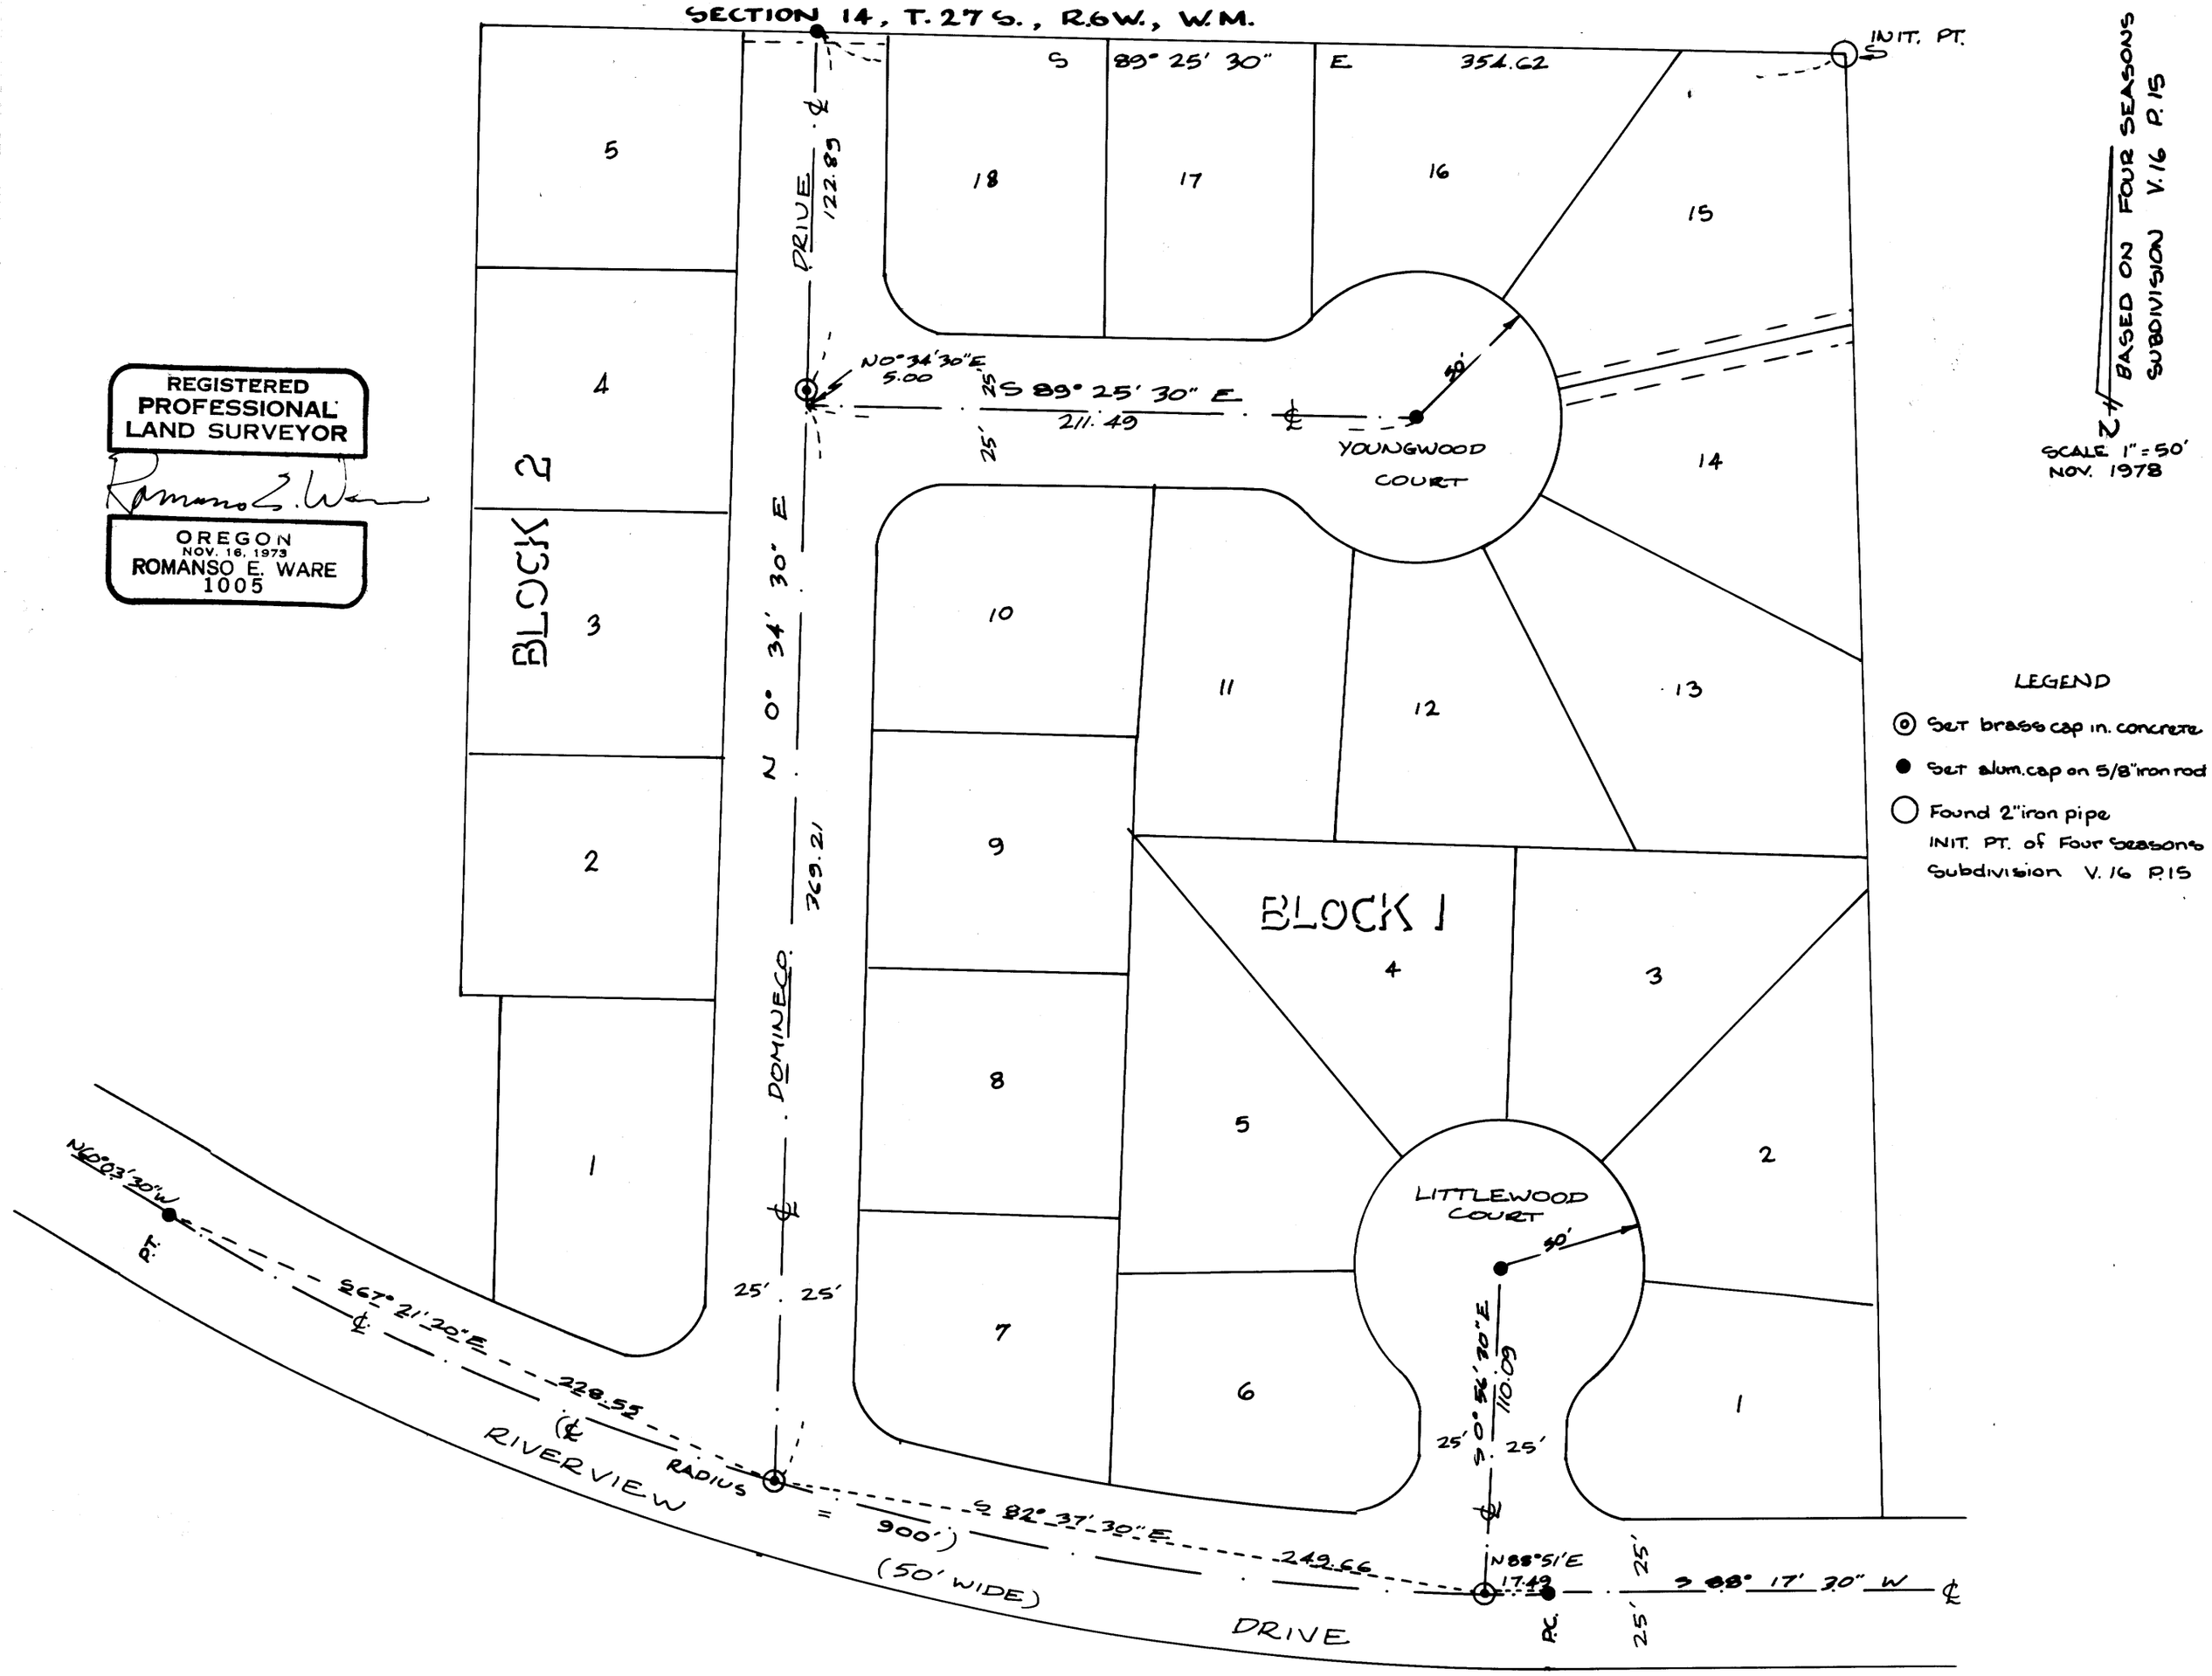

REGISTERED PROFESSIONAL LAND SURVEYOR
Romanso E. Ware
OREGON
NOV. 16, 1973
ROMANSO E. WARE
1005

MAP FILE M 74-39