COUNTY SURVEYORS FILE DATA
DO NOT REMOVE FROM OFFICE

FILED
RECEIVED
JAN 9 1979
COUNTY SURVEYOR
DOUGLAS COUNTY, ORE.

MAP FILE M-77-78A

SURVEY LOCATED IN S.E. 1/4, SEC. 36, T. 22 S. R 13 W. W.M. DOUGLAS COUNTY, OR.

SURVEY FOR:

ELMER AND WANDA HONN
12261 WILDWOOD DR.
NORTH BEND, OR 97459

SURVEY BY:

STUNTZNER ENGINEERING + FORESTRY
P.O. Box 118
COOS BAY, OR 97420

CORNER NOTE:

AT EAST 1/4 COR FOUND ORIG. PIPE END BROKEN OFF 10' PIPE; STRAIGHT IN GROUND; SET 5/8" IRON ROD ON WEST SIDE; MARKED "X" ON 20" D. FIR N 5° E 38.10 FEET, NAILED 1" DIAM. ROUND ALUM. TAG IN TREE BASE COMPASS DEC. 20° E.

FOUND REMAING 10' x 3/4" PIPE BENT AND LOOSE S 74° 36' 10" W 8.53 FEET. RECENT LOGGING MAY HAVE CAUSED DESPLACED PIPE.

LEGEND:

◎ FOUND MONUMENTS (AS NOTED)
● SET MONUMENTS (5/8" IRON RODS)

BASIS OF BEARING: SOLAR OBSERVATION
BASIS OF SURVEY: SURVEY MAP BY W.E. J. BRAYTON DATED FEB. 1955

REGISTERED PROFESSIONAL LAND SURVEYOR
Ronald E. Stuntzner
OREGON
SEPTEMBER 23, 1977
RONALD E. STUNTZNER
1342

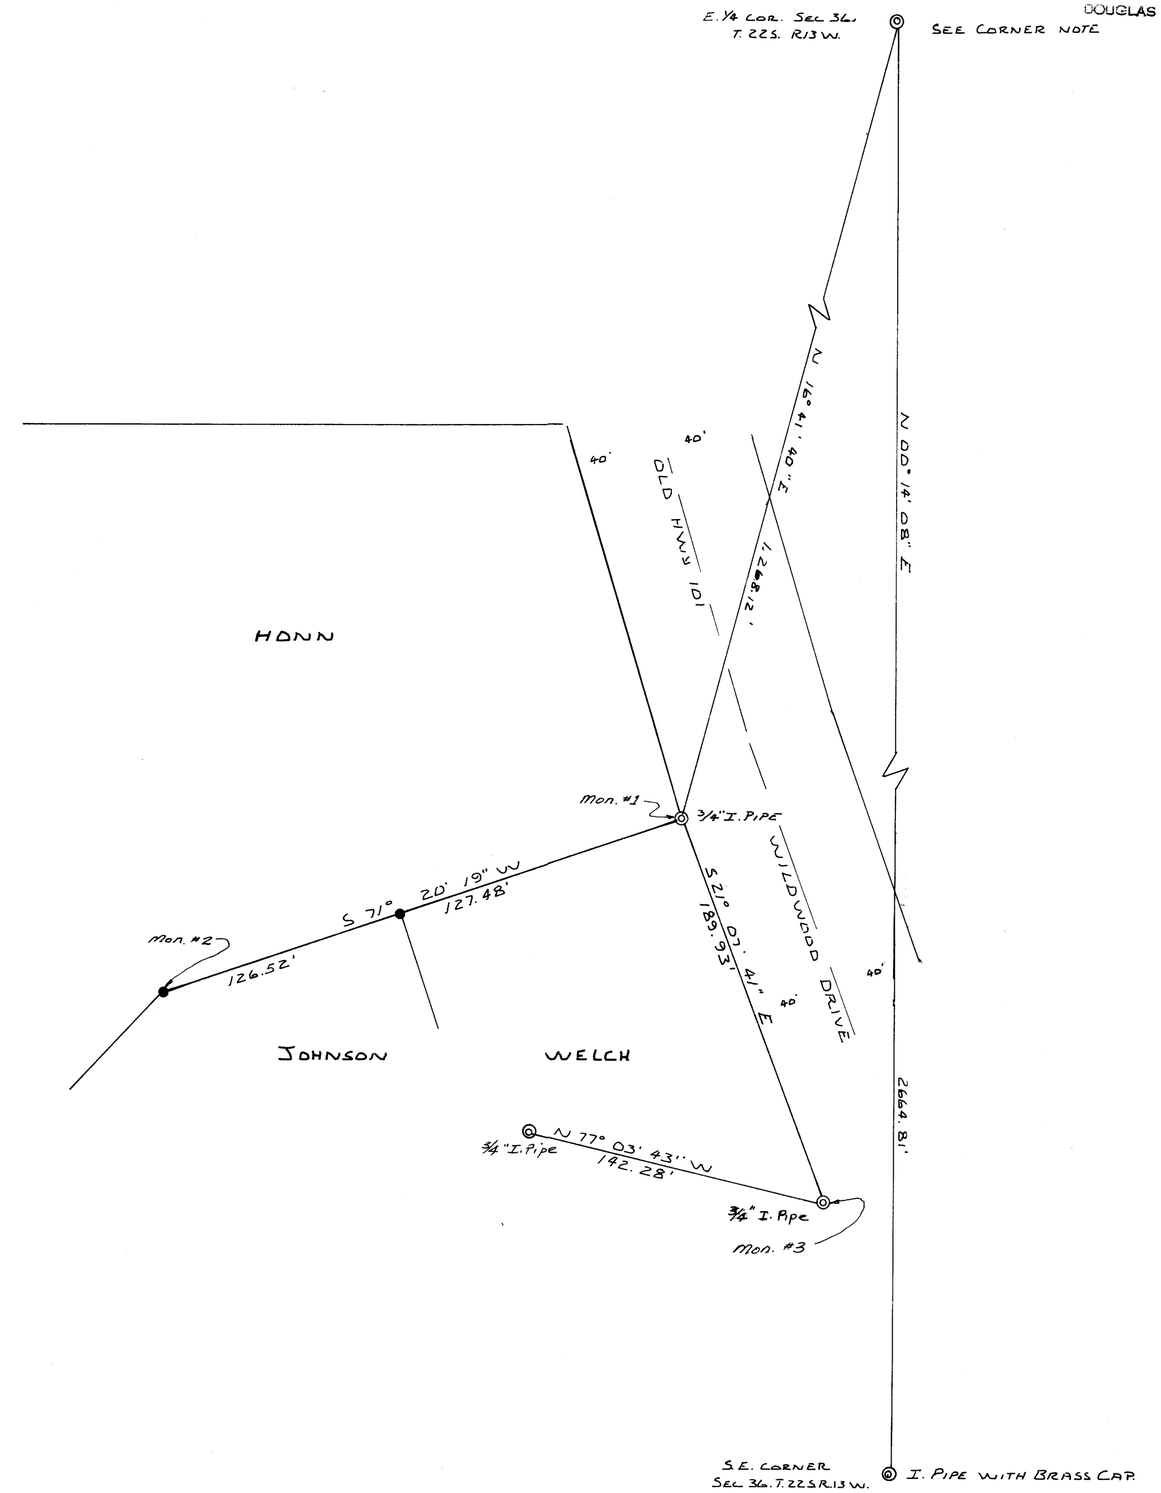

SCALE 1" 50'
DATE JAN. 4, 1979

MAP FILE M-77-78A