COUNTY SURVEYORS FILE DATA
DO NOT REMOVE FROM OFFICE

SURVEY FOR DESCRIPTION

IN LOT 12 BLOCK 2, PLAT - C, SUTHERLIN LAND & WATER CO.
SECTION 20, T.25S. R.5W.W.M. — DECEMBER 1978 — SCALE: 1"=100'

FOR: GARY HALL
BY: BAUGHMAN TECHNICAL SERVICES INC.

FILED
RECEIVED
JAN 11 1979
COUNTY SURVEYOR
DOUGLAS COUNTY, ORE.
TH

MAP FILE M.74-82

NOTE:

Being unable to find any control to the North, we establish the northerly line, by using call distance on the westerly boundary and a line parallel to the southerly boundary.

REGISTERED
PROFESSIONAL
LAND SURVEYOR
William L. Baughman
GLE...

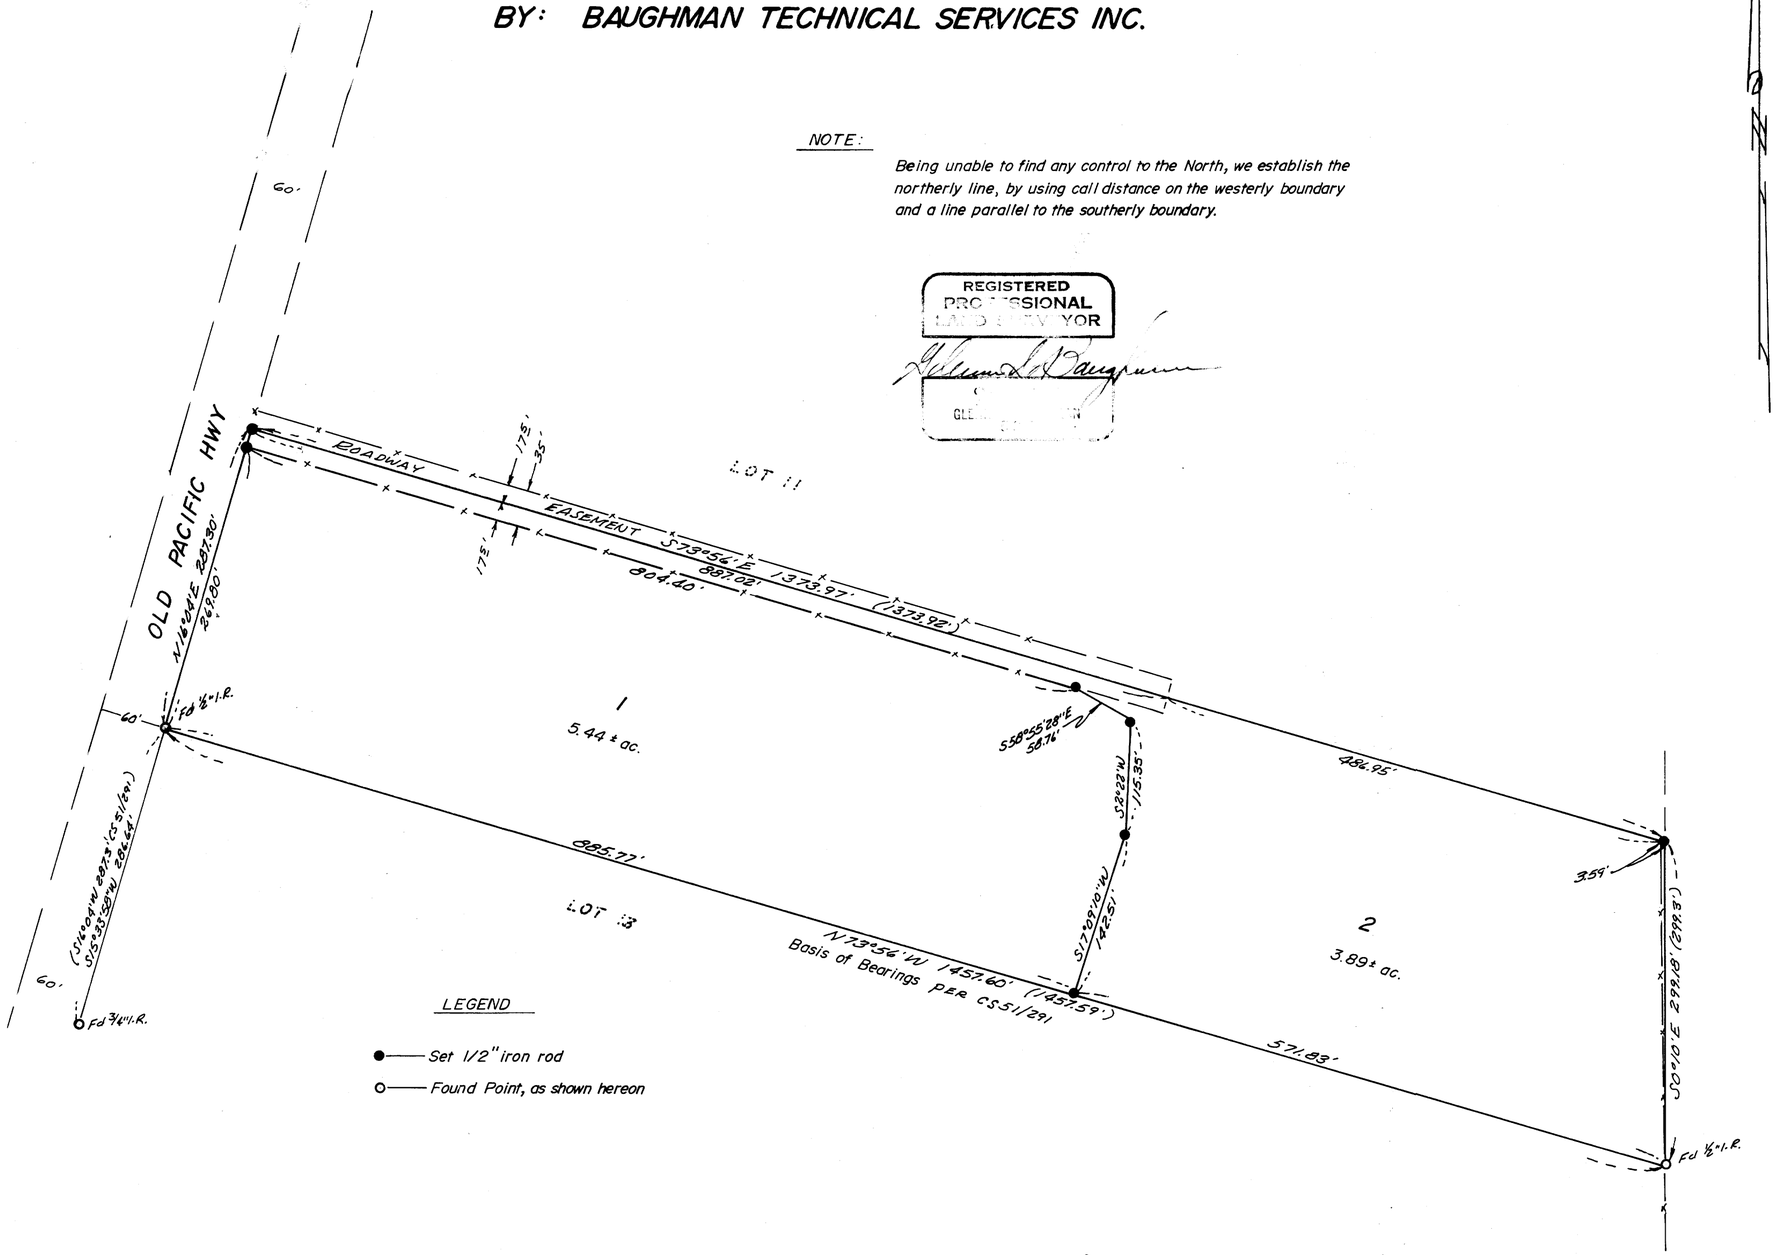

LEGEND

● —— Set 1/2" iron rod
○ —— Found Point, as shown hereon

MAP FILE M.74-82

FM 6-70