COUNTY SURVEYORS FILE DATA
DO NOT REMOVE FROM OFFICE

PROPERTY SURVEY FOR VERN LIESINGER

IN SECTION 32, T 27 S, R 6 W, W.M.

BY: HAROLD L. BALL, SURVEYOR

JANUARY, 1979

SCALE: 1" = 100'

FILED
RECEIVED
JAN 29 1979
COUNTY SURVEYOR
DOUGLAS COUNTY, ORE.
TB

MAP FILE M75-24

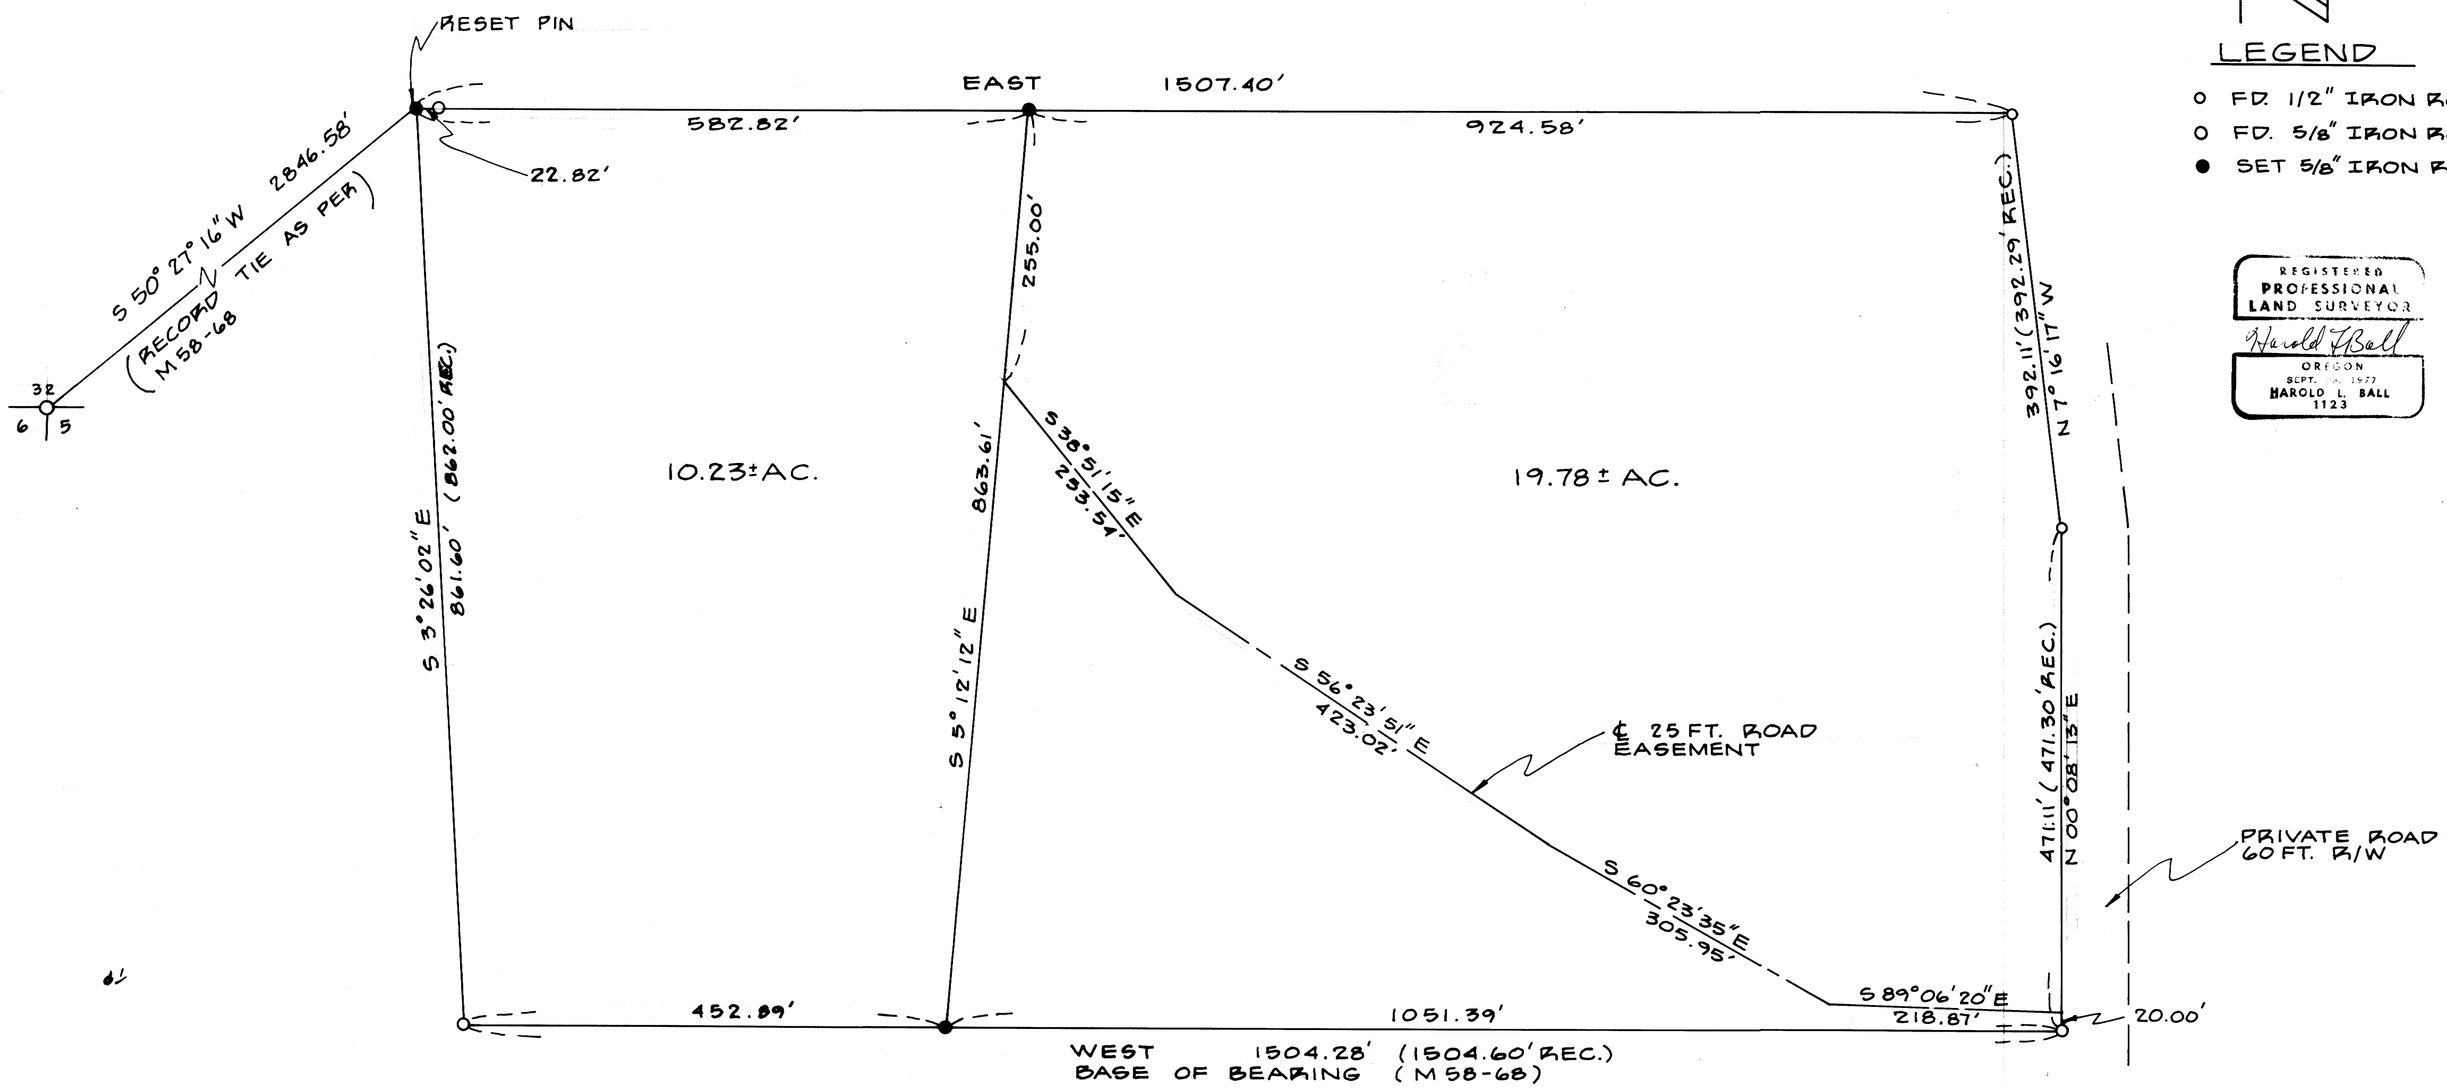

LEGEND

- ○ FD. 1/2" IRON ROD
- ○ FD. 5/8" IRON ROD
- ● SET 5/8" IRON ROD

REGISTERED PROFESSIONAL LAND SURVEYOR
Harold L. Ball
OREGON
SEPT. 19, 1977
HAROLD L. BALL
1123

MAP FILE M75-24