SURVEY for Vaughn L. Mefferd

in

Section 12 & Section 13, T26S, R7W, W.M., Douglas Co., Oregon

January 1979

by

UMPQUA SURVEYING COMPANY

Myrtle Creek, Oregon

COUNTY SURVEYORS FILE DATA
DO NOT REMOVE FROM OFFICE

FILED
RECEIVED
COUNTY SURVEYOR
DOUGLAS COUNTY, ORE.

MAP FILE M 75-32

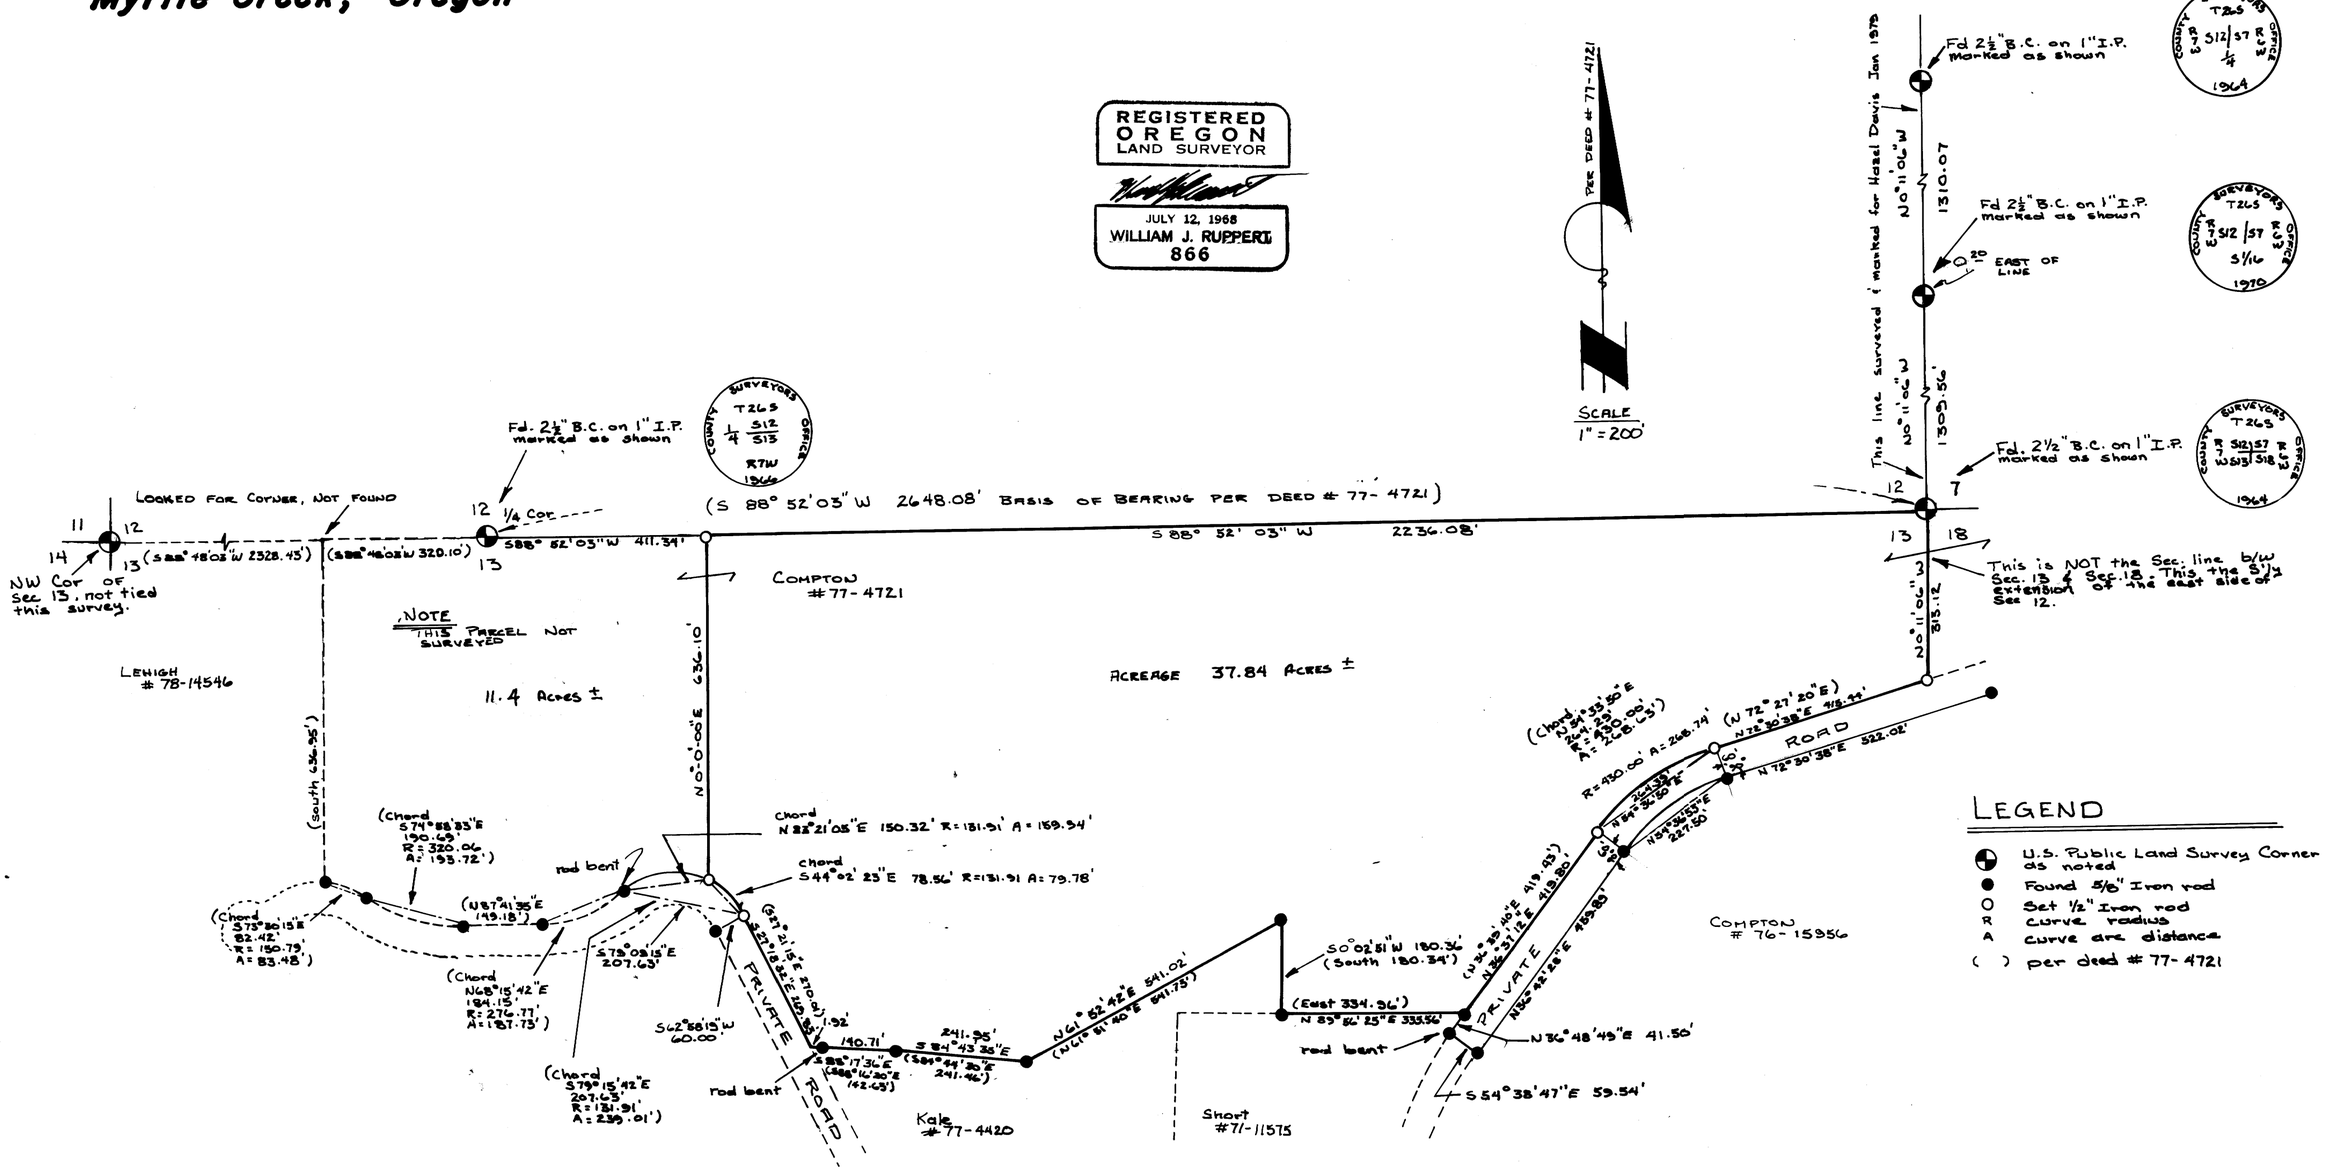

MAP FILE M 75-32