MAP FILE M75-33

COUNTY SURVEYORS FILE DATA
DO NOT REMOVE FROM OFFICE

Survey for JACK PICKETT in D.L.C. no. 62, Sec 26 & 27, T30S, R5W, W.M., Douglas Co., Oregon January 1979 by UMPQUA SURVEYING CO. Myrtle Creek, Oregon

FILED
RECEIVED
FEB 7 1979
COUNTY SURVEYOR
DOUGLAS COUNTY, ORE.

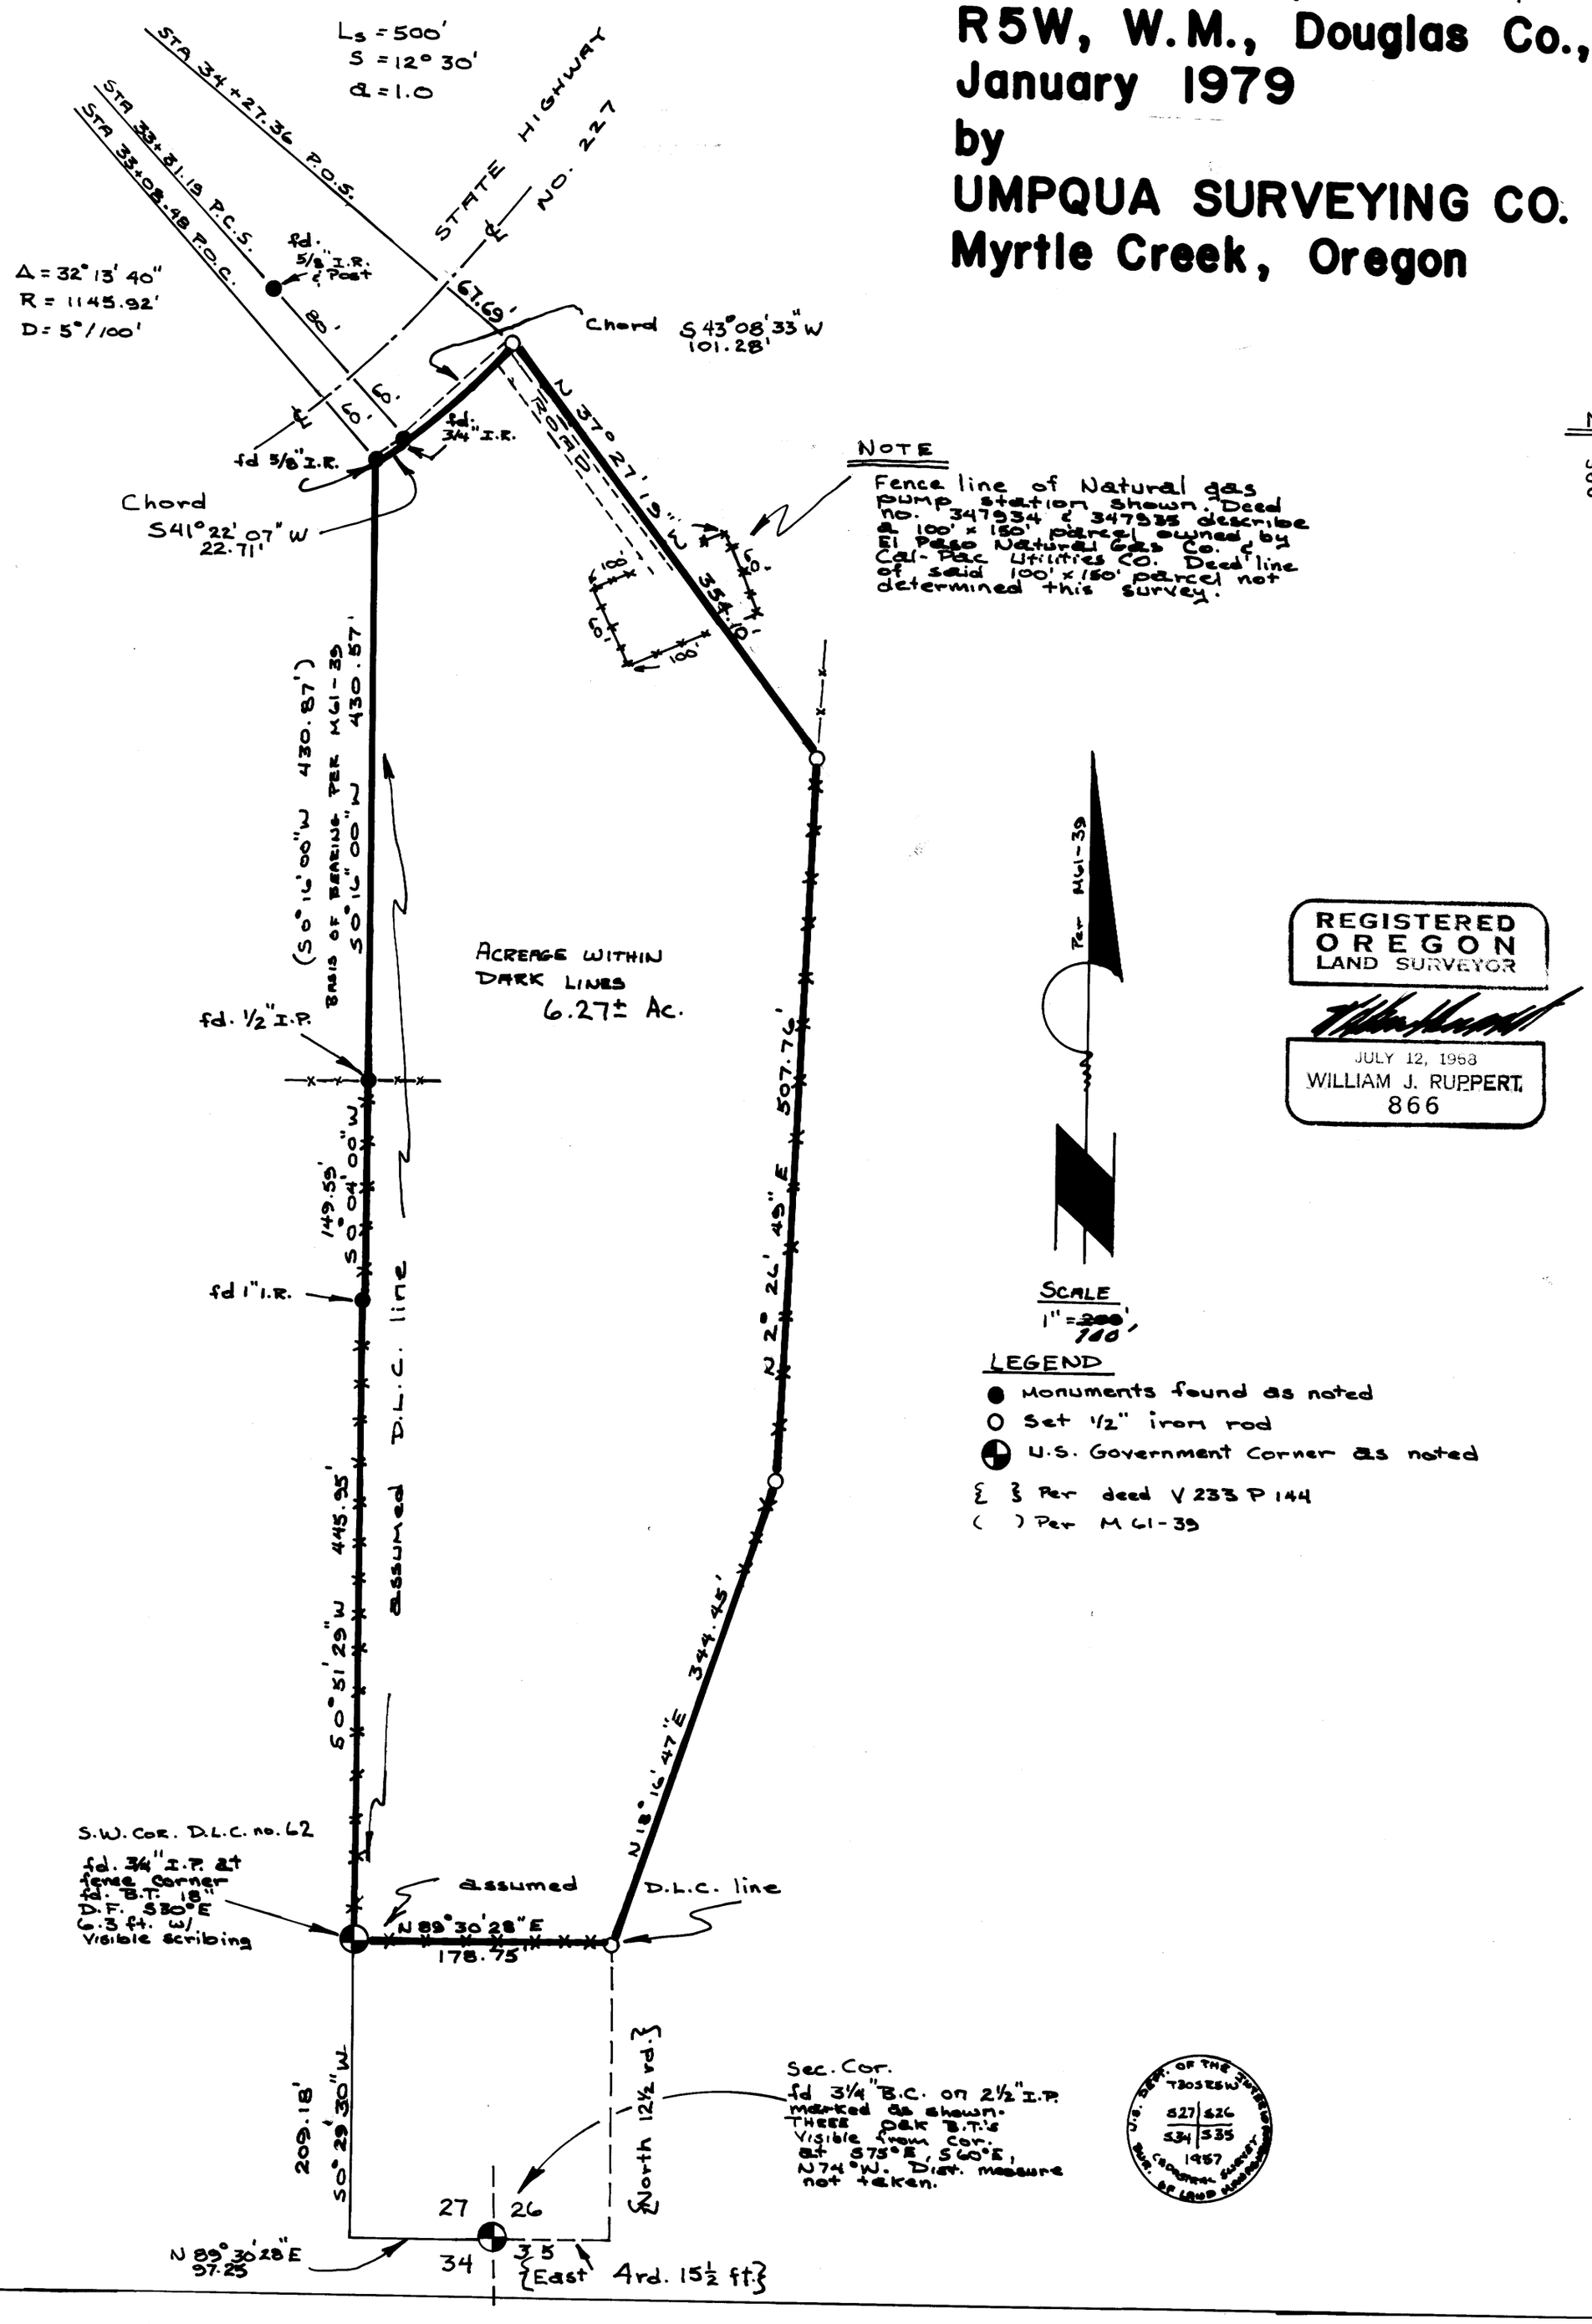

NOTE

Fence line of Natural gas pump station shown. Deed no. 347934 & 347935 describe a 100' x 150' parcel owned by El Paso Natural Gas Co. & Cal-Pac Utilities Co. Deed line of said 100' x 150' parcel not determined this survey.

NOTE:

Purpose of this survey was to prepare legal description of property for conveyance to adjoiner.

SCALE

1" = ~~200~~ 100'

LEGEND

- ● Monuments found as noted
- ○ Set 1/2" iron rod
- ⊕ U.S. Government Corner as noted

{ } Per deed V 233 P 144

( ) Per M 61-39

REGISTERED OREGON LAND SURVEYOR

JULY 12, 1968
WILLIAM J. RUPPERT
866

U.S. DEPT. OF THE INTERIOR — T30S R5W — 527 | 526 — 534 | 535 — 1957 — CADASTRAL SURVEY — BUR. OF LAND MANAGEMENT

MAP FILE M75-33