SURVEY TO ESTABLISH PROPERTY CORNERS

IN LOT 2 BL 2 PL. "A" S. L. & W. CO. IN SEC. 16 T25S R5W W.M.

SURVEYED FOR TAUCHER & HUTCHINGS BY BAUGHMAN TECHNICAL SERVICE

FEB. 1979 SCALE 1"=100'

BEARINGS BASED ON C.S. FILE M3-52, N17°32'00"W

COUNTY SURVEYORS FILE DATE
DO NOT REMOVE FROM OFFICE

LEGEND

- ○ SET 1/2" I.R.
- ◐ FD. 5/8" I.R.
- ● FD. 3/4" I.P.
- △ Computed from M40-18 & M3-52, not set.

REGISTERED PROFESSIONAL LAND SURVEYOR
Glenn S. Baughman
OREGON JULY 14, 1961 GLENN S. BAUGHMAN 536

FILED
RECEIVED
FEB 28 1979
COUNTY SURVEYOR
DOUGLAS COUNTY, ORE.
TB

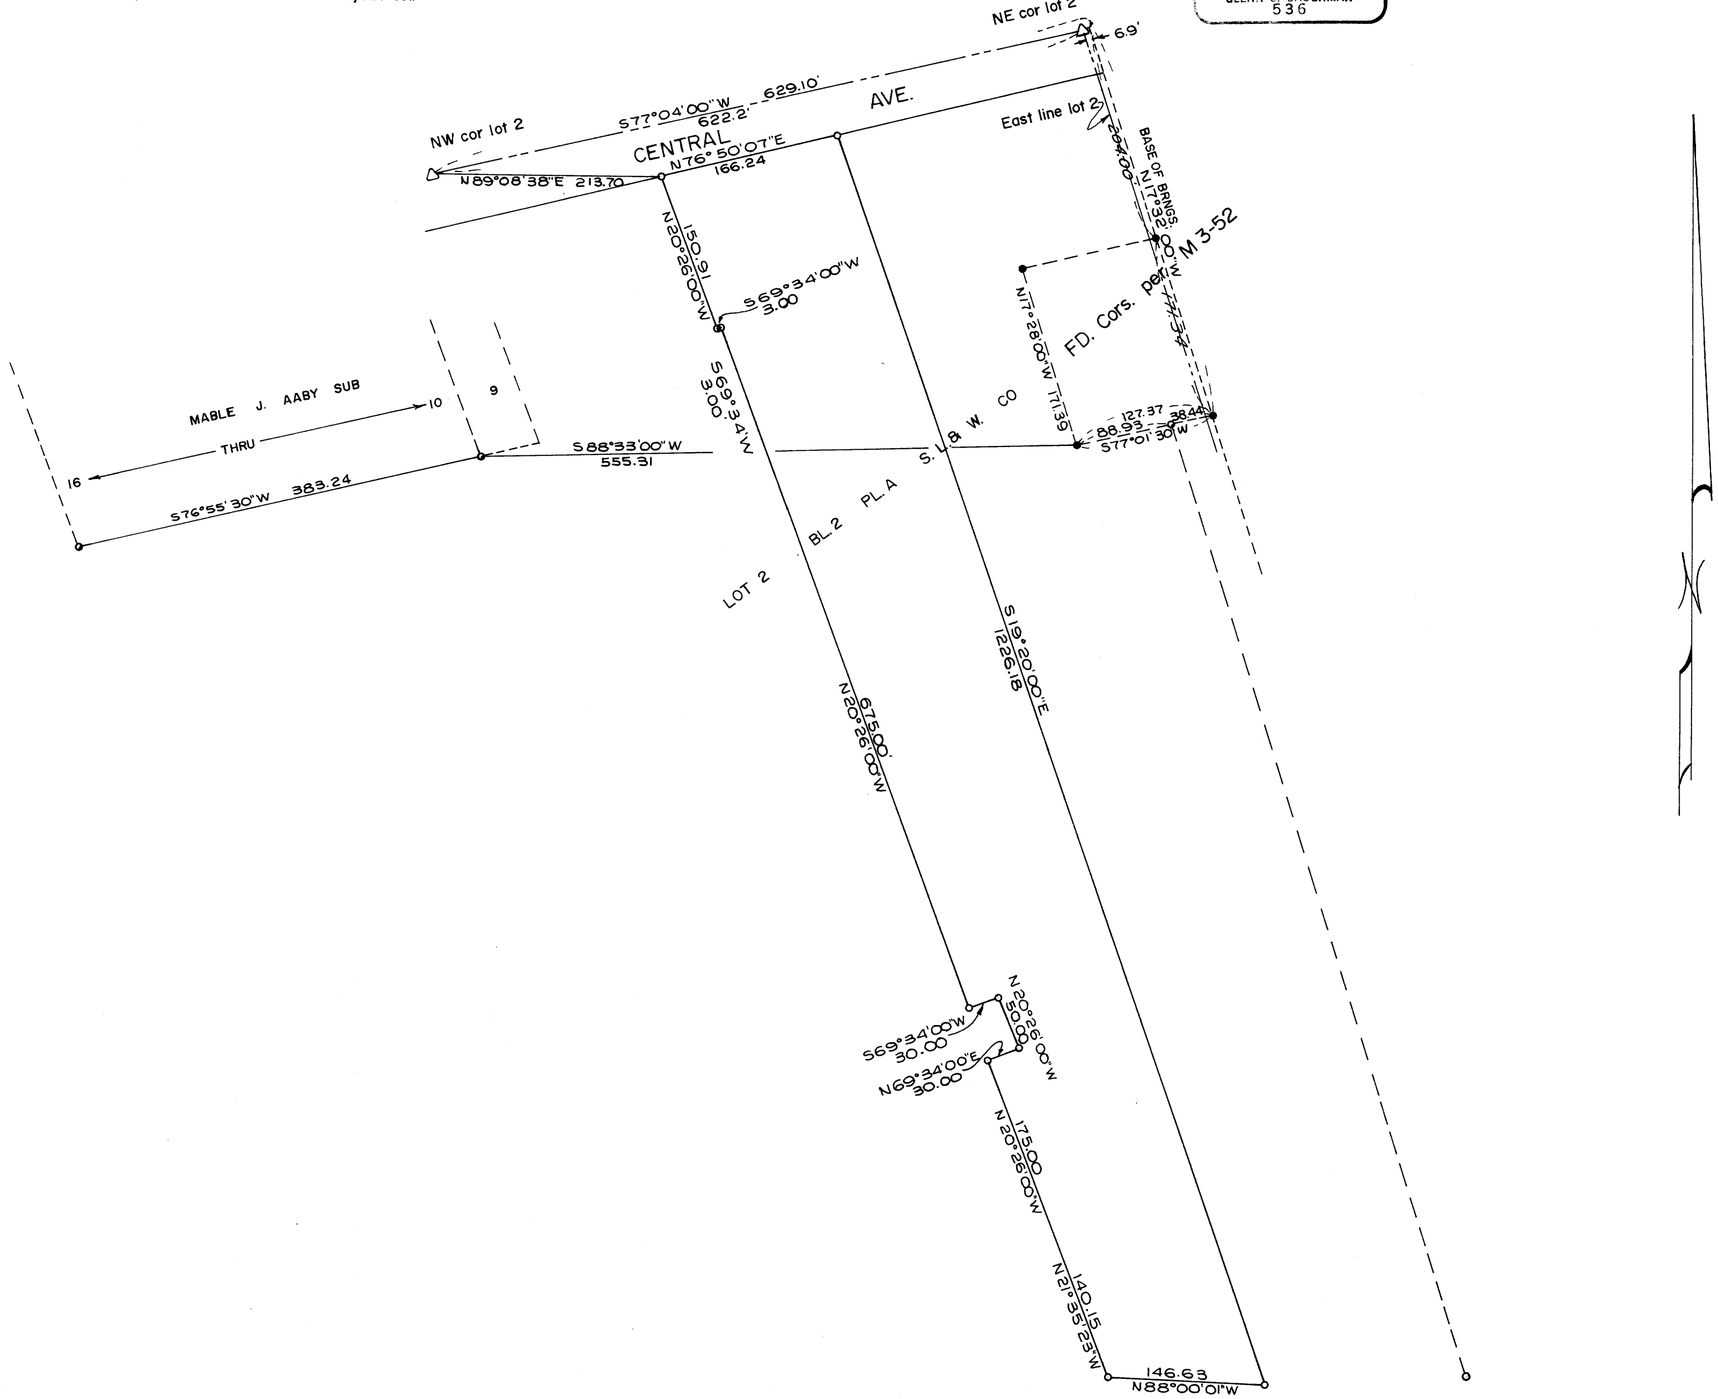

MAP FILE M75-63

MAP FILE M75-63