SURVEY TO SET LOT CORNERS

FIRST ADDN. TO KINNEY'S IMPROVED PLAT, SEC. 18, T.27S., R.5W.W.M.

FOR - JAMES E. WING

BY - BAUGHMAN TECHNICAL SERVICE

MARCH 1979

COUNTY SURVEYORS FILE DATA
DO NOT REMOVE FROM OFFICE

FILED
RECEIVED
APR 3 1979
COUNTY SURVEYOR
DOUGLAS COUNTY, ORE.
TB

MAP FILE N76 - 27

REGISTERED PROFESSIONAL LAND SURVEYOR
OREGON
GLENN D. BAUGHMAN
536

- ○ Set 1/2" I. R.
- ● Fd. 5/8" I.R.
- ◎ Fd. St. Mon.

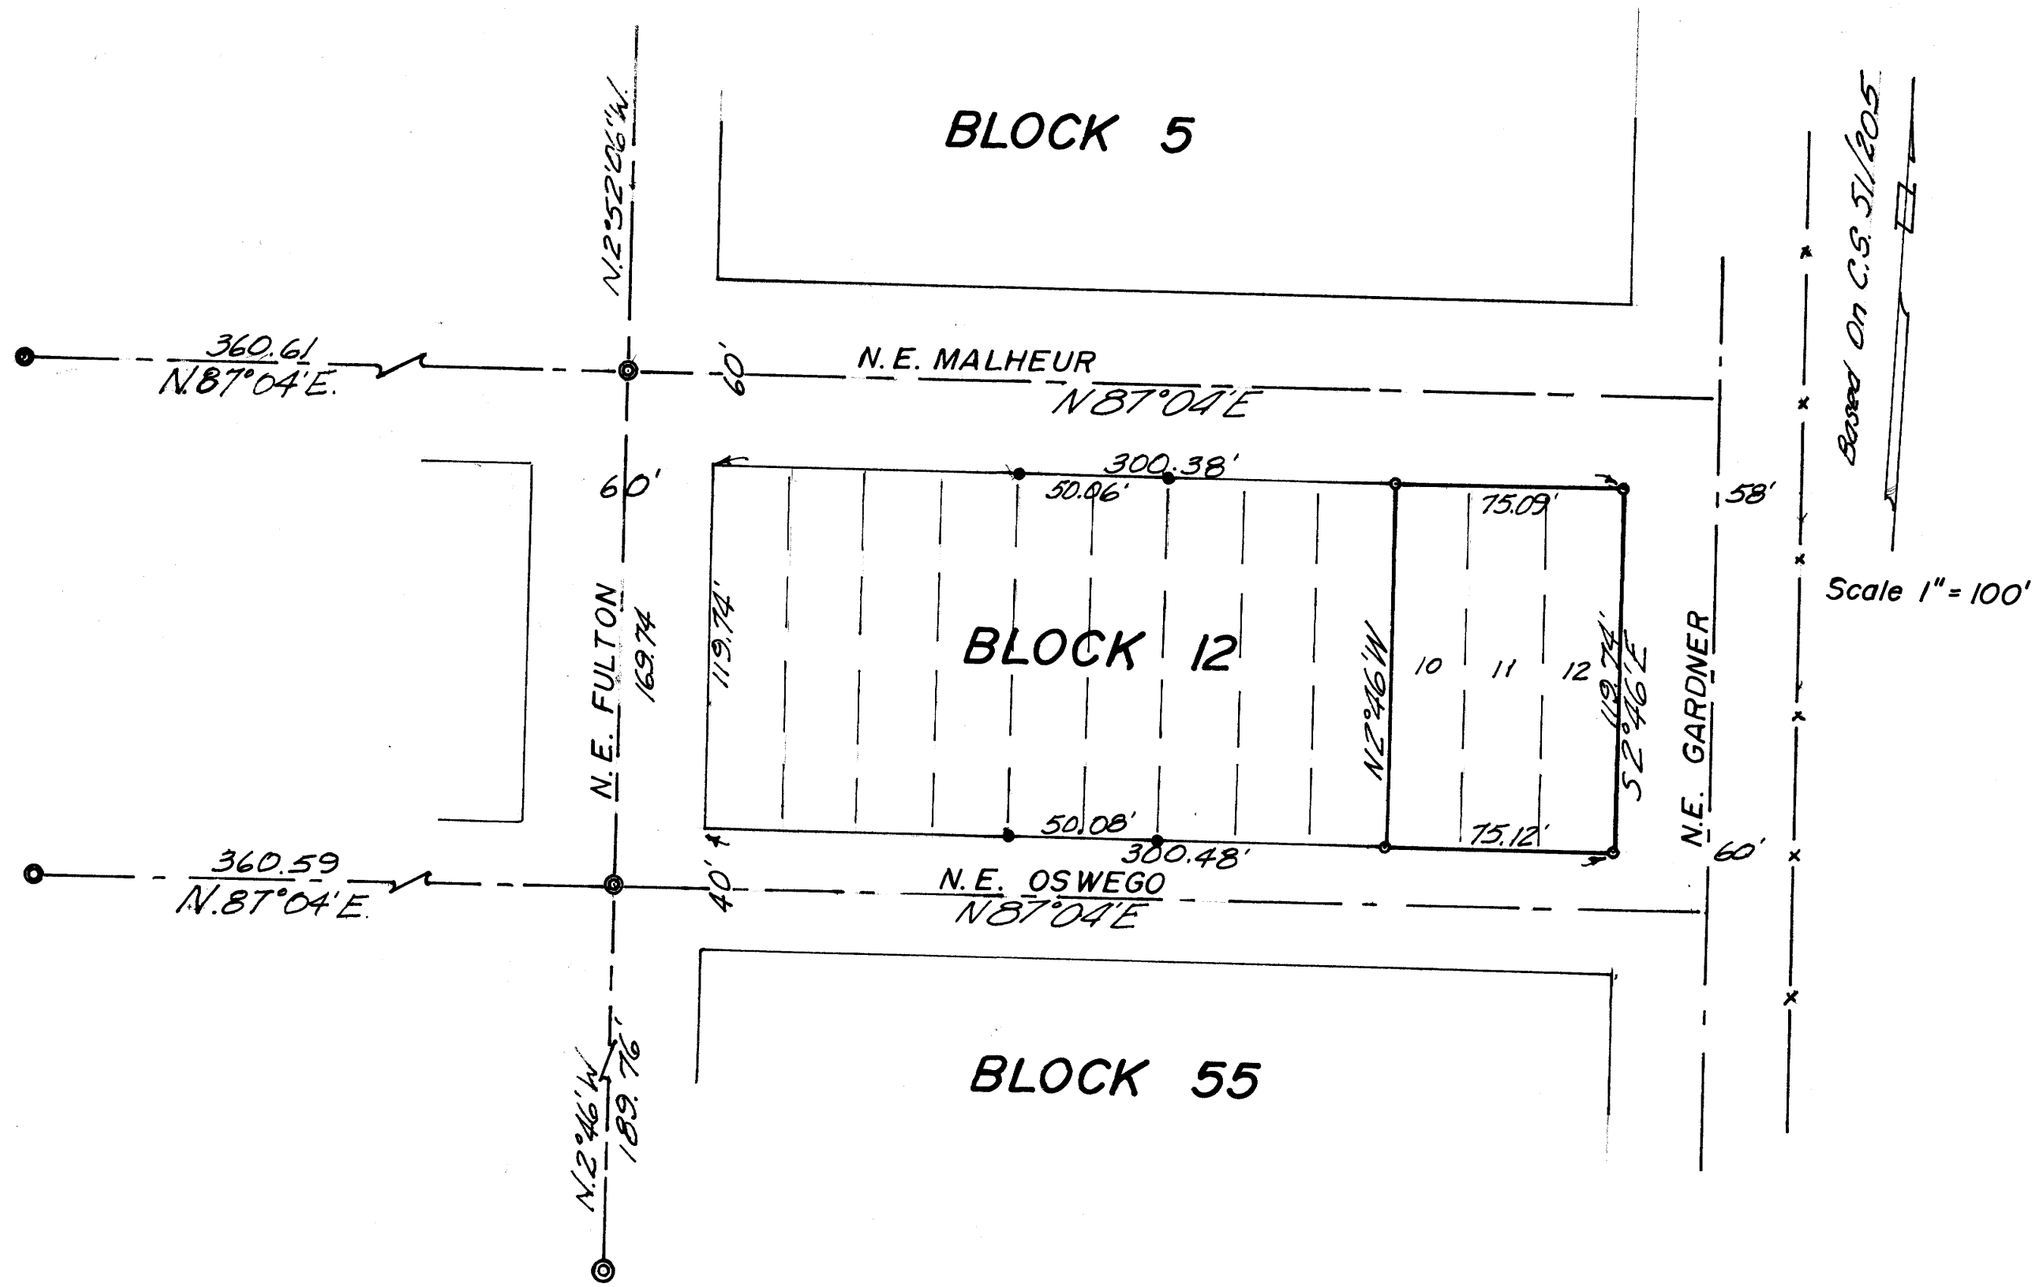

MAP FILE N76 - 27