COUNTY SURVEYORS FILE DATA
DO NOT REMOVE FROM OFFICE
FILED
RECEIVED TB
APR 18 1979
COUNTY SURVEYOR
DOUGLAS COUNTY, ORE.

SURVEY OF DEED DESCRIPTION FOR PITCHFORD'S INC.

P.O. BOX 10072
EUGENE, OREGON 97440

PARCEL LOCATED IN SECTION 28, TOWNSHIP 29 SOUTH, RANGE 5 WEST, WILLAMETTE MERIDIAN, DOUGLAS COUNTY, OREGON

LEGEND

- ● FOUND 3/4" IRON ROD
- ◐ FOUND 1" IRON ROD
- ○ SET 1 1/2" IRON ROD
- ● SET 1 1/2" IRON PIPE
- ◐ SET 1/2" IRON PIPE

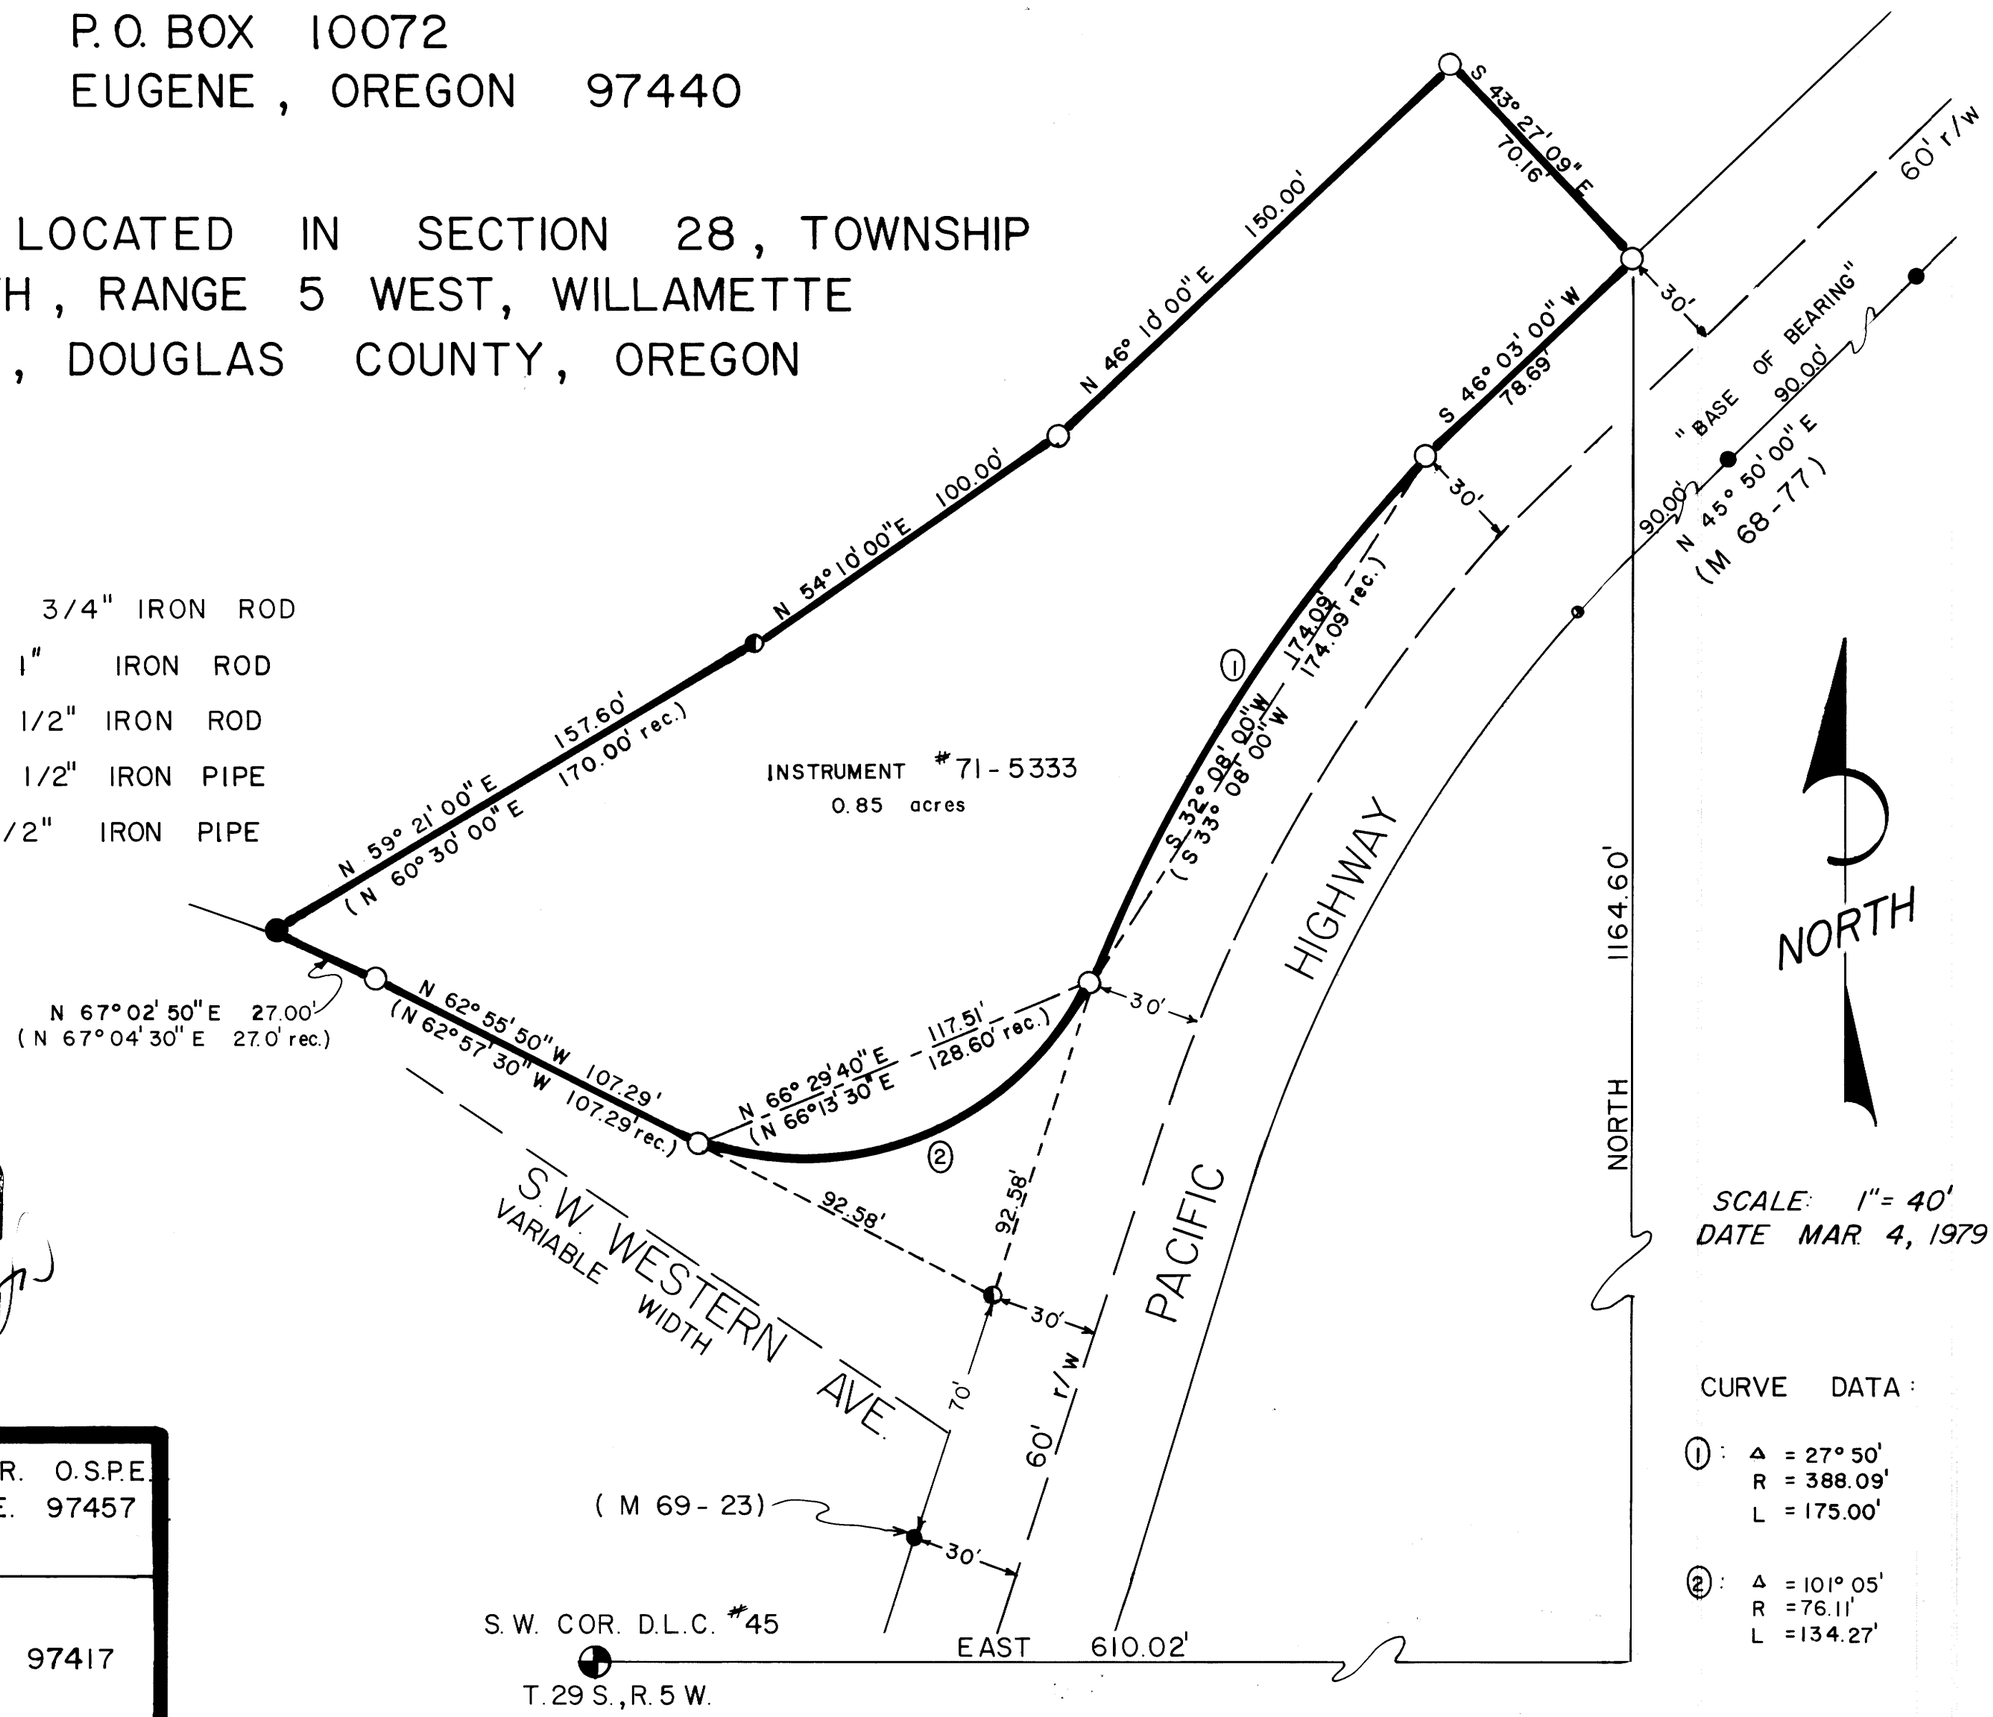

SCALE: 1" = 40'
DATE MAR. 4, 1979

CURVE DATA:

① : Δ = 27° 50'
R = 388.09'
L = 175.00'

② : Δ = 101° 05'
R = 76.11'
L = 134.27'

REGISTERED PROFESSIONAL LAND SURVEYOR
OREGON
SEPTEMBER 21, 1977
JOHN H. MARKHAM, JR.
1281

JOHN H. MARKHAM JR. O.S.P.E.
MYRTLE CREEK, ORE. 97457
ph. 863-4590

MAP PREPARED BY
RAYMOND F. BROWN
CANYONVILLE, ORE. 97417
ph. 839-6185

MAP FILE M 76-45