MAP FILE M76-55

COUNTY SURVEYORS FILE DATA
DO NOT REMOVE FROM OFFICE

FILED
RECEIVED
APR 17 1979
COUNTY SURVEYOR
DOUGLAS COUNTY, ORE.

Survey of the Subdivision of Section 32, T. 20 S., R. 10 W.

In Douglas County, Oregon.

APRIL, 1979

For: International Paper Company
Bearings shown: True as determined from Solar observations.
Monuments found and used for Control shown: ◎
Monuments set shown: ○ Scale of map: 1" = 400 ft.
Lines Blazed, Painted, Flagged shown: ═══
True lines marked every 300 ft. or less shown: ═══
This was a transit and tape and E.D.M. survey.
A 1" Iron axle post, which has been used as a 1/4 Cor. for several local deed descriptions in Sections 31 + 32, was found S. 1°03' W. 65.29 ft from the midpoint on the W. line of Sec. 32. Since I found no physical evidence to support this location and no local resident was found who claimed to know the history of this monument I considered the 1/4 Corner lost and established the 1/4 Corner for Sections 31 + 32 at the midpoint on the Section line. The distance from my 1/4 Corner to the NW Corner Sec. 32 compares with Clif Stephens measurement in 1954 of 2663.82 ft.
A thorough search was made for evidence of the SW Corner of Sec. 32. On finding no evidence I locate this Corner point by single porportion.

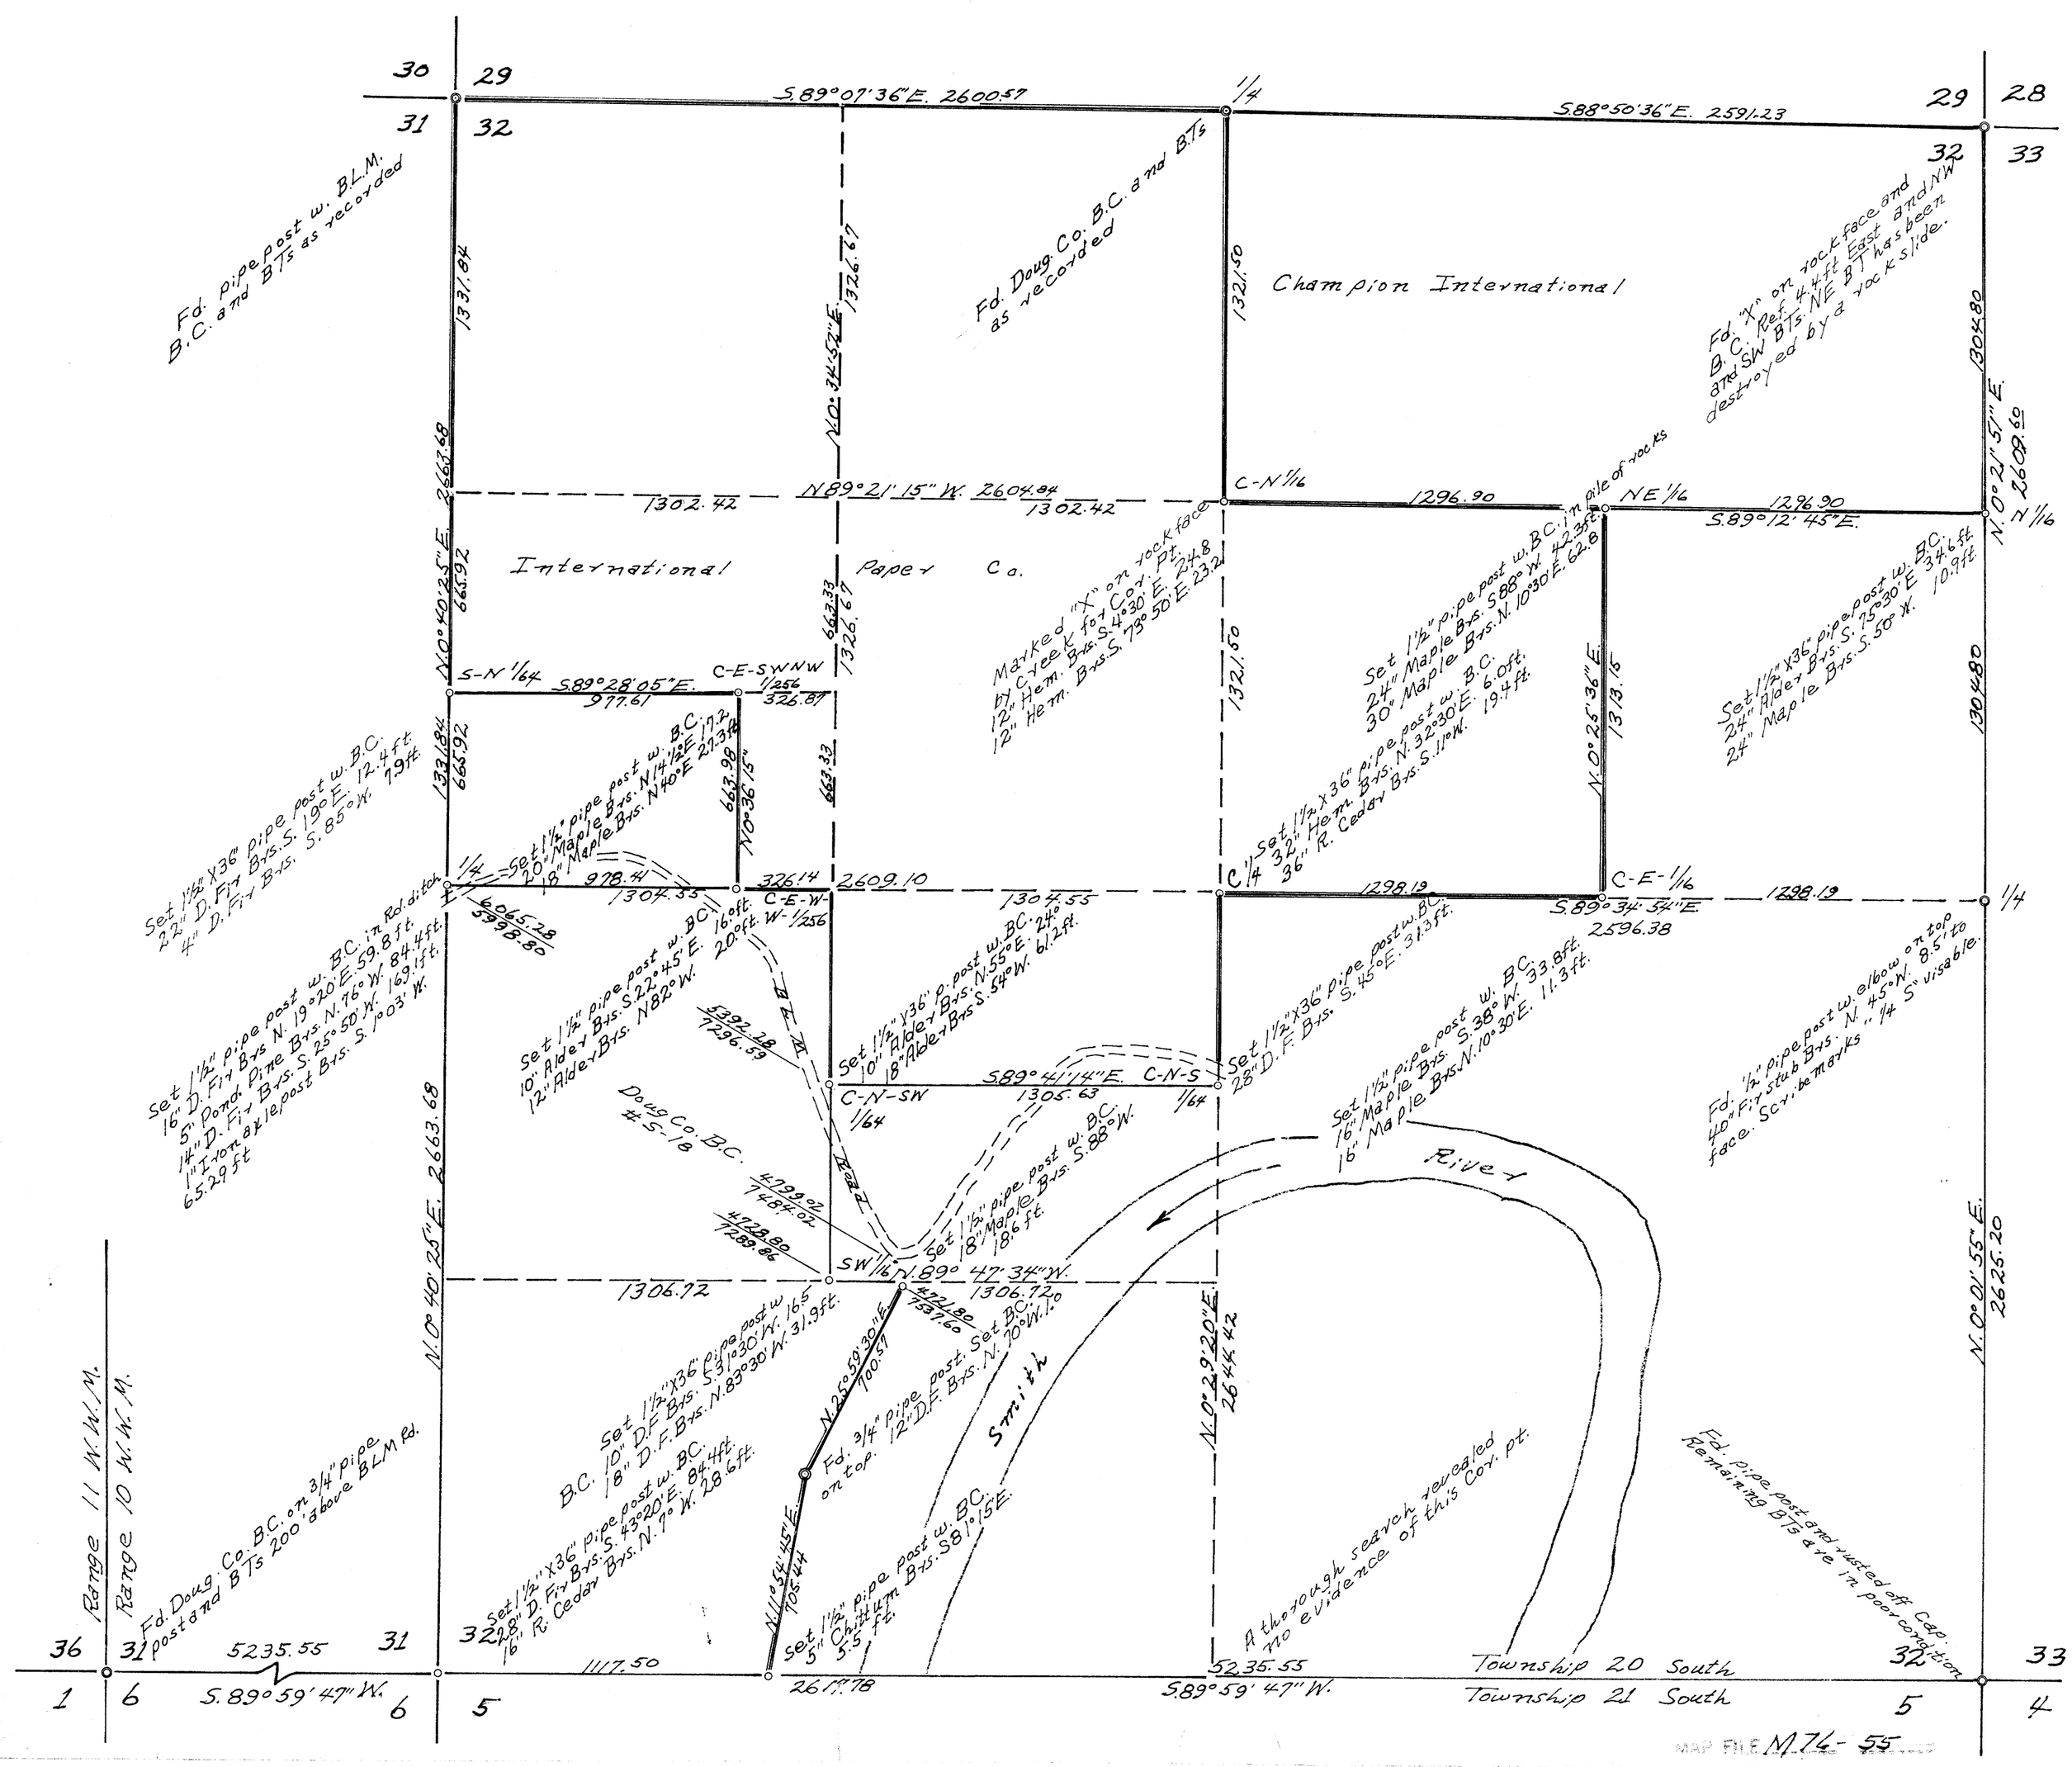
S.89°07'36"E. 2600.57
S.88°50'36"E. 2591.23
Fd. pipe post w. B.L.M. B.C. and B.Ts as recorded
Fd. Doug. Co. B.C. and B.Ts as recorded
Champion International
Fd. "X" on rock face and B.C. Ref. 4.4 ft East and N.W. and S.W. B.Ts. NE B.T. has been destroyed by a rock slide.
N89°21'15"W. 2604.84
International Paper Co.
Marked "X" on rock face by Creek for Cor. Pt.
Set 1/2" pipe post w. B.C. in pile of rocks
Set 1/2" x 36" pipe post w. B.C.
Set 1/2" pipe post w. B.C. in Rd. ditch
Set 1/2" pipe post w. B.C.
Set 1/2" x 36" pipe post w. B.C.
Set 1/2" pipe post w. B.C.
Set 1/2" x 36" pipe post w. B.C.
Set 1/2" x 36" pipe post w. B.C.
Set 1/2" x 36