COUNTY SURVEYOR FILE DATA
DO NOT REMOVE FROM OFFICE

FILED
RECEIVED
MAY 14 1979
COUNTY SURVEYOR
DOUGLAS COUNTY, ORE.

SECTS 14 & 23, T. 22 S., R. 10 W. W.M.

Tract #6 unrecorded plat White's Acres

For

Andrew Bajer 2830 Elinor Eugene, Ore. 97403

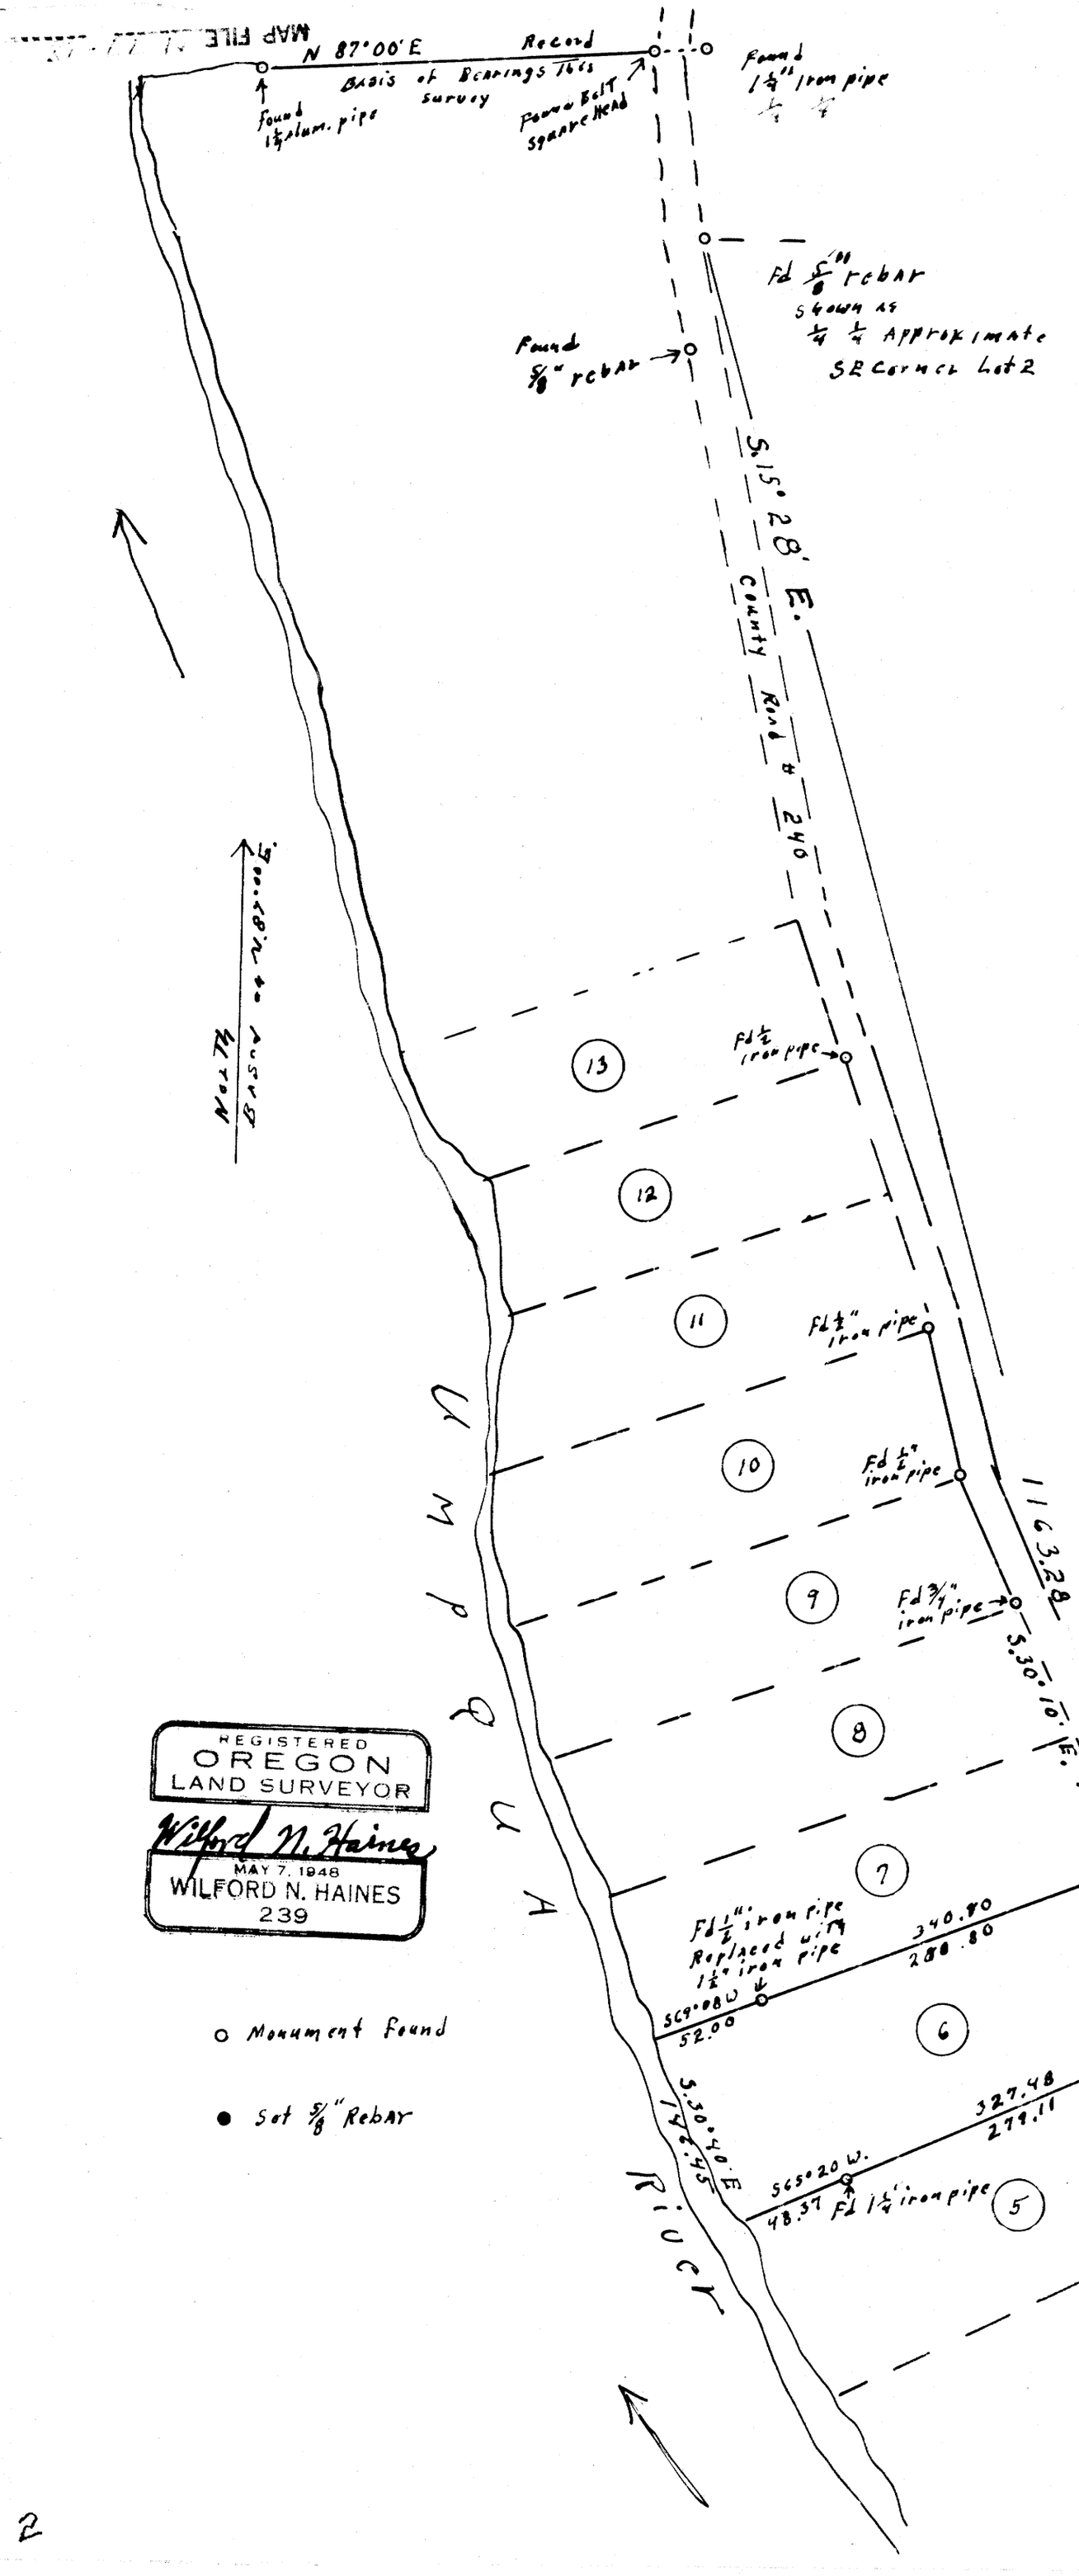

REGISTERED
OREGON
LAND SURVEYOR
Wilford N. Haines
MAY 7, 1948
WILFORD N. HAINES
239

o Monument Found

● Set ⅝" Rebar

2

MAP FILE M 22-18