MAP FILE M77-4

FILED
RECEIVED
MAY 8 1979
COUNTY SURVEYOR
DOUGLAS COUNTY, ORE.

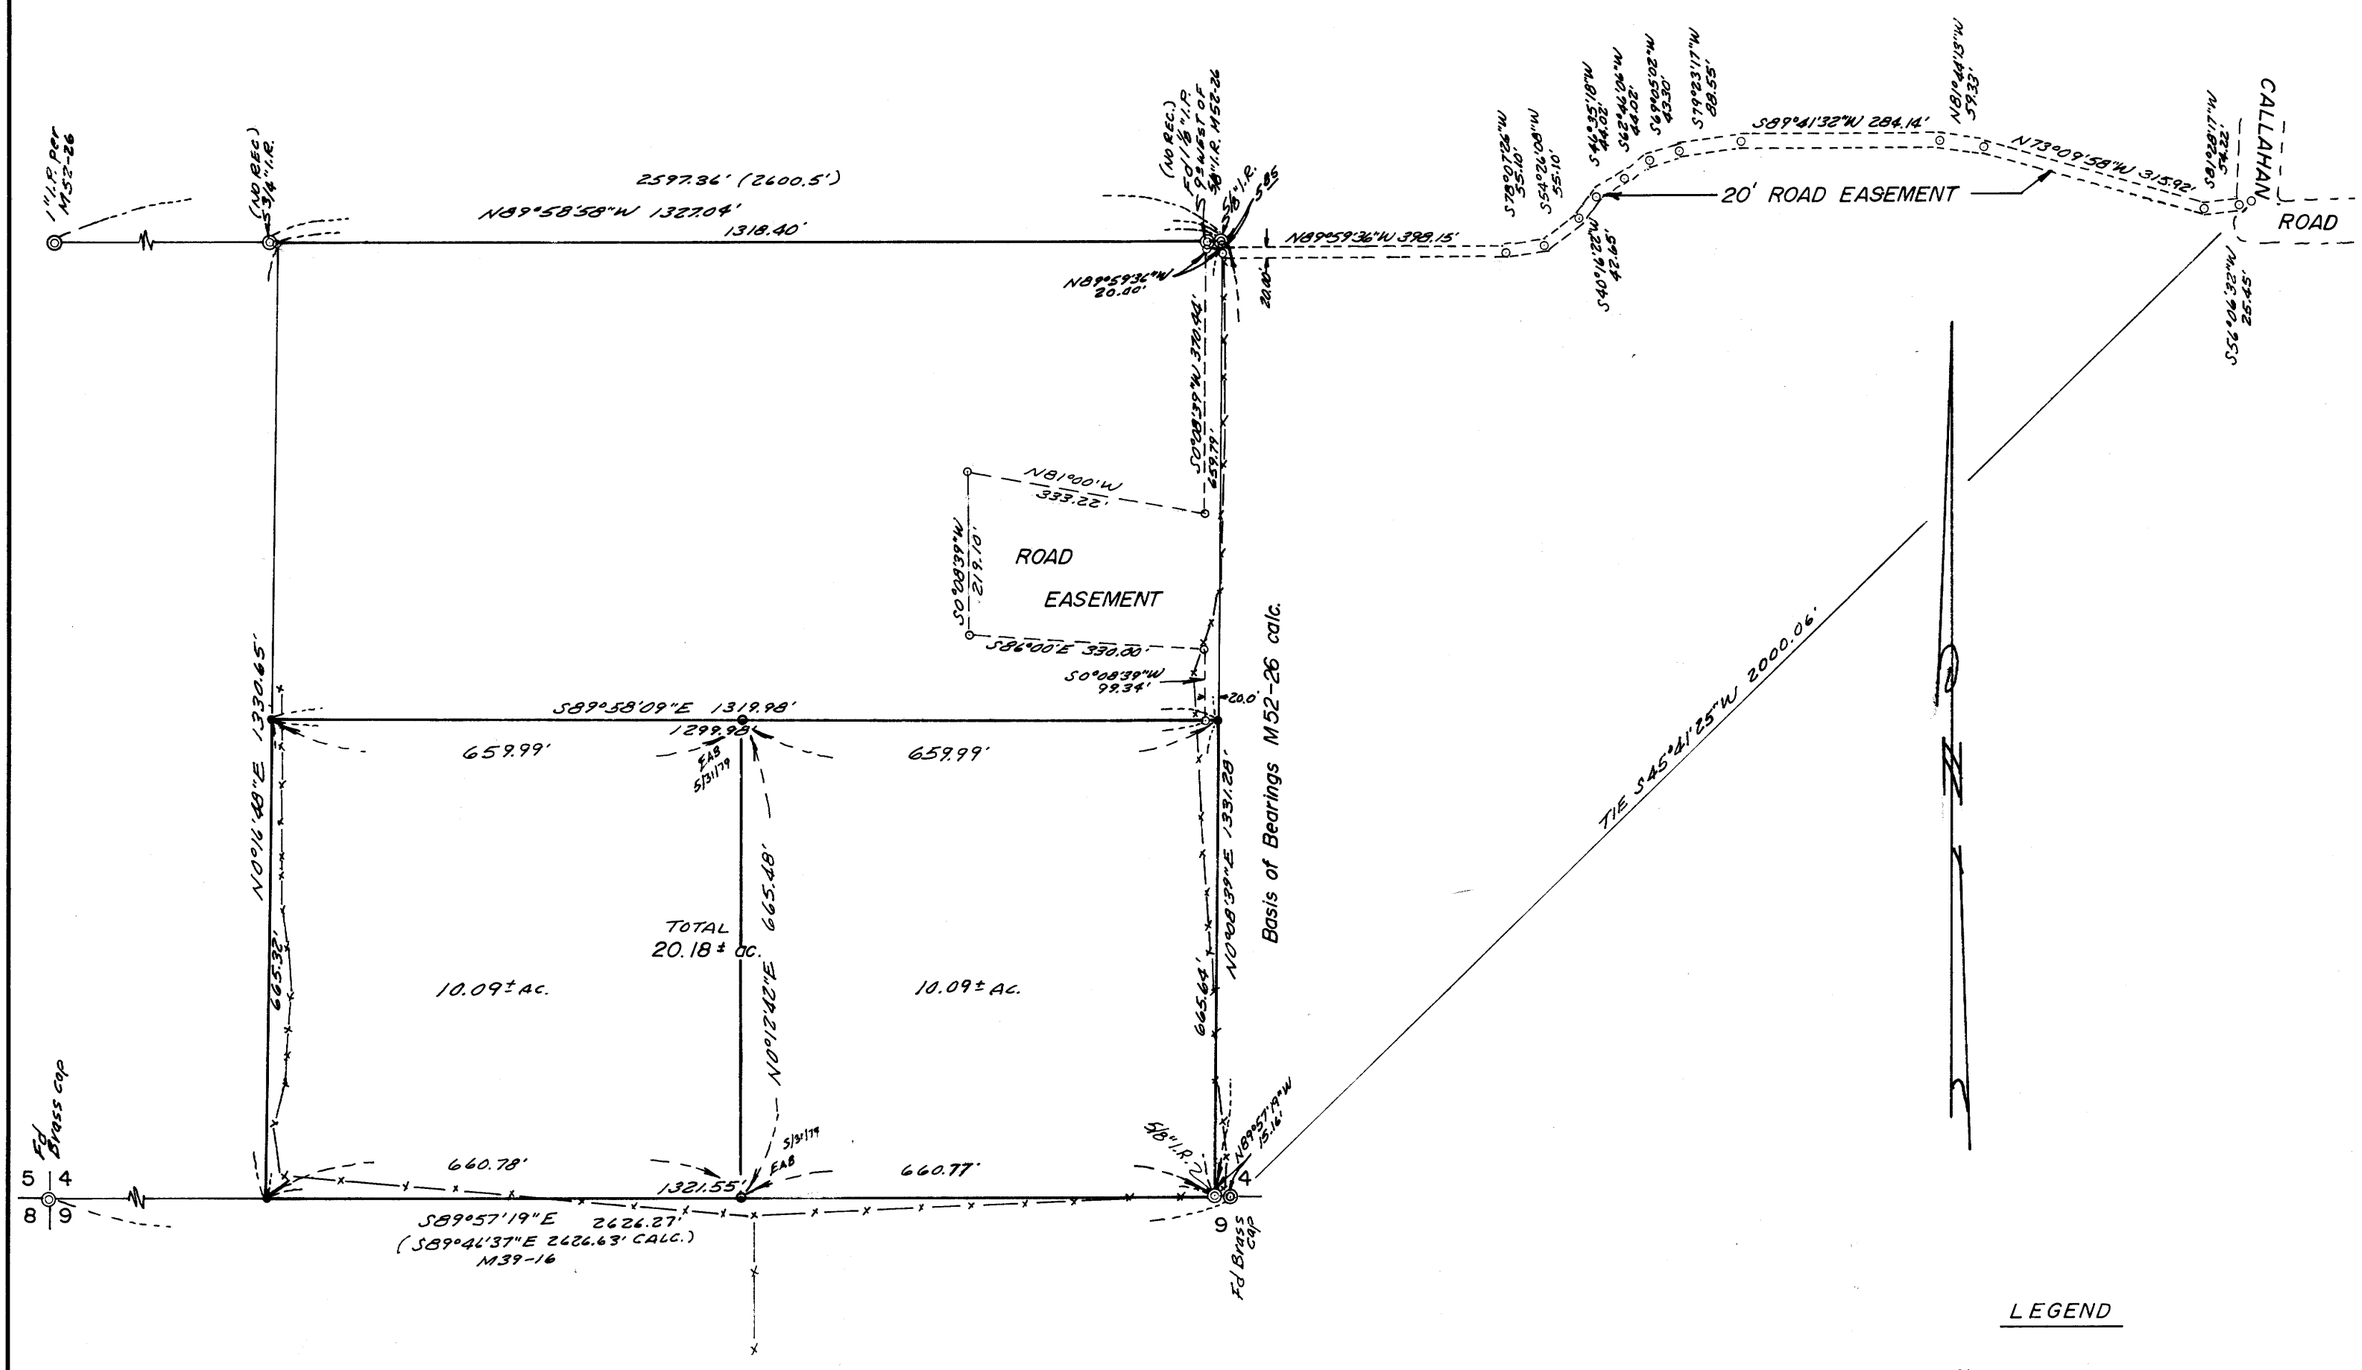

LEGEND

- ○ —— Not set
- ● —— Set 1/2" iron rod
- ◎ —— Found point, as noted

REGISTERED PROFESSIONAL LAND SURVEYOR
Glenn S. Baughman
OREGON
JULY 14, 1961
GLENN S. BAUGHMAN
536

COUNTY SURVEYORS FILE DATA
DO NOT REMOVE FROM OFFICE

SURVEY FOR PROPERTY CORNERS IN SECTION 4, T.27S. R.7W.W.M.		
FOR: KENNETH BRAND	SCALE 1"=200'	DRAWN BY Eab / REVISED
BAUGHMAN TECHNICAL SERVICES INC.		
DATE MAY 1979	APPROVED BY	DRAWING NUMBER FM 6-71

MADE IN U.S.A.

MAP FILE M77-4