COUNTY SURVEYORS FILE DATA
DO NOT REMOVE FROM OFFICE

SURVEY FOR LARRY OWENS

LOTS 19 & 21, MENNOS ADD'N TO SUTHERLIN — SEC. ~~19~~ 20, T25S, R5W, W.M.

SURVEYED BY: HAROLD L. BALL

MAY, 1979 SCALE: 1" = 20'

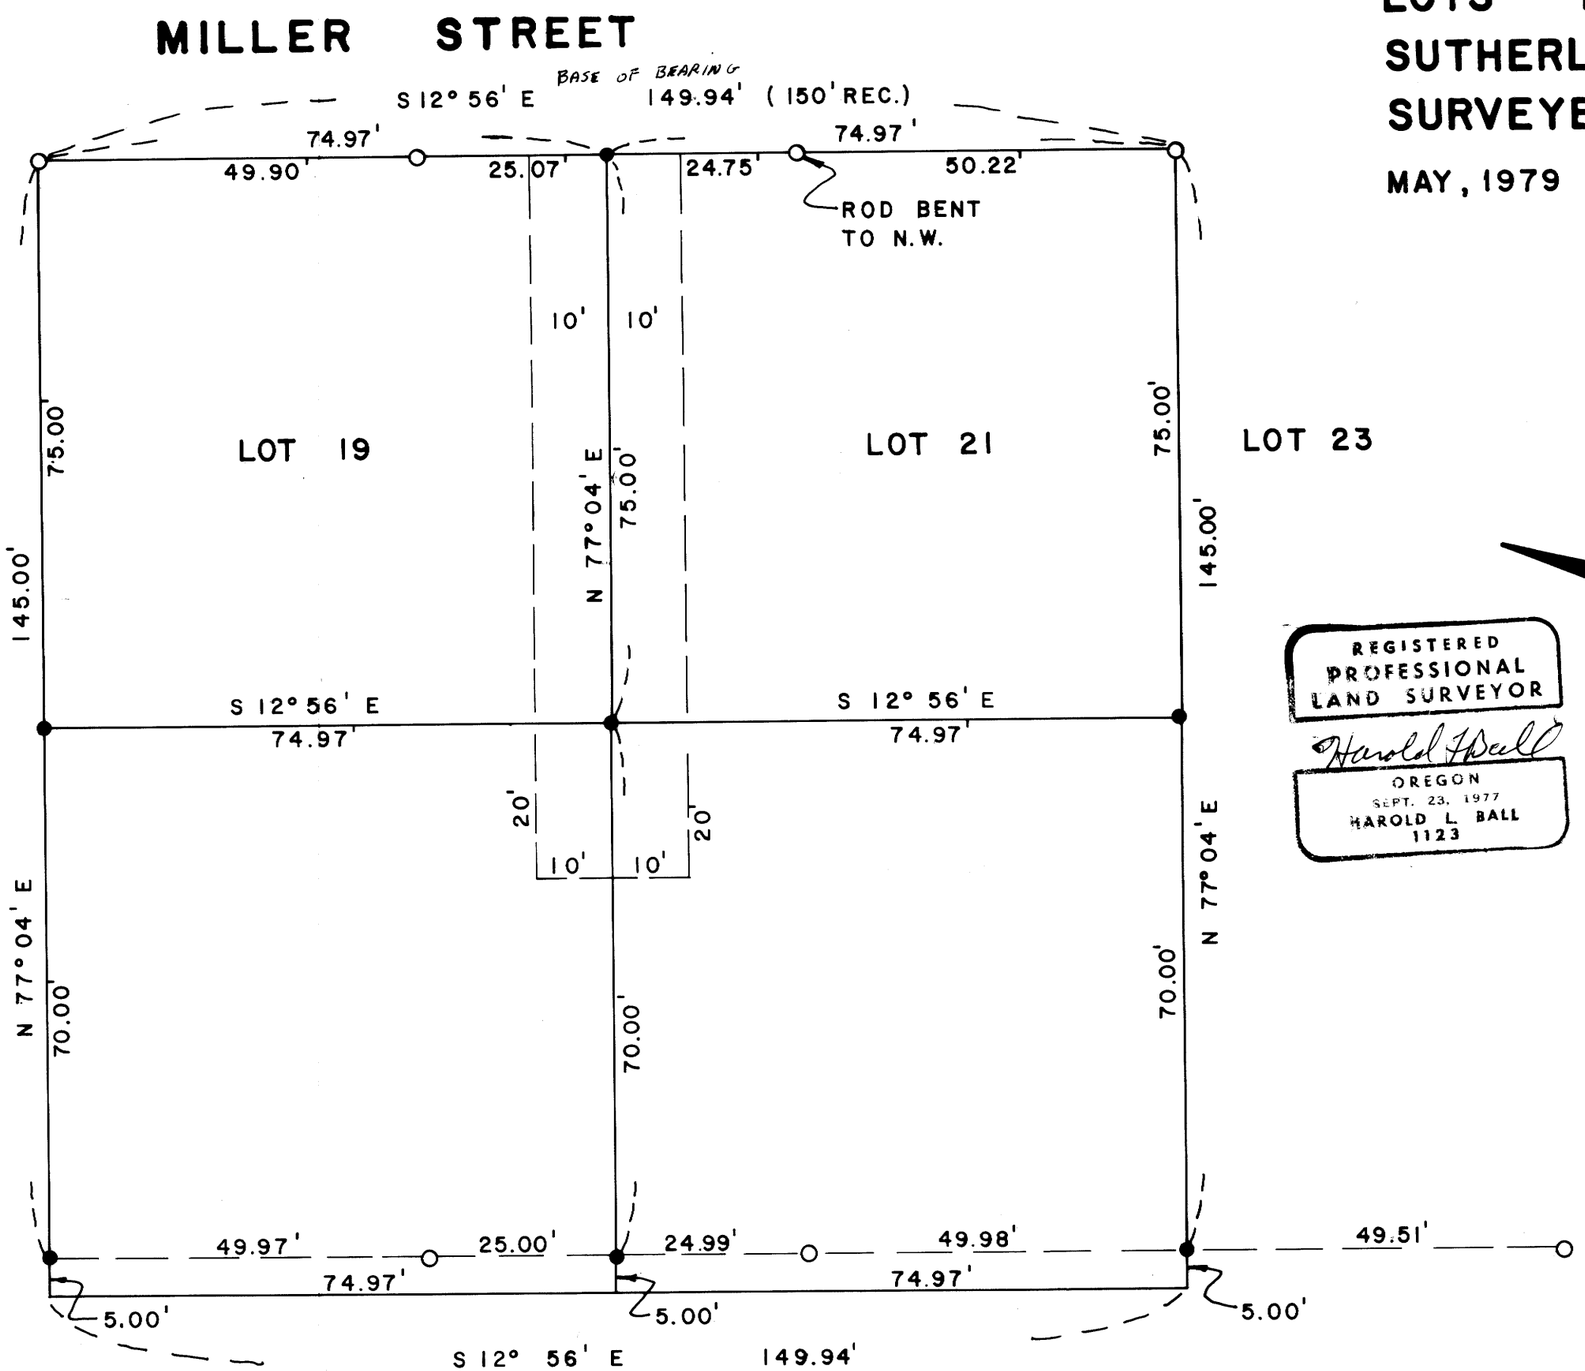

REGISTERED PROFESSIONAL LAND SURVEYOR
Harold L. Ball
OREGON
SEPT. 23, 1977
HAROLD L. BALL
1123

FILED
RECEIVED
MAY 30 1979
COUNTY SURVEYOR
DOUGLAS COUNTY, ORE.

MAP FILE M77-42

LEGEND

○ FD. 3/4" I.R.

● SET 5/8" I.R.

ROD BENT TO N.W.

MAP FILE M77-42