LAND SURVEY PLAT

LOTS 11 and 12, BLOCK 17 and LOT 6, BLOCK 18
CITY of GLENDALE, DOUGLAS COUNTY, OREGON.

MAY 7, 1979 T. 33 S. R. 6 W., W.M. SEC. 5

SURVEY FOR:
John H. Shepherd and Ken Miller
457 S.W. "H" St. Second and Willis
Grants Pass, Ore. 97526 Glendale, Ore.

SURVEY BY:
Ronald A. Brandt, P.S. 841
P.O. Box 427
Glendale, Ore. 97442

PURPOSE: TO SURVEY PREVIOUS DIVISION, LOTS 11 and 12, BLK. 17 AND SURVEY OF TWO LINES, LOT 6, BLK. 18.

PROCEDURE: TRAVERSE TIES AND CALCULATIONS TO EXISTING KNOWN CORNERS WITH THEODOLITE AND 300' TAPE.

REFERENCES: COUNTY SURVEY FILES C.S. 58/128, M 71-48 = basis-of-bearing.
ALSO M 22-40 and C.S. 49/147.

PARENTHESIS: ( ) MEANS OF RECORD.

SCALE: 1 in. = 100 ft.

MONUMENTS:

FOUND ----- o = as indicated.
SET - - - - — • = 5/8" x 32" I. Rod, 2" high or indicated.
⊙ = 1" x 32" I. Rod, flush or indicated.

REGISTERED
PROFESSIONAL
LAND SURVEYOR
Ronald A. Brandt
OREGON
JULY 12, 1968
RONALD A. BRANDT
841

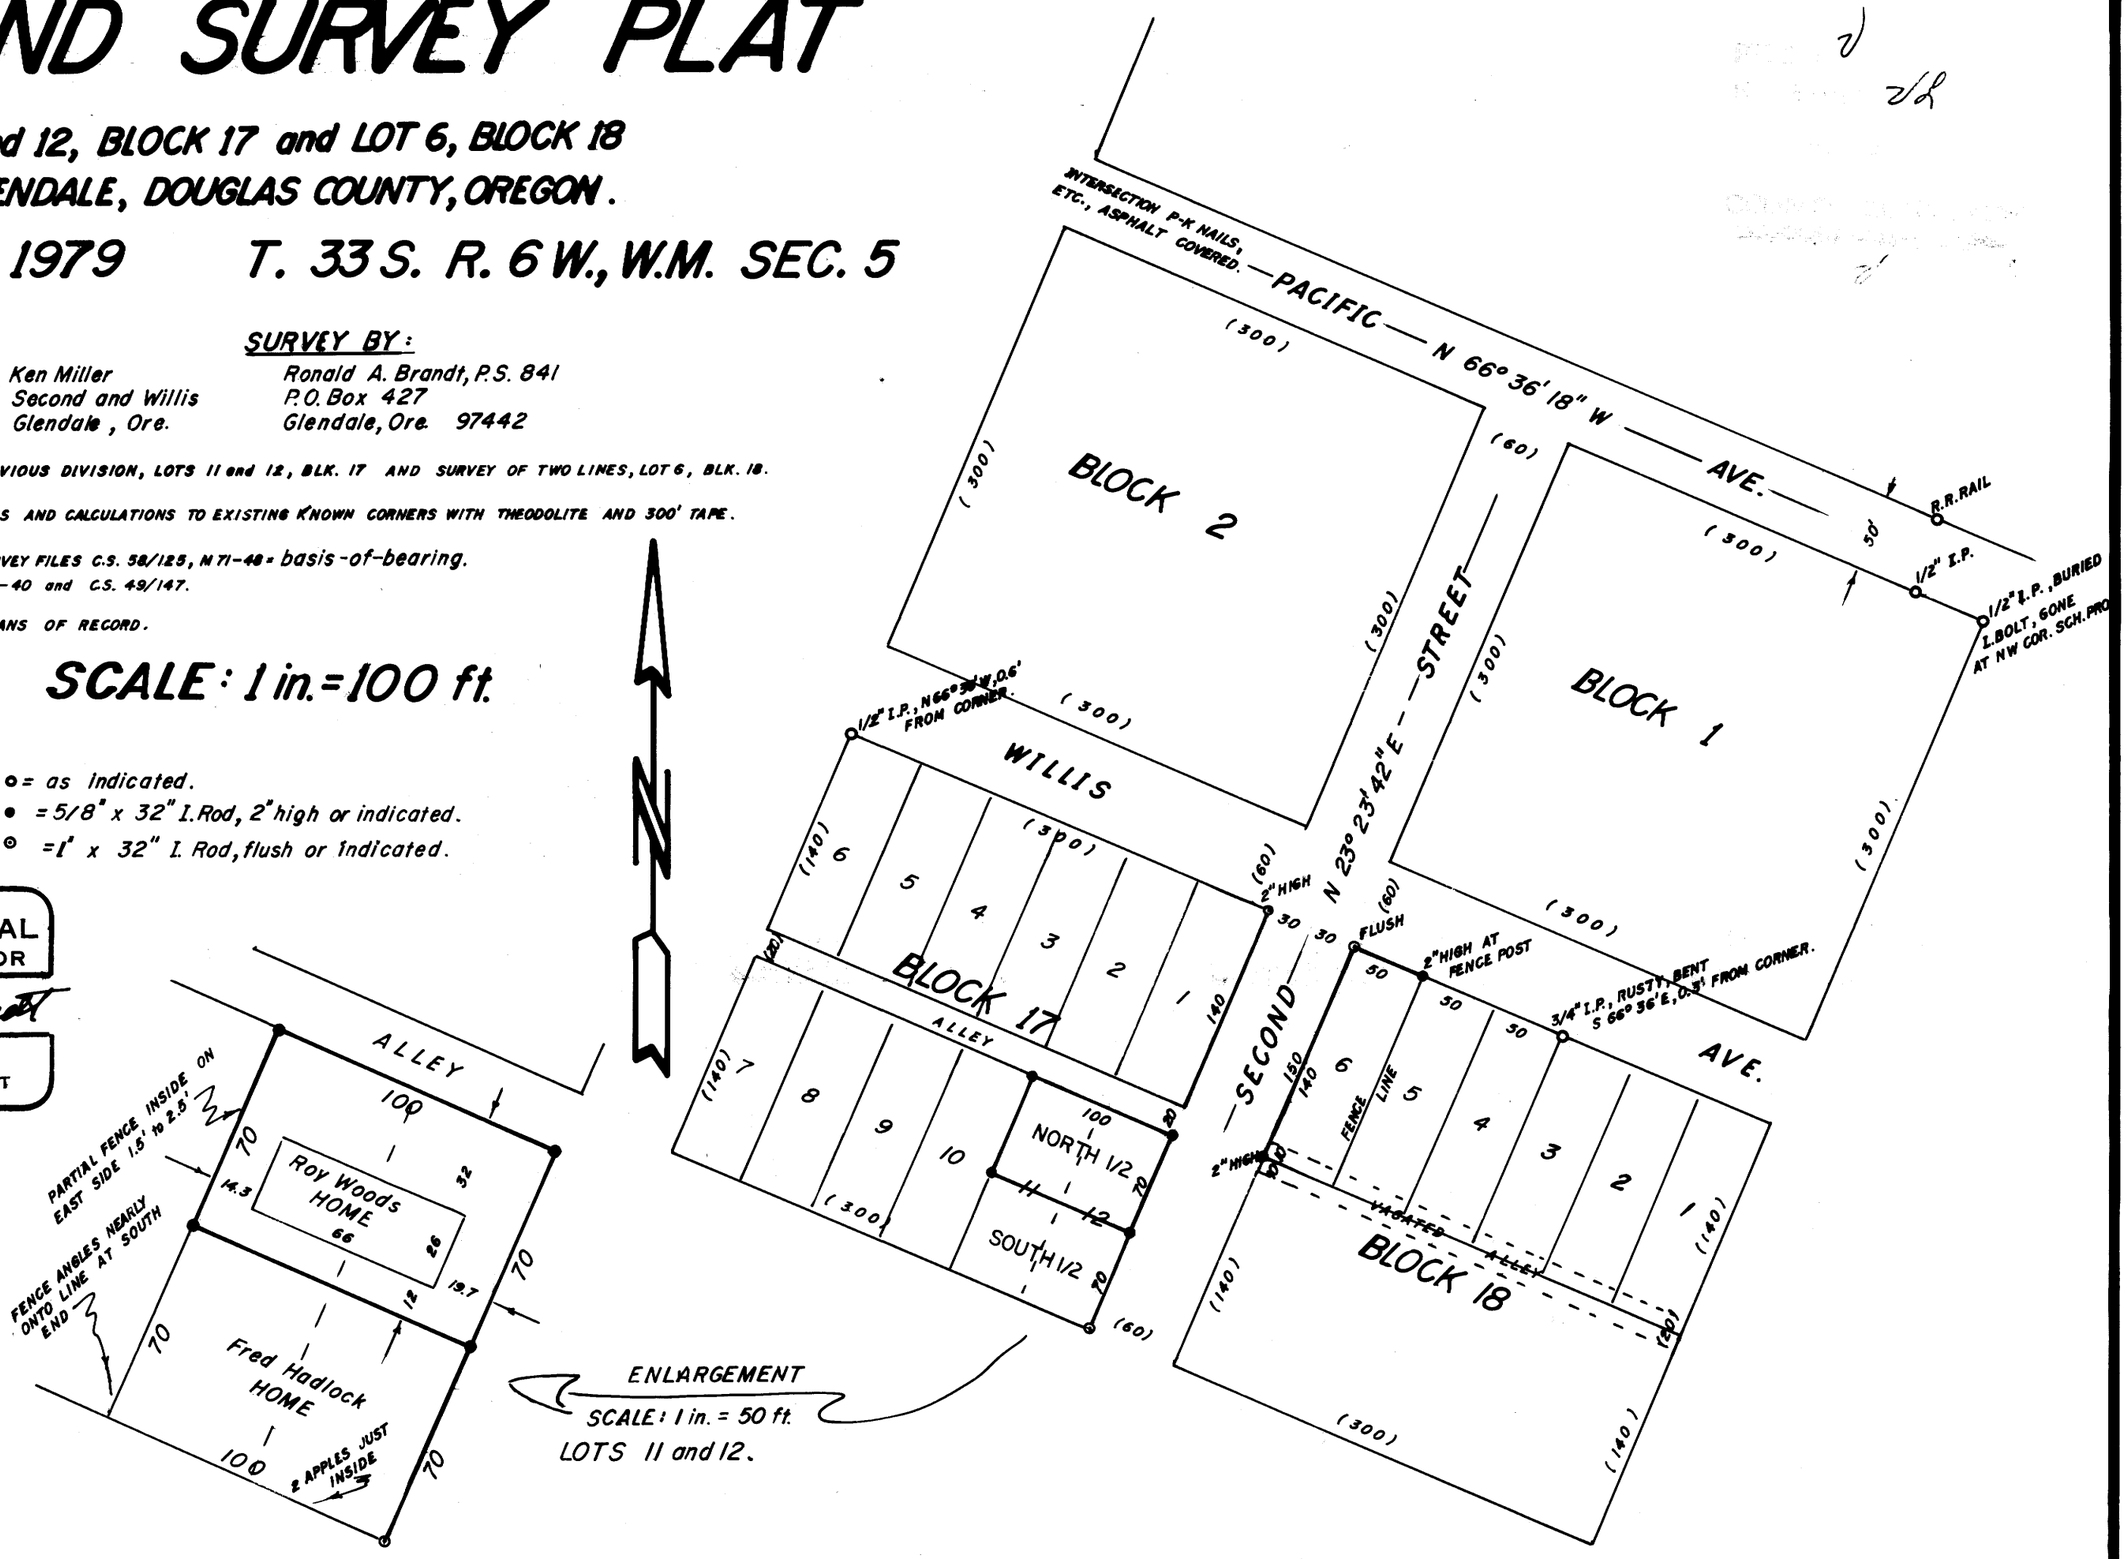

COUNTY SURVEYORS FILE DATA
DO NOT REMOVE FROM OFFICE

M 77-5