MAP FILE M 77-68

MAP FILE M 77-68

SURVEYORS FILE DATA
DO NOT REMOVE FROM OFFICE

SURVEY TO SET LINE MONUMENTS IN SEC. 8, T29S, R7W, W.M.

FOR: LYLE GILLETTE
BY: BHW ENG. & SURVEYING

JUNE, 1979 SCALE 1"=100'

REGISTERED PROFESSIONAL LAND SURVEYOR
Romanso E. Ware
OREGON
NOV. 16, 1973
ROMANSO E. WARE
1005

FILED
RECEIVED DK
JUN 26 1979
COUNTY SURVEYOR
DOUGLAS COUNTY, ORE.

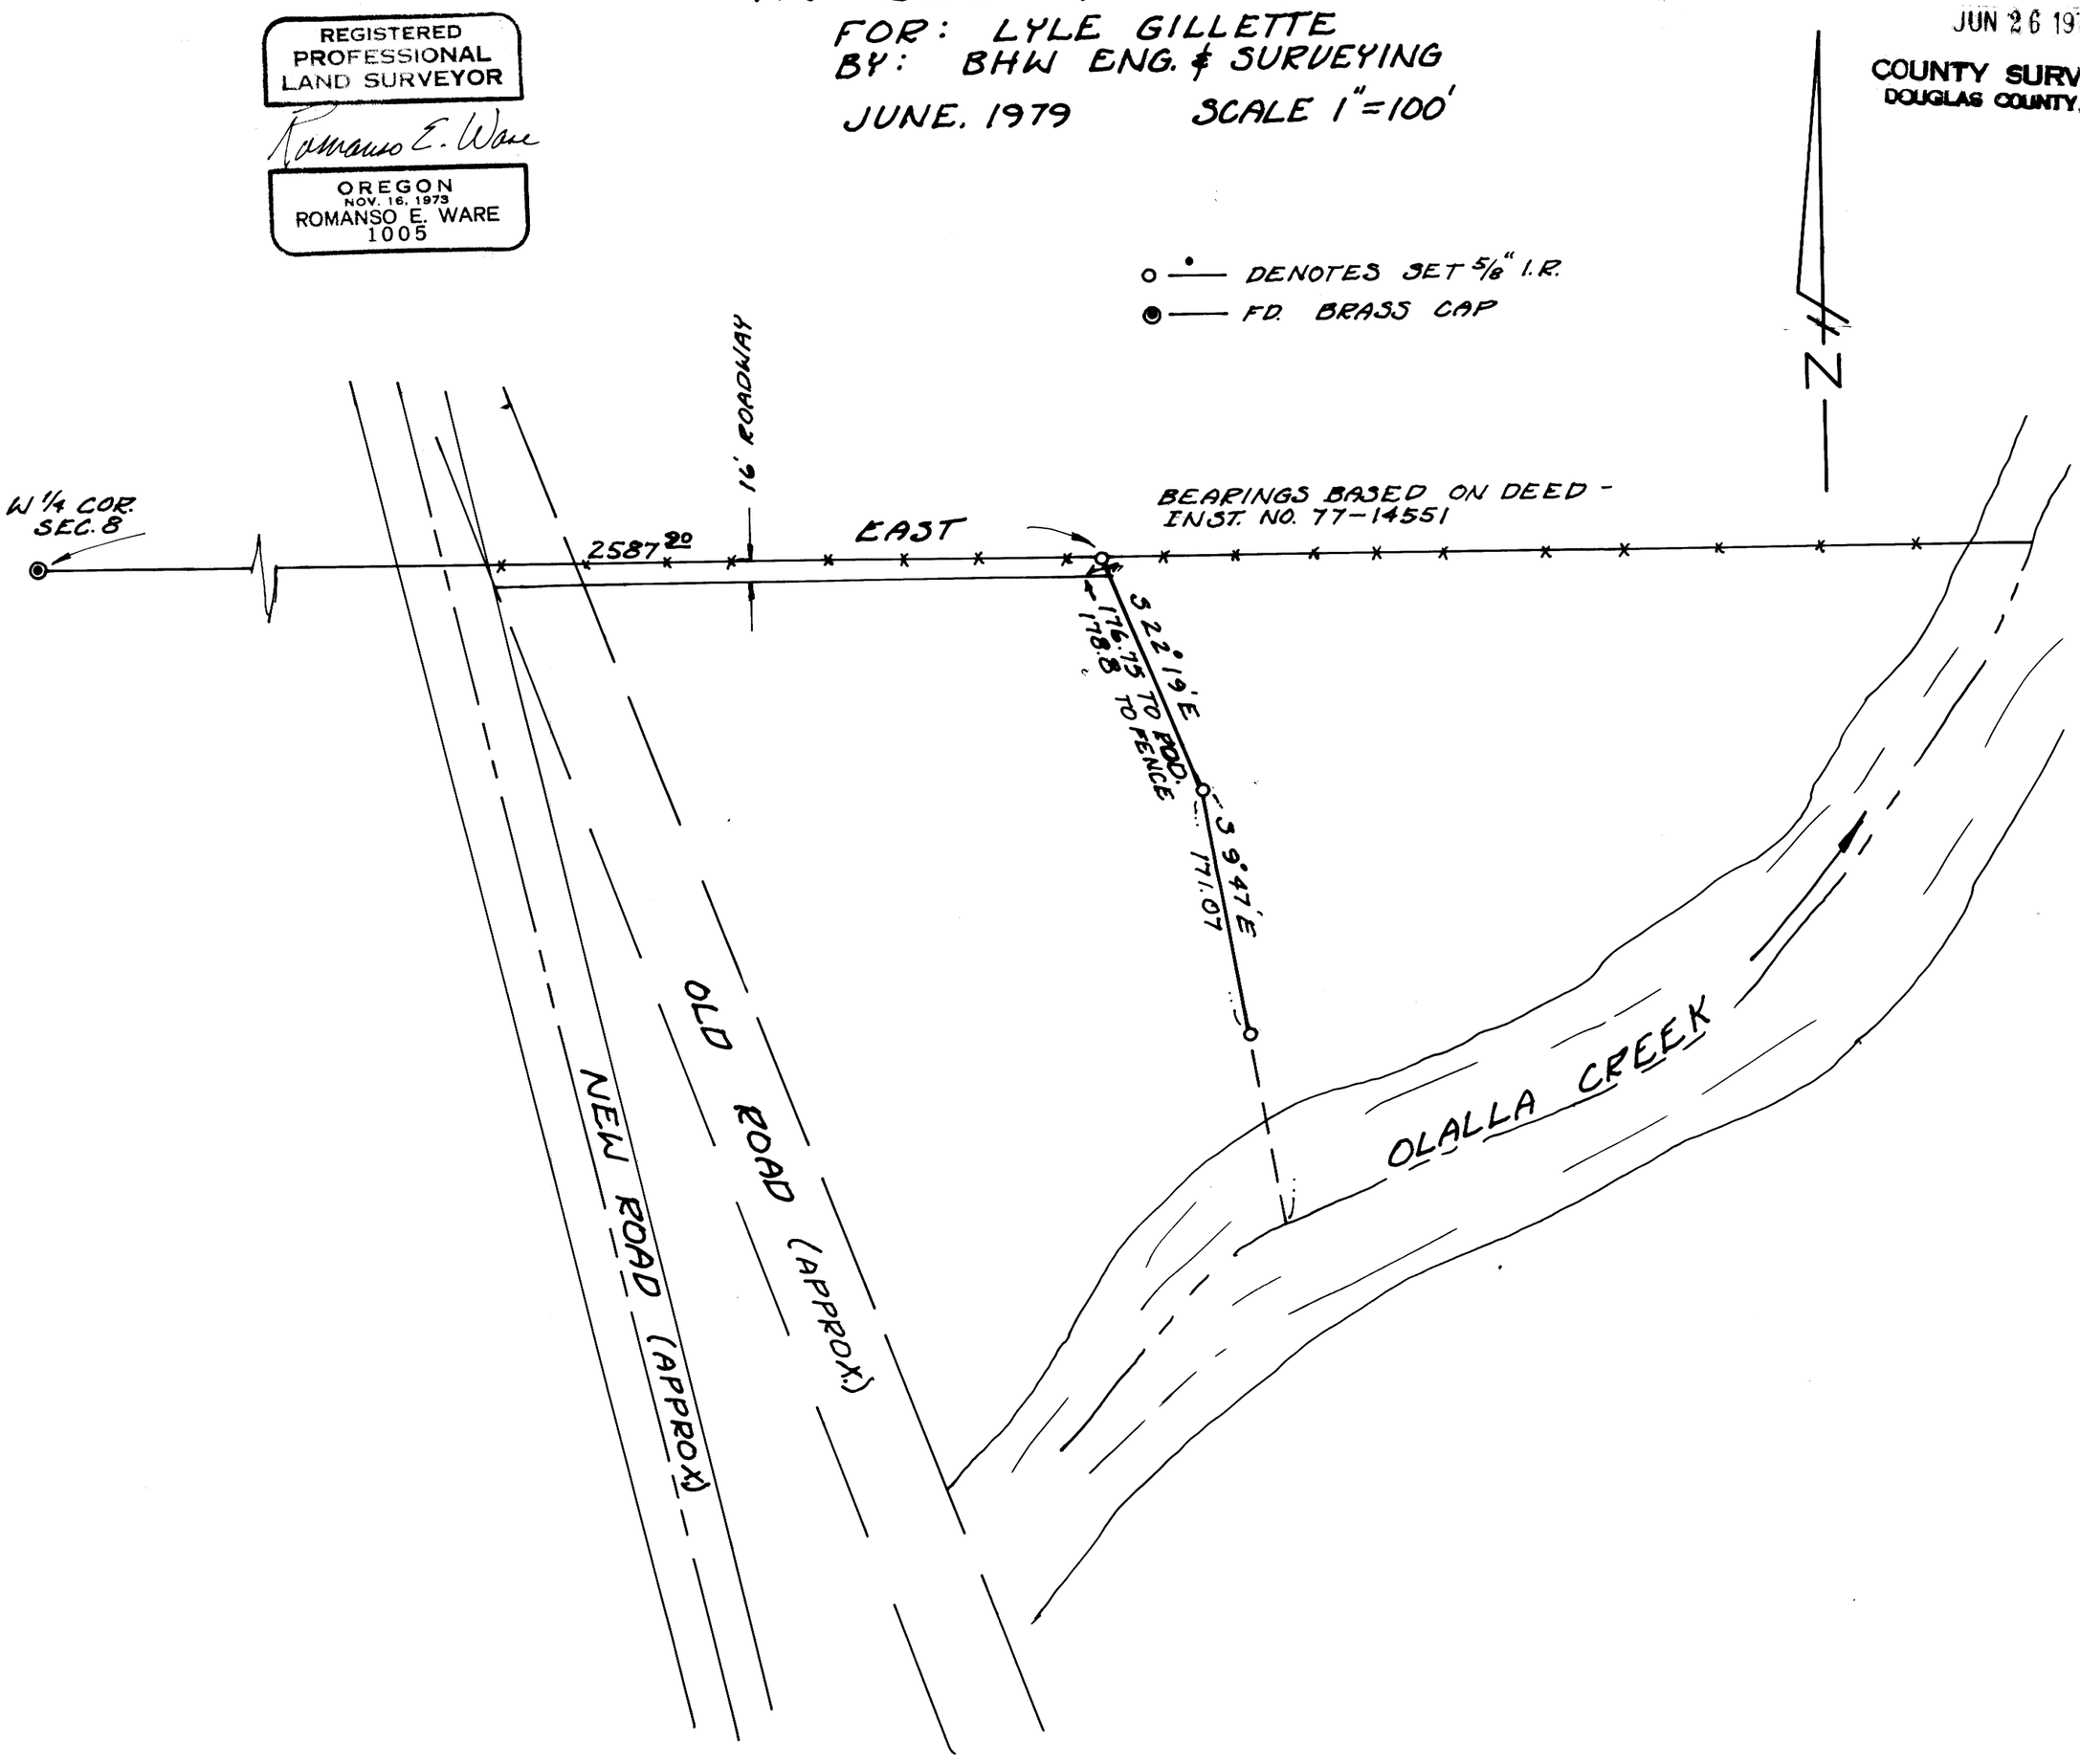

MAP FILE M 77-68

MAP FILE M 77-68