COUNTY SURVEYORS FILE DATA
DO NOT REMOVE FROM OFFICE

SURVEY OF PARCELS IN SEC. 36., T 28S., R.8 W., W.M., DOUGLAS CO., ORE.

JUNE 1979 SCALE 1" = 100'

FOR - ED. DWIGHT
GARY DAHL
L.D. LOCKWOOD
BY HERBERT L NORTHCRAFT

FILED
RECEIVED
JUN 28 1979
COUNTY SURVEYOR
DOUGLAS COUNTY, ORE.
JB

MAP FILE M 77-77

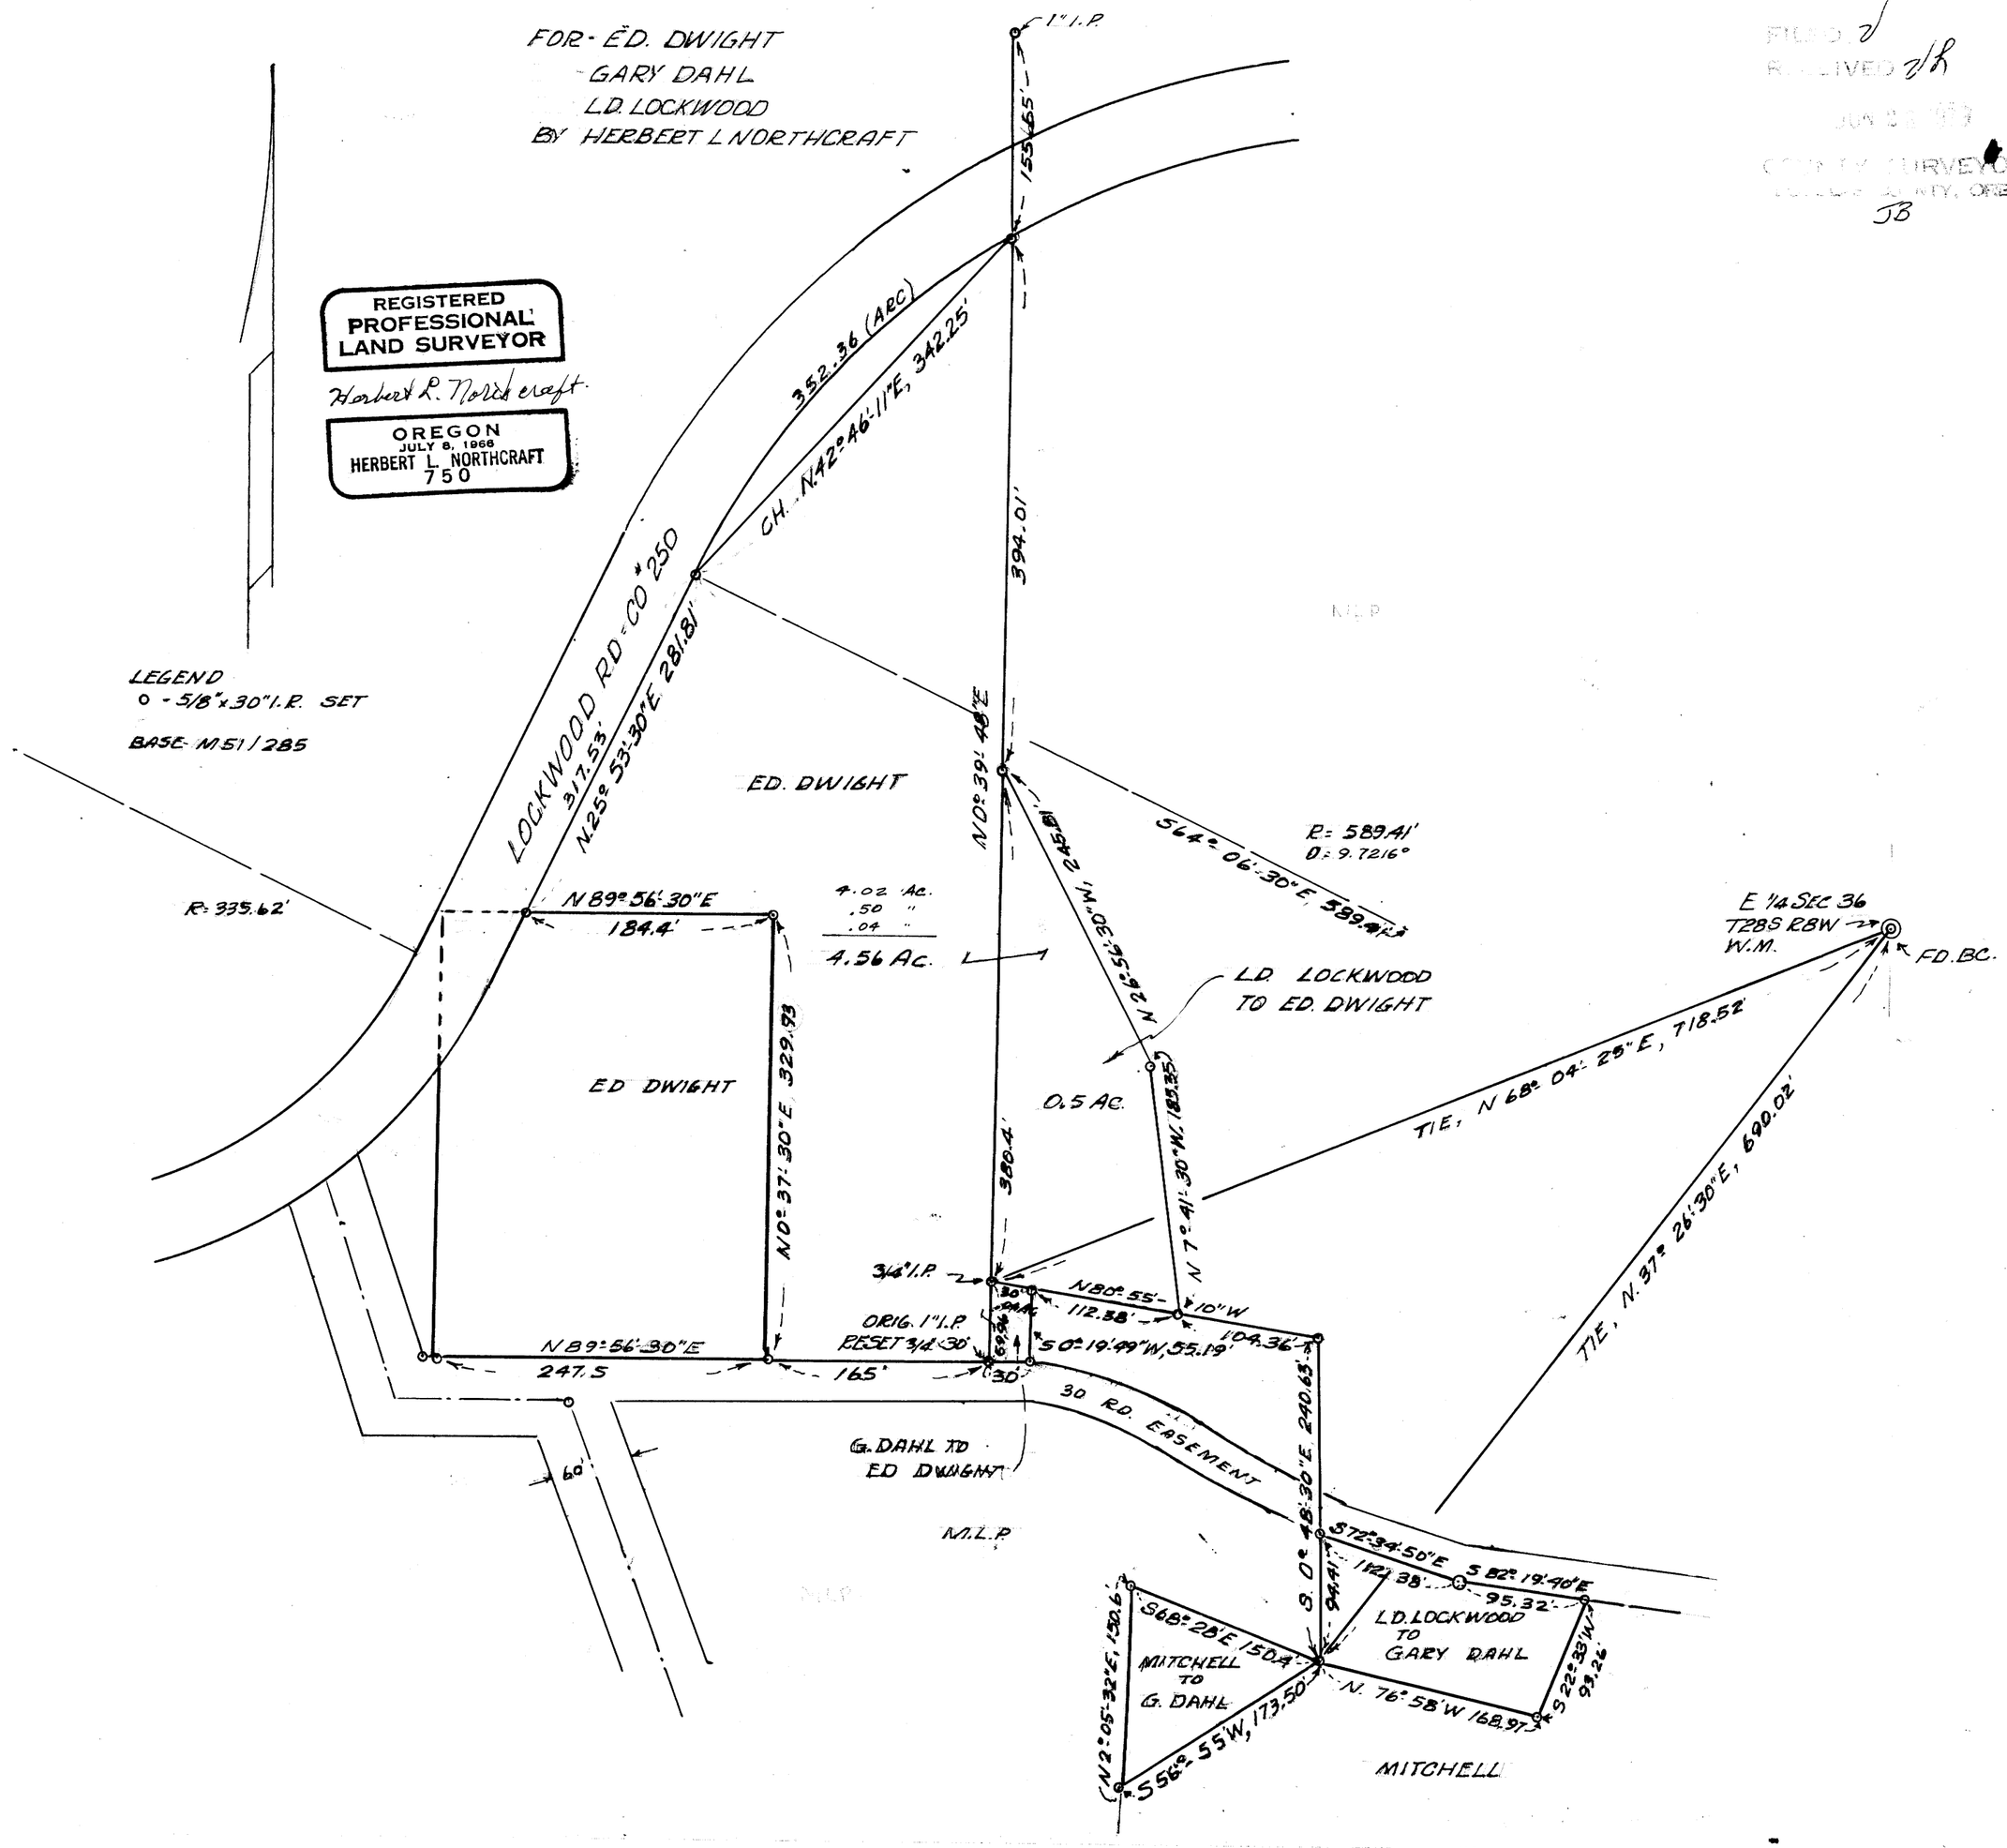

MAP FILE M 77-77