FILED
RECEIVED
SEP 11 1979
COUNTY SURVEYOR
DOUGLAS COUNTY, ORE.

MAP FILE M 78-68

SURVEY OF PART OF DEED DESCRIPTION

for

Donald C. Reed

Section 13 T.32 S. R.5W. W.M.

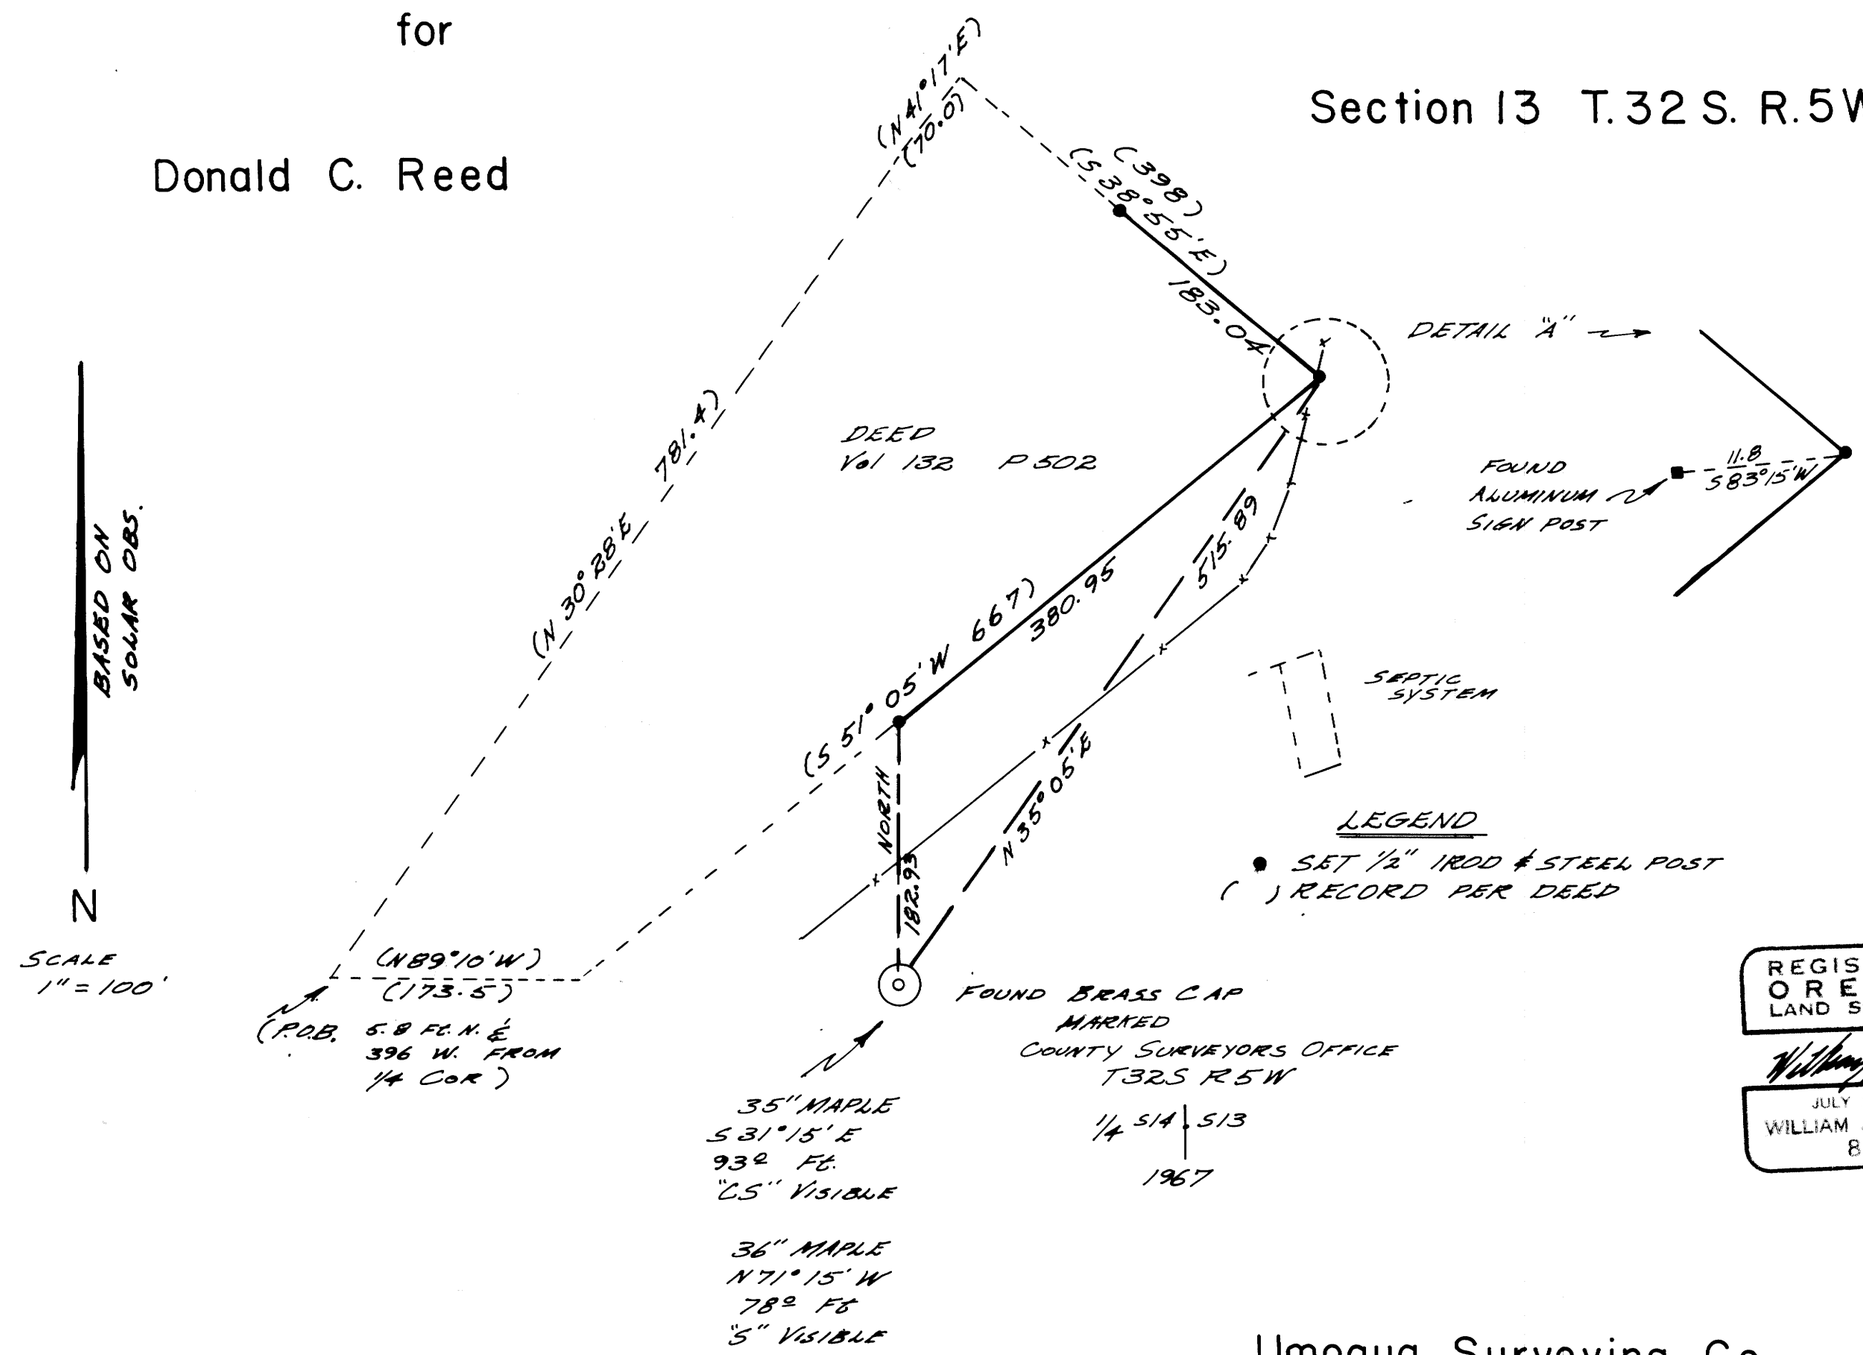

REGISTERED
OREGON
LAND SURVEYOR
JULY 12, 1968
WILLIAM J. RUPPERT
866

Umpqua Surveying Co.
Myrtle Creek, Or.
AUG. 1979

COUNTY SURVEYORS FILE DATA
DO NOT REMOVE FROM OFFICE

MAP FILE M 78-68