MAP FILE M78-73

COUNTY SURVEYORS FILE DATA
DO NOT REMOVE FROM OFFICE

FILED
RECEIVED
SEP 11 1979
COUNTY SURVEYOR
DOUGLAS COUNTY, ORE.

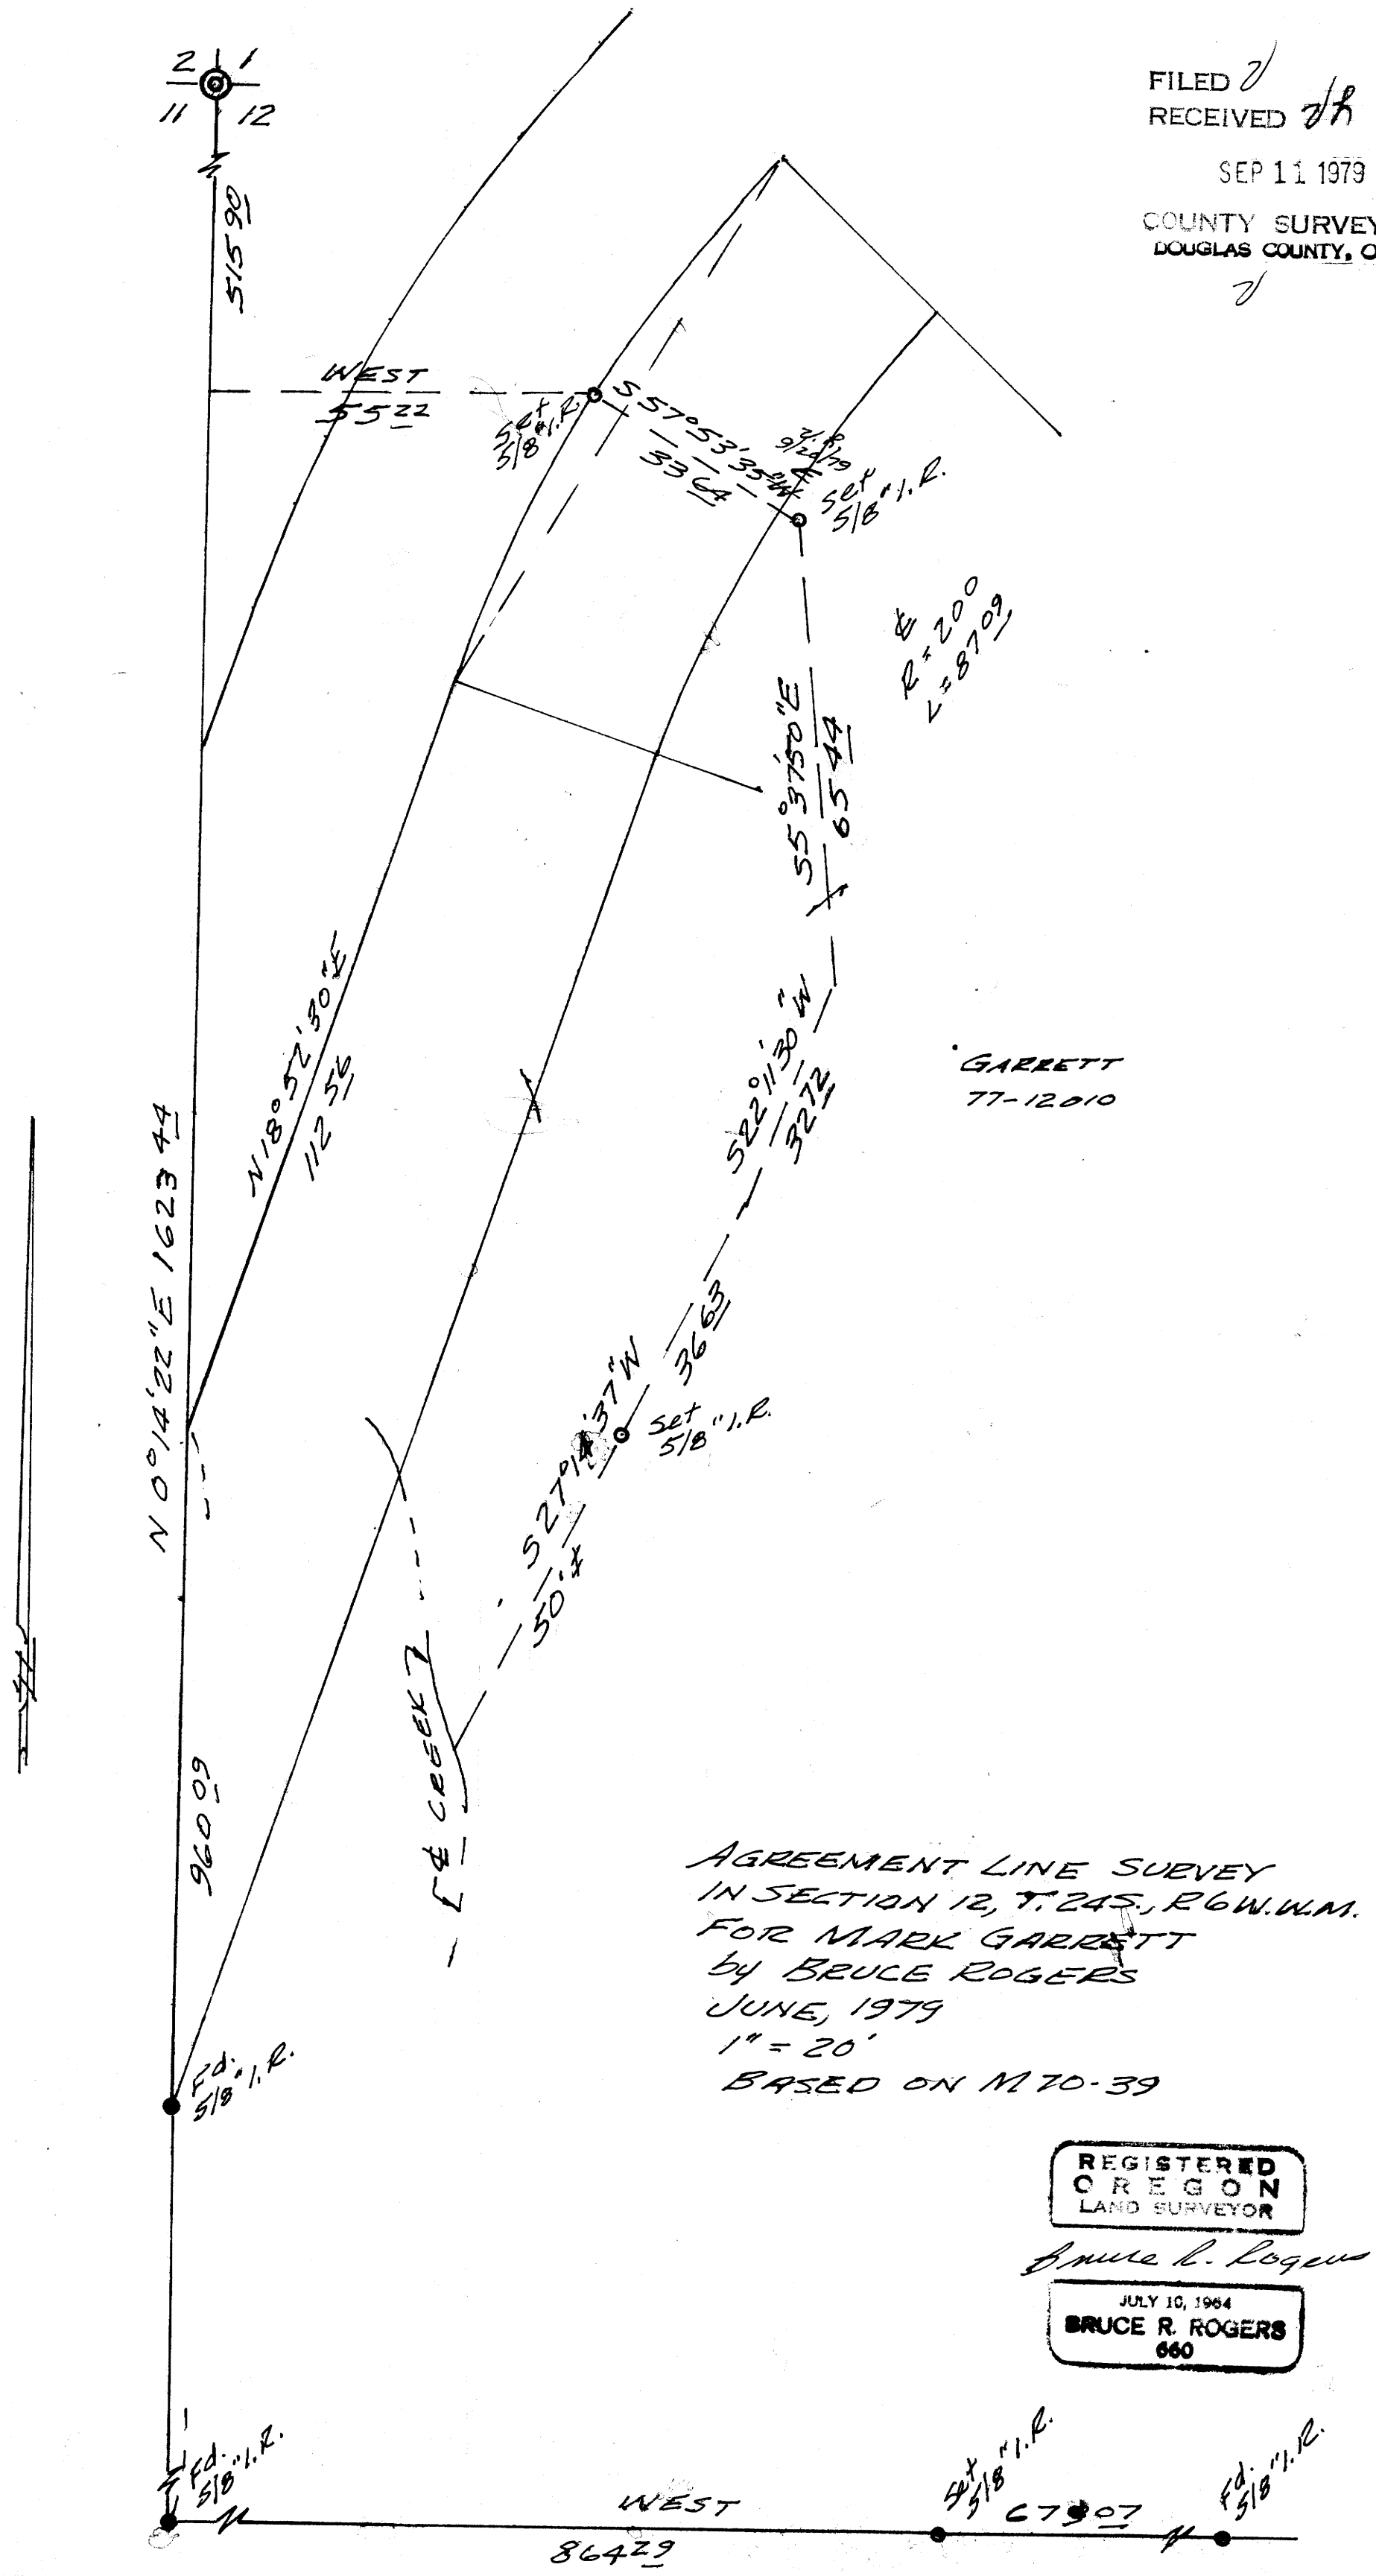

AGREEMENT LINE SURVEY
IN SECTION 12, T. 24S., R6W. W.M.
FOR MARK GARRETT
by BRUCE ROGERS
JUNE, 1979
1" = 20'
BASED ON M70-39

REGISTERED
OREGON
LAND SURVEYOR

Bruce R. Rogers

JULY 10, 1964
BRUCE R. ROGERS
660

MAP FILE M78-73