COUNTY SURVEYORS FILE DATA
DO NOT REMOVE FROM OFFICE

FILED
RECEIVED
JAN 28 1980
COUNTY SURVEYOR
DOUGLAS COUNTY, ORE.

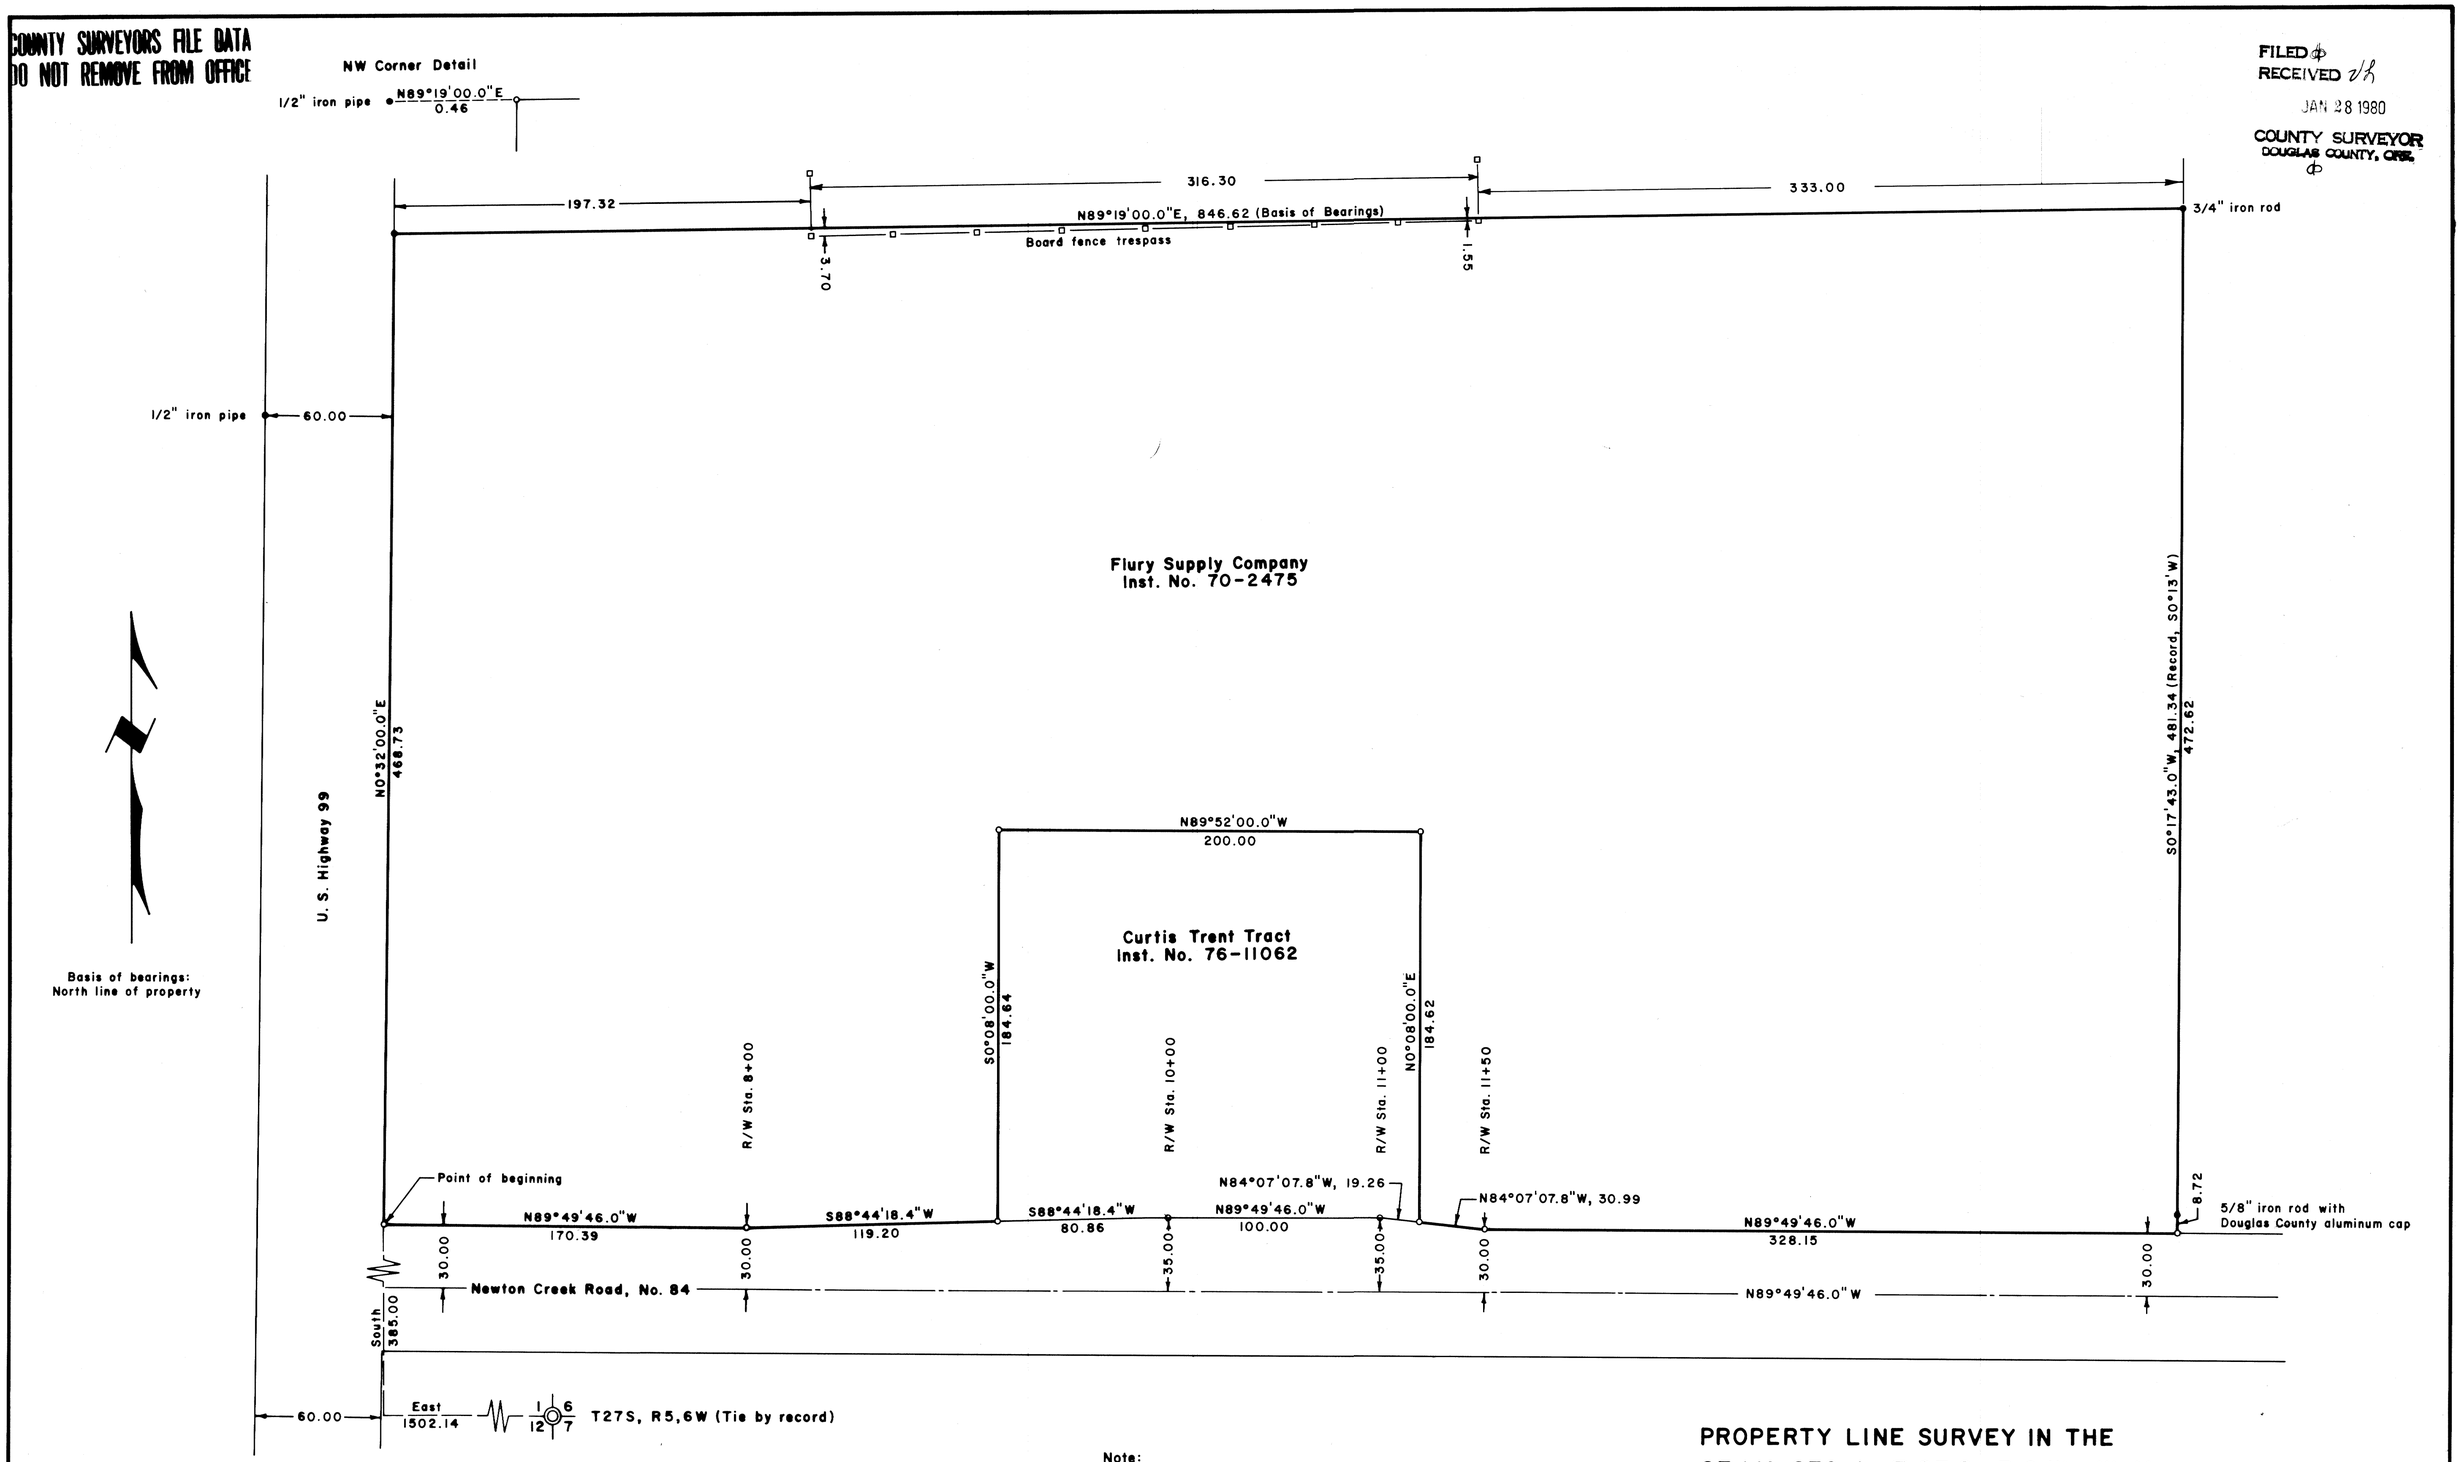


**LEGEND**

Corner found (as noted) •

Corner set (5/8" iron rod with aluminum cap) ○

Corner computed (not set) •

40 0 40 80

Scale: 1" = 40'

Note:

Refer to the following surveys in the County Surveyor's Map File:
CS File 51/253
CS File 40/300
CS File 55/31
and Newton Creek Road No. 84 Plan and Profile by the Douglas County Road Dept., September, 1969.

REGISTERED PROFESSIONAL LAND SURVEYOR
B A Shaner
OREGON
OCT. 4, 1967
BRUCE A SHANER
430

# PROPERTY LINE SURVEY IN THE SE 1/4 SEC. 1, T 27 S, R 6 W., W. M., DOUGLAS COUNTY, OREGON

For: Flury Supply Company
P. O. Box 490
Roseburg, Oregon 97470

By: Shaner Engineering, Inc.
P. O. Box 1430
Roseburg, Oregon 97470

January 25, 1980

COUNTY SURVEYORS FILE DATA
DO NOT REMOVE FROM OFFICE

MAP FILE M79-17