COUNTY SURVEYORS FILE DATA
DO NOT REMOVE FROM OFFICE

FILED ϕ
RECEIVED ϕ
APR 18 1980
COUNTY SURVEYOR
DOUGLAS COUNTY, ORE.

MAP FILE M79-34

SURVEY TO SET CORNERS IN THE N1/2 SEC. 35 T30S, R6W, W.M.

BY: BAUGHMAN TECH. SERV. FOR: RALPH HUFFMAN MARCH 1980

SCALE: 1" = 100'

REGISTERED PROFESSIONAL LAND SURVEYOR
OREGON
GEORGE E. GIBBS
397

LEGEND
- FOUND 5/8" IRON ROD
- SET 5/8" IRON ROD
- FOUND BRASS CAP
- SET BRASS CAP
- SET STEEL FENCE POST
- EXISTING FENCES

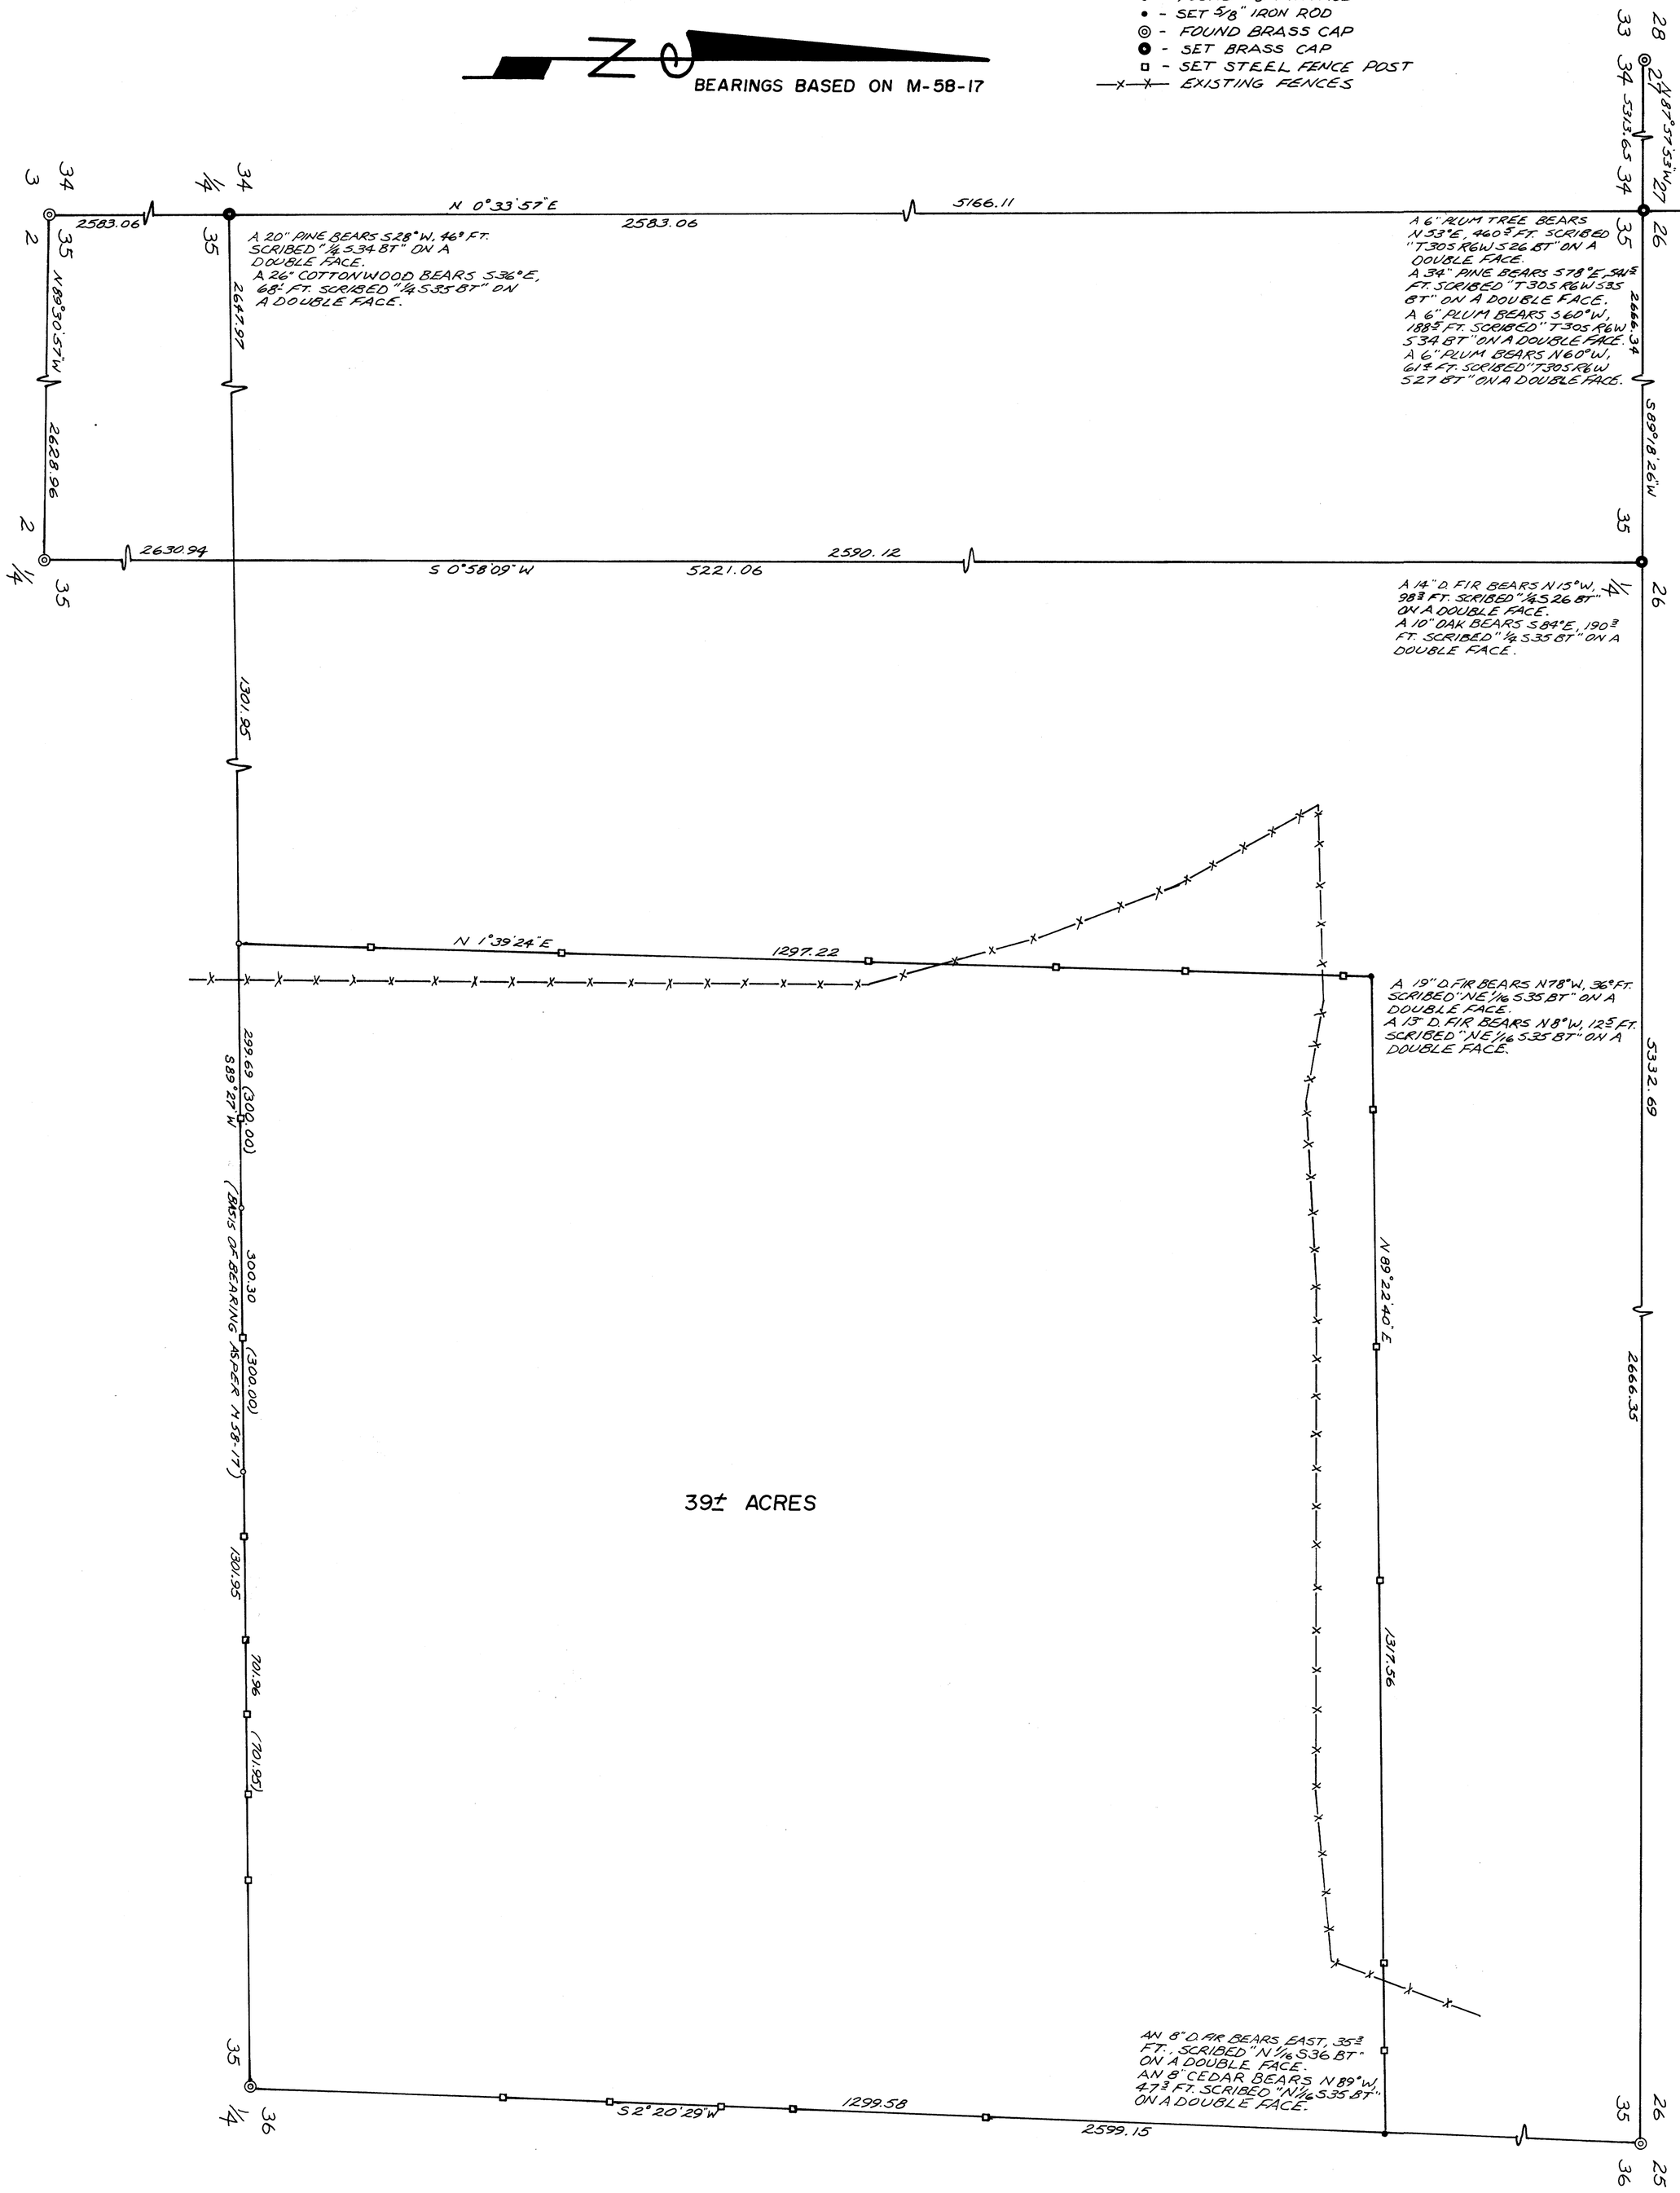

NARRATIVE:

The purpose of this survey was to monument the corners and post true line on the boundary of the Southeast ¼ of the Northeast ¼ of Section 35, T. 30 S., R. 6 W., W.M.

COUNTY SURVEYORS FILE DATA
DO NOT REMOVE FROM OFFICE

MAP FILE M 79-34