MAP FILE M-79-34

COUNTY SURVEYORS FILE DATA
DO NOT REMOVE FROM OFFICE

FILED
RECEIVED
APR 24 1980
COUNTY SURVEYOR
DOUGLAS COUNTY, ORE.

SURVEY IN SE 1/4, SECTION 15, T27S, R5W, W.M.

For: Nordic Plywood, Inc. & Bob Carrico

By: BHW Engineering & Surveying, Inc.

APRIL 15, 1980 SCALE: 1" = 100'

NARRATIVE:

SURVEY FOR PURPOSE TO TRANSFER PARCELS SHOWN TO ADJACENT OWNER TO THE SOUTH.

EQUIPMENT USED:
WILD T-1 THEODOLITE AND RED-1 E.D.M.

REGISTERED PROFESSIONAL LAND SURVEYOR
Romanso E. Ware
OREGON
ROMANSO E. WARE
1005

BHW ENGINEERING & SURVEYING, INC.
1205 S.E. Court St.
Roseburg, Oregon 97470

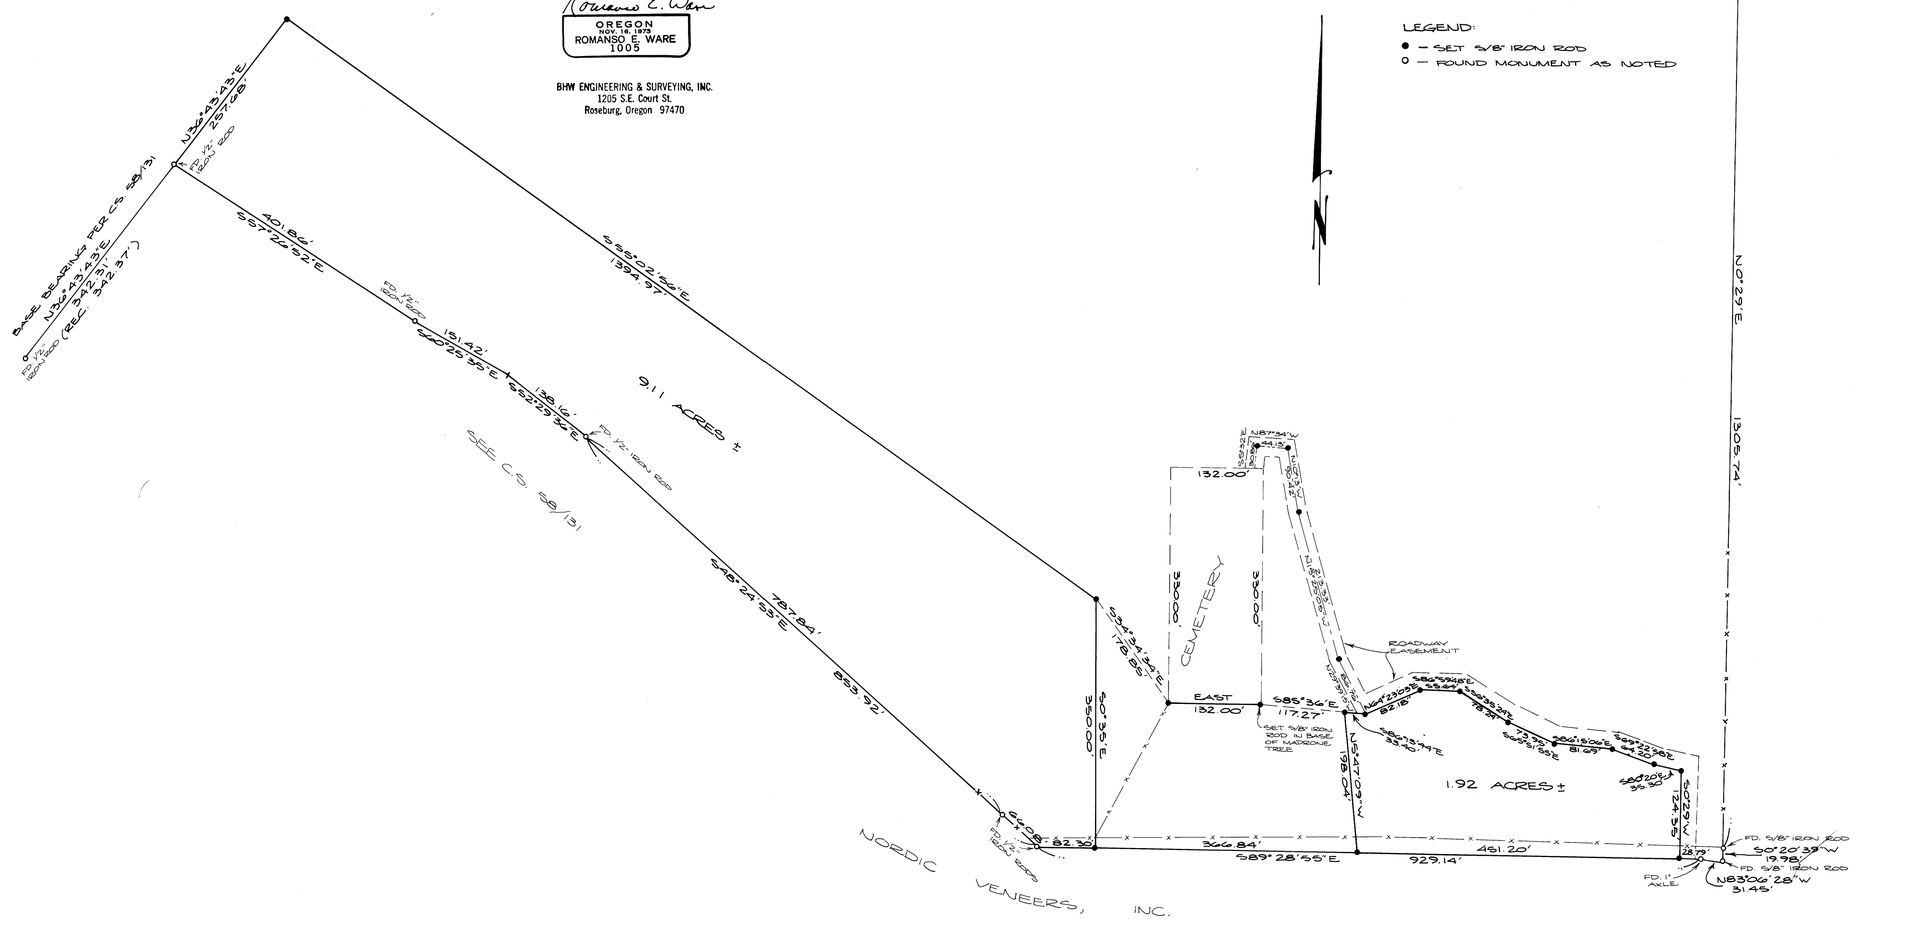

COUNTY SURVEYORS FILE DATA
DO NOT REMOVE FROM OFFICE

MAP FILE M-79-34