COUNTY SURVEYORS FILE DATA
DO NOT REMOVE FROM OFFICE

FILED
RECEIVED
JUN 13 1980
COUNTY SURVEYOR
DOUGLAS COUNTY, ORE.

SURVEY FOR U.S. FOREST SERVICE

SECTION 35, TOWNSHIP 27 SOUTH, RANGE 2 WEST, WILLAMETTE MERIDIAN

MAY 1980

FEET

METERS

SCALE: 1" = 400'

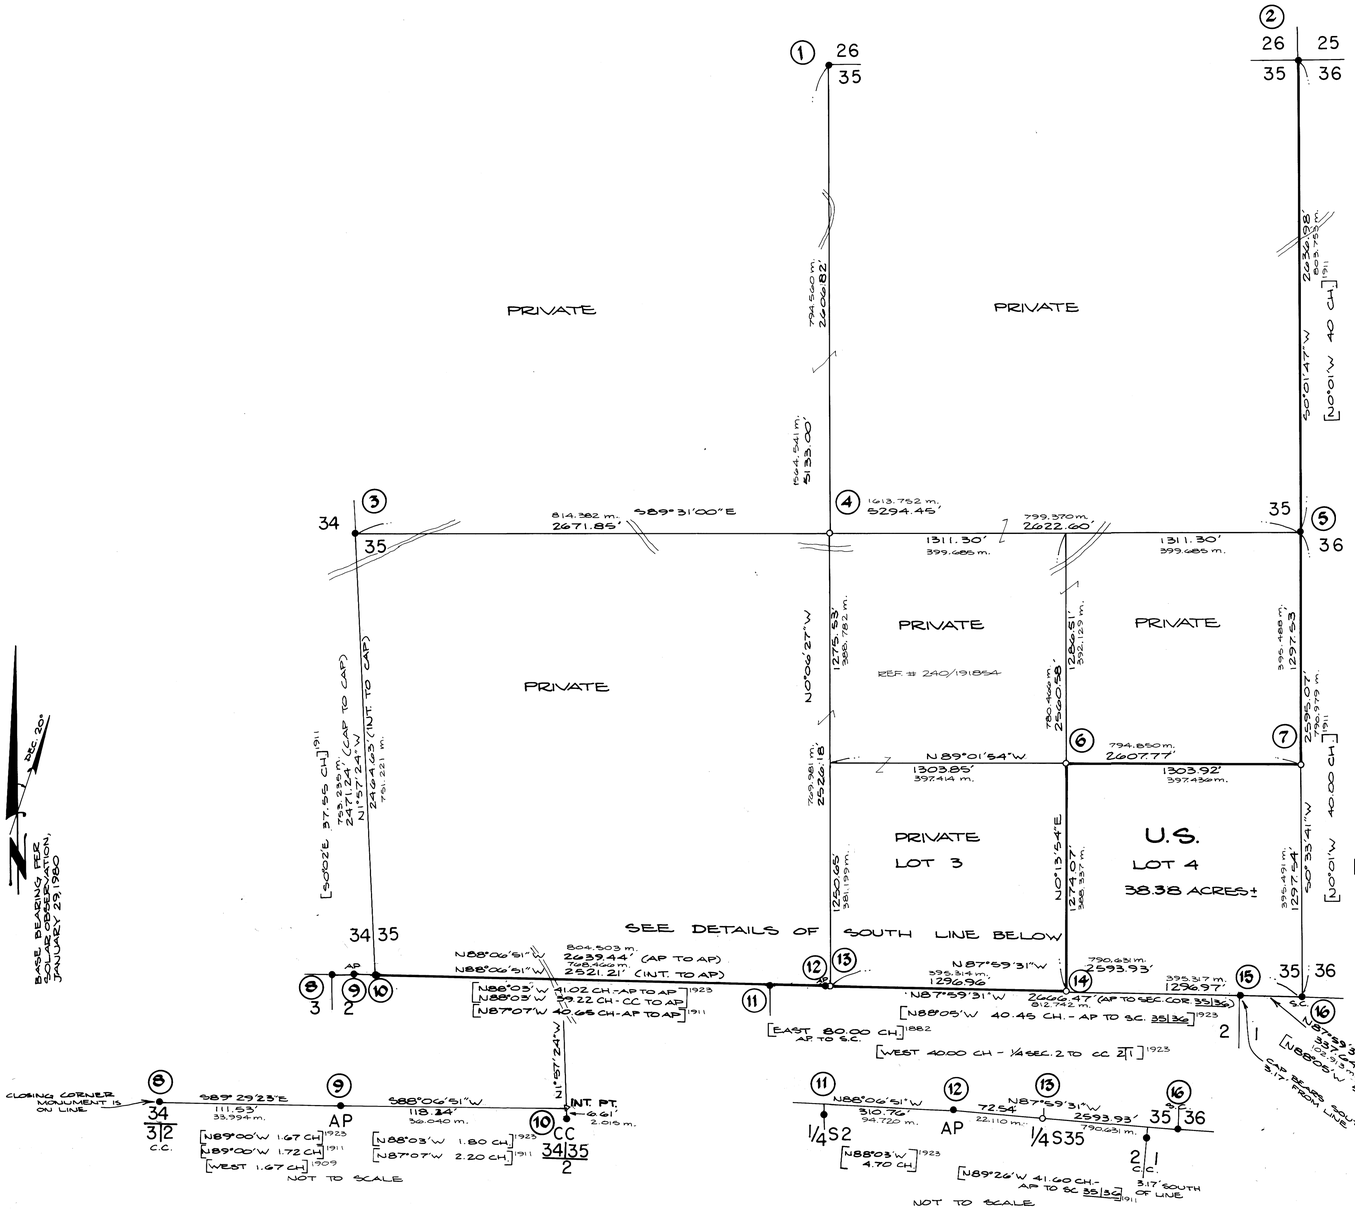

(1) FOUND 1" IRON PIPE WITH ALUMINUM CAP (MARKED AS SHOWN) FROM WHICH BEARS:
16" YEW S45°W 5.8'
14" YEW (VIS. SCRIBES) N75°E 27.3' (VIS. SCRIBES)
SET POST & SIGN 3.0' WEST

(2) FOUND 1½" IRON PIPE WITH BRASS CAP (MARKED AS SHOWN) FROM WHICH BEARS:
27" FIR STUMP S44°W 6.4'
24" FIR STUMP N18°E 11.6' (VIS. SCRIBES)
18" YEW S60°E 2.7' (VIS. SCRIBES)
36" FIR STUMP N60°W 20.5' (VIS. SCRIBES)
FD. METAL POST 1' NORTH OF CORNER
SCRIBED NEW B.T.'S:
8" FIR N89°W 52.2' "T27S R2W S26 B.T."
14" HEMLOCK N4°W 39.6' "T27S R2W S26 B.T."
NO OTHER TREES AVAILABLE.
BRASS WASHERS MARKED RLS # 1654 SET IN B.T. FACES

(3) FOUND 1½" IRON PIPE WITH 3" ALUMINUM CAP (MARKED AS SHOWN) FROM WHICH BEARS:
58" FIR STUMP WITH A BRIDGE SPIKE DRIVEN IN CENTER STAMPED # 34 BEARS N17°W 54.4'
28" HEMLOCK STUMP S54¾°W 41.0'
BOTH SHOW SCARS
FOUND IRON POST 0.5' NORTH.

(4) SET 2½" IRON PIPE WITH BRASS CAP (MARKED AS SHOWN) FROM WHICH BEARS:
SCRIBED NEW B.T.'S:
14" CEDAR S7°W 17.1' "C¼ S35 B.T."
10" HEMLOCK S17°W 17.7' "C¼ S35 B.T."
SET POST & SIGN 4.0' NORTH
BRASS WASHER MARKED RLS #1005 SET IN B.T. FACES

(5) FOUND 1½" IRON PIPE WITH BRASS CAP (MARKED AS SHOWN) FROM WHICH BEARS:
14" HEMLOCK S63°E 13.3'
18" YEW S60°E 11.9' (VIS. SCRIBES)
FOUND 3"x3" WOOD POST 1.0' EAST
SCRIBED NEW B.T.:
20" YEW S70°W 15.5'
¼ S35 B.T."
BRASS WASHER MARKED RLS # 1005 SET IN B.T. FACE

(6) SET 2½" IRON PIPE WITH BRASS CAP (MARKED AS SHOWN) FROM WHICH BEARS:
14" D. FIR SNAG (TRUE CORNER) EAST 11.8' SCRIBED "SE¼ S35"
ON WEST SIDE
SCRIBED NEW B.T.'S:
12" W. FIR N38°W 10.7' "SE¼ S35 B.T."
12" W. FIR S38°E 10.7' "SE¼ S35 B.T."
BRASS WASHER MARKED RLS #1005 IN B.T. FACES
SET POST & SIGN 10.0' EAST
12" WHITE FIR BEARS S37°W 12.0' FROM TRUE CORNER
12" WHITE FIR BEARS N73°W 19.3' FROM TRUE CORNER
(THESE TREES ARE ALSO THE BEARING TREES NOTED ABOVE)

(7) SET 2½" IRON PIPE WITH BRASS CAP (MARKED AS SHOWN) FROM WHICH BEARS:
SCRIBED NEW B.T.'S:
15" HEMLOCK N64°E 18.6' "S¼ S35 B.T."
14" D. FIR N58°W 15.8' "S¼ S35 B.T."
SET POST & SIGN 4.0' WEST
BRASS WASHER MARKED RLS #1005 SET IN B.T. FACES

(8) FOUND ALUMINUM CAP ON ¾" IRON ROD (MARKED AS SHOWN) (NOT OF RECORD) FROM WHICH BEARS:
SCRIBED NEW B.T.'S:
8" FIR S74°E 9.9' "T28S R2W S2 B.T."
6" YEW S16°W 23.3' "T28S R2W S2 B.T."
8" CEDAR N28°W 30.9' S3 B.T."
"T27S R2W S34 B.T."
FD. 30" CEDAR STUMP N18°E 26.6' VIS. SCRIBES
FD. 11" CEDAR STUMP S50°E 56.6' VIS. SCRIBES ON DOWN TREE
SET POST & SIGN 2.7' WEST
BRASS WASHERS MARKED RLS # 1654 SET IN B.T. FACES

(9) FOUND ALUMINUM CAP ON ¾" IRON ROD (MARKED AS SHOWN) FROM WHICH BEARS:
10" YEW N14°E 19.0' (VIS. SCRIBES)
24" FIR STUMP DOWN NORTH 6.0' (VIS. SCRIBES)
12" W. FIR SNAG S81°E 53.4' (VIS. SCRIBES)
20" HEMLOCK STUMP UPROOT N77°E 40.1' (VIS. SCRIBES)
SCRIBED NEW B.T.:
8" FIR SOUTH 66.0' "AP S2 B.T."
BRASS WASHER MARKED RLS # 1654 SET IN B.T. FACE
SET POST & SIGN 3.0' EAST

(10) FOUND ALUMINUM CAP ON ¾" IRON ROD (MARKED AS SHOWN) FROM WHICH BEARS:
48" CEDAR STUMP S40°E 25.6' (VIS. SCRIBES)
12" CEDAR WAPE S8.
(VIS. SCRIBES)
16" FIR STUMP N60°W 22.7'
15" CEDAR SNAG S70°E 6.6'
30" CEDAR STUMP (ORIG. B.T.) N49°E 73' + 6.5" = 6.5' BOTTOM OF FACE
36" FIR N78°W 50.7' (ORIG. B.T.) SHOWS AVE. WORK
SCRIBED NEW B.T.'S:
11" YEW S76°E 20.7' "T28S R2W S2 B.T."
11" HEMLOCK N12°W 184.0' "T27S R2W S34 B.T."
BRASS WASHER MARKED RLS # 1005 SET IN B.T. FACES
SET POST & SIGN 6.6' NORTH

(11) FOUND 1" IRON PIPE WITH BRASS CAP (MARKED AS SHOWN) FROM WHICH BEARS:
14" YEW S16°W 15.5' (VIS. SCRIBES)
10" FIR S22½°W 25.1' (GOOD SCAR)
44" FIR SNAG S40°E 39.6' (VIS. SCRIBES)
SET POST & SIGN 2.0' NORTH

(12) FOUND BRASS CAP ON IRON PIPE (MARKED AS SHOWN) FROM WHICH BEARS:
32" HEMLOCK N67°E 13.9' (VIS. SCRIBES)
9" YEW - DEAD - BROKEN OFF 4' ABOVE GROUND N17°W 10.6' (VIS. SCRIBES)
54" D. FIR N11°W 13.2' (VIS. SCRIBES)
SET POST & SIGN 3.0' WEST

(13) SET 2½" IRON PIPE WITH BRASS CAP (MARKED AS SHOWN) FROM WHICH BEARS:
14" HEMLOCK (TRUE CORNER) 10.0' NORTH SCRIBED ¼ S35 ON NORTH SIDE.
SCRIBED NEW B.T.'S:
BRASS WASHER MARKED RLS # 1005 SET IN B.T. FACE.
14" HEMLOCK N41°E 25.1' ¼ S35 B.T."
BRASS WASHER MARKED RLS #1654 SET IN B.T. FACE
SET POST & SIGN 1.5' EAST OF TREE
SAME TREE
18" HEMLOCK BEARS N28°W 48' FROM TRUE COR. - BRASS WASHER RLS #1005 SET IN B.T. FACE "¼ S35 B.T."
14" HEMLOCK BEARS N64°E 18.8' FROM TRUE COR.

(14) SET 2½" IRON PIPE WITH BRASS CAP (MARKED AS SHOWN) FROM WHICH BEARS:
SCRIBED NEW B.T.'S:
8" D. FIR N24°E 8.8' "E¼ S35 B.T."
12" FIR S82°E 14.4' "E¼ S35 B.T."
NO OTHER TREES AVAILABLE
BRASS WASHERS MARKED RLS # 1654 SET IN B.T. FACES
SET POST & SIGNS 4.0' NORTH

(15) FOUND 2" IRON PIPE WITH BRASS CAP (MARKED AS SHOWN) FROM WHICH BEARS:
30" D. FIR S8°W 75.2' (VIS. SCRIBES)
18" D. FIR S53°E 5.0' (GOOD SCAR)
14" D. FIR S73°W 12.3 (GOOD SCAR)
24" D. FIR S48°E 14.7' (VIS. FACE)
SET POST & SIGN 3.0' NORTH

(16) FOUND 1½" IRON PIPE WITH BRASS CAP (MARKED AS SHOWN) FROM WHICH BEARS:
40" D. FIR SNAG N60°E 36.3' (VIS. SCRIBES)
20" D. FIR N84°E 40.9' (VIS. SCAR)
30" D. FIR N1°W 44.2' (VIS. SCAR)
FOUND 3"x3" WOODEN POST AT CORNER.
SET POST & SIGN 1.5' EAST

LEGEND:

- o SET CORNER MONUMENT: 2½" x 30" IRON PIPE WITH 3" BRASS CAP
- ● FOUND CORNER MONUMENT
- [ ]1923 COURSE PER GLO PLAT, DATE AS NOTED
- —— LINE POSTED WITH FIBERGLASS POSTS AND GOVERNMENT PROPERTY SIGNS.

"I, RONALD A. QUIMBY, A REGISTERED PROFESSIONAL LAND SURVEYOR IN THE STATE OF OREGON, HEREBY CERTIFY THAT THIS PLAT AND THE NOTES HEREON, OR ATTACHED, ARE A CORRECT REPRESENTATION OF A SURVEY I PERFORMED DURING NOVEMBER 1979 TO MAY 1980, FOR THE U.S FOREST SERVICE, IN ACCORDANCE WITH THE STATUTES OF THE STATE OF OREGON AND WITH THE ARTICLES OF MY CONTRACT."

Ronald A. Quimby

RONALD A. QUIMBY
REGISTERED PROFESSIONAL LAND SURVEYOR
OREGON LICENSE NO. 1654

REGISTERED PROFESSIONAL LAND SURVEYOR
Romanso E. Ware
OREGON
NOV. 14, 1978
ROMANSO E. WARE
1005

REGISTERED PROFESSIONAL LAND SURVEYOR
Ronald A. Quimby
OREGON
JULY 11, 1977
RONALD A. QUIMBY
1654

NARRATIVE:

PREVIOUSLY SURVEYED BY G.L.O. PURPOSE OF SURVEY IS TO LOCATE GOVERNMENT PROPERTY LINES. FIELD SUPERVISOR: R. QUIMBY. PARTY CHIEF: M. RADCLIFFE. DRAFTSMAN: D. HOPKINS. OFFICE COMPUTATIONS: R. WARE AND R. QUIMBY. EQUIPMENT USED: WILD-T1 THEODOLITE AND RED-1 E.D.M. BASIS OF BEARING PER SOLAR OBSERVATION TAKEN JANUARY 29, 1980. REFERENCE NOTES PER G.L.O. RECORDS: 1882, 1909, 1911 AND 1923. REFERENCE DEEDS - # 240/191854

NOTE: ALL NEW BEARING TREES SCRIBED IN THIS SURVEY ARE MARKED WITH BRASS WASHERS STAMPED "RLS 1654" OR "RLS 1005" NAILED TO THE LOWER BLAZE OF EACH TREE.

BHW ENGINEERING & SURVEYING, INC.
1205 S.E. COURT ~ ROSEBURG, OREGON ~ 673-0165

COUNTY SURVEYORS FILE DATA
DO NOT REMOVE FROM OFFICE

CONTRACT NO. 53-04H1-9-7490N

GLIDE SURVEY NO. 10

MAP FILE M 77 46