MAP FILE M79-8

COUNTY SURVEYORS FILE DATA
DO NOT REMOVE FROM OFFICE

Survey in Lots 5, 6, 7 & 8, Block 6, "Plat I, Sutherlin Land & Water Co." Section 13, T25S, R5W, W.M.

Survey for Sutherlin Water Control District
By BHW Engineering & Surveying, Inc.

September 1979
Scale: 1" = 100'

FILED
RECEIVED
SEP 26 1979
COUNTY SURVEYOR
DOUGLAS COUNTY, ORE.

NOTE: BEARINGS WERE BASED ON RECORD PER PLAT ON THE WEST LINE OF LOT ONE, BLOCK FOUR. HOWEVER, IN CHECKING WITH THE UNRECORDED SURVEY (NO MONUMENTS SET) BY THE SOIL CONSERVATION SERVICE AND TYING IN WITH COMMON POINTS, IT WAS FOUND A 2°30'55" LEFT ROTATION TO BEARINGS HAD TO BE APPLIED TO THEIR SURVEY. THIS ROTATION CAN ALSO BE NOTED IN THE DEED.

REGISTERED PROFESSIONAL LAND SURVEYOR
OREGON NOV. 16, 1973 ROMANSO E. WARE 1005

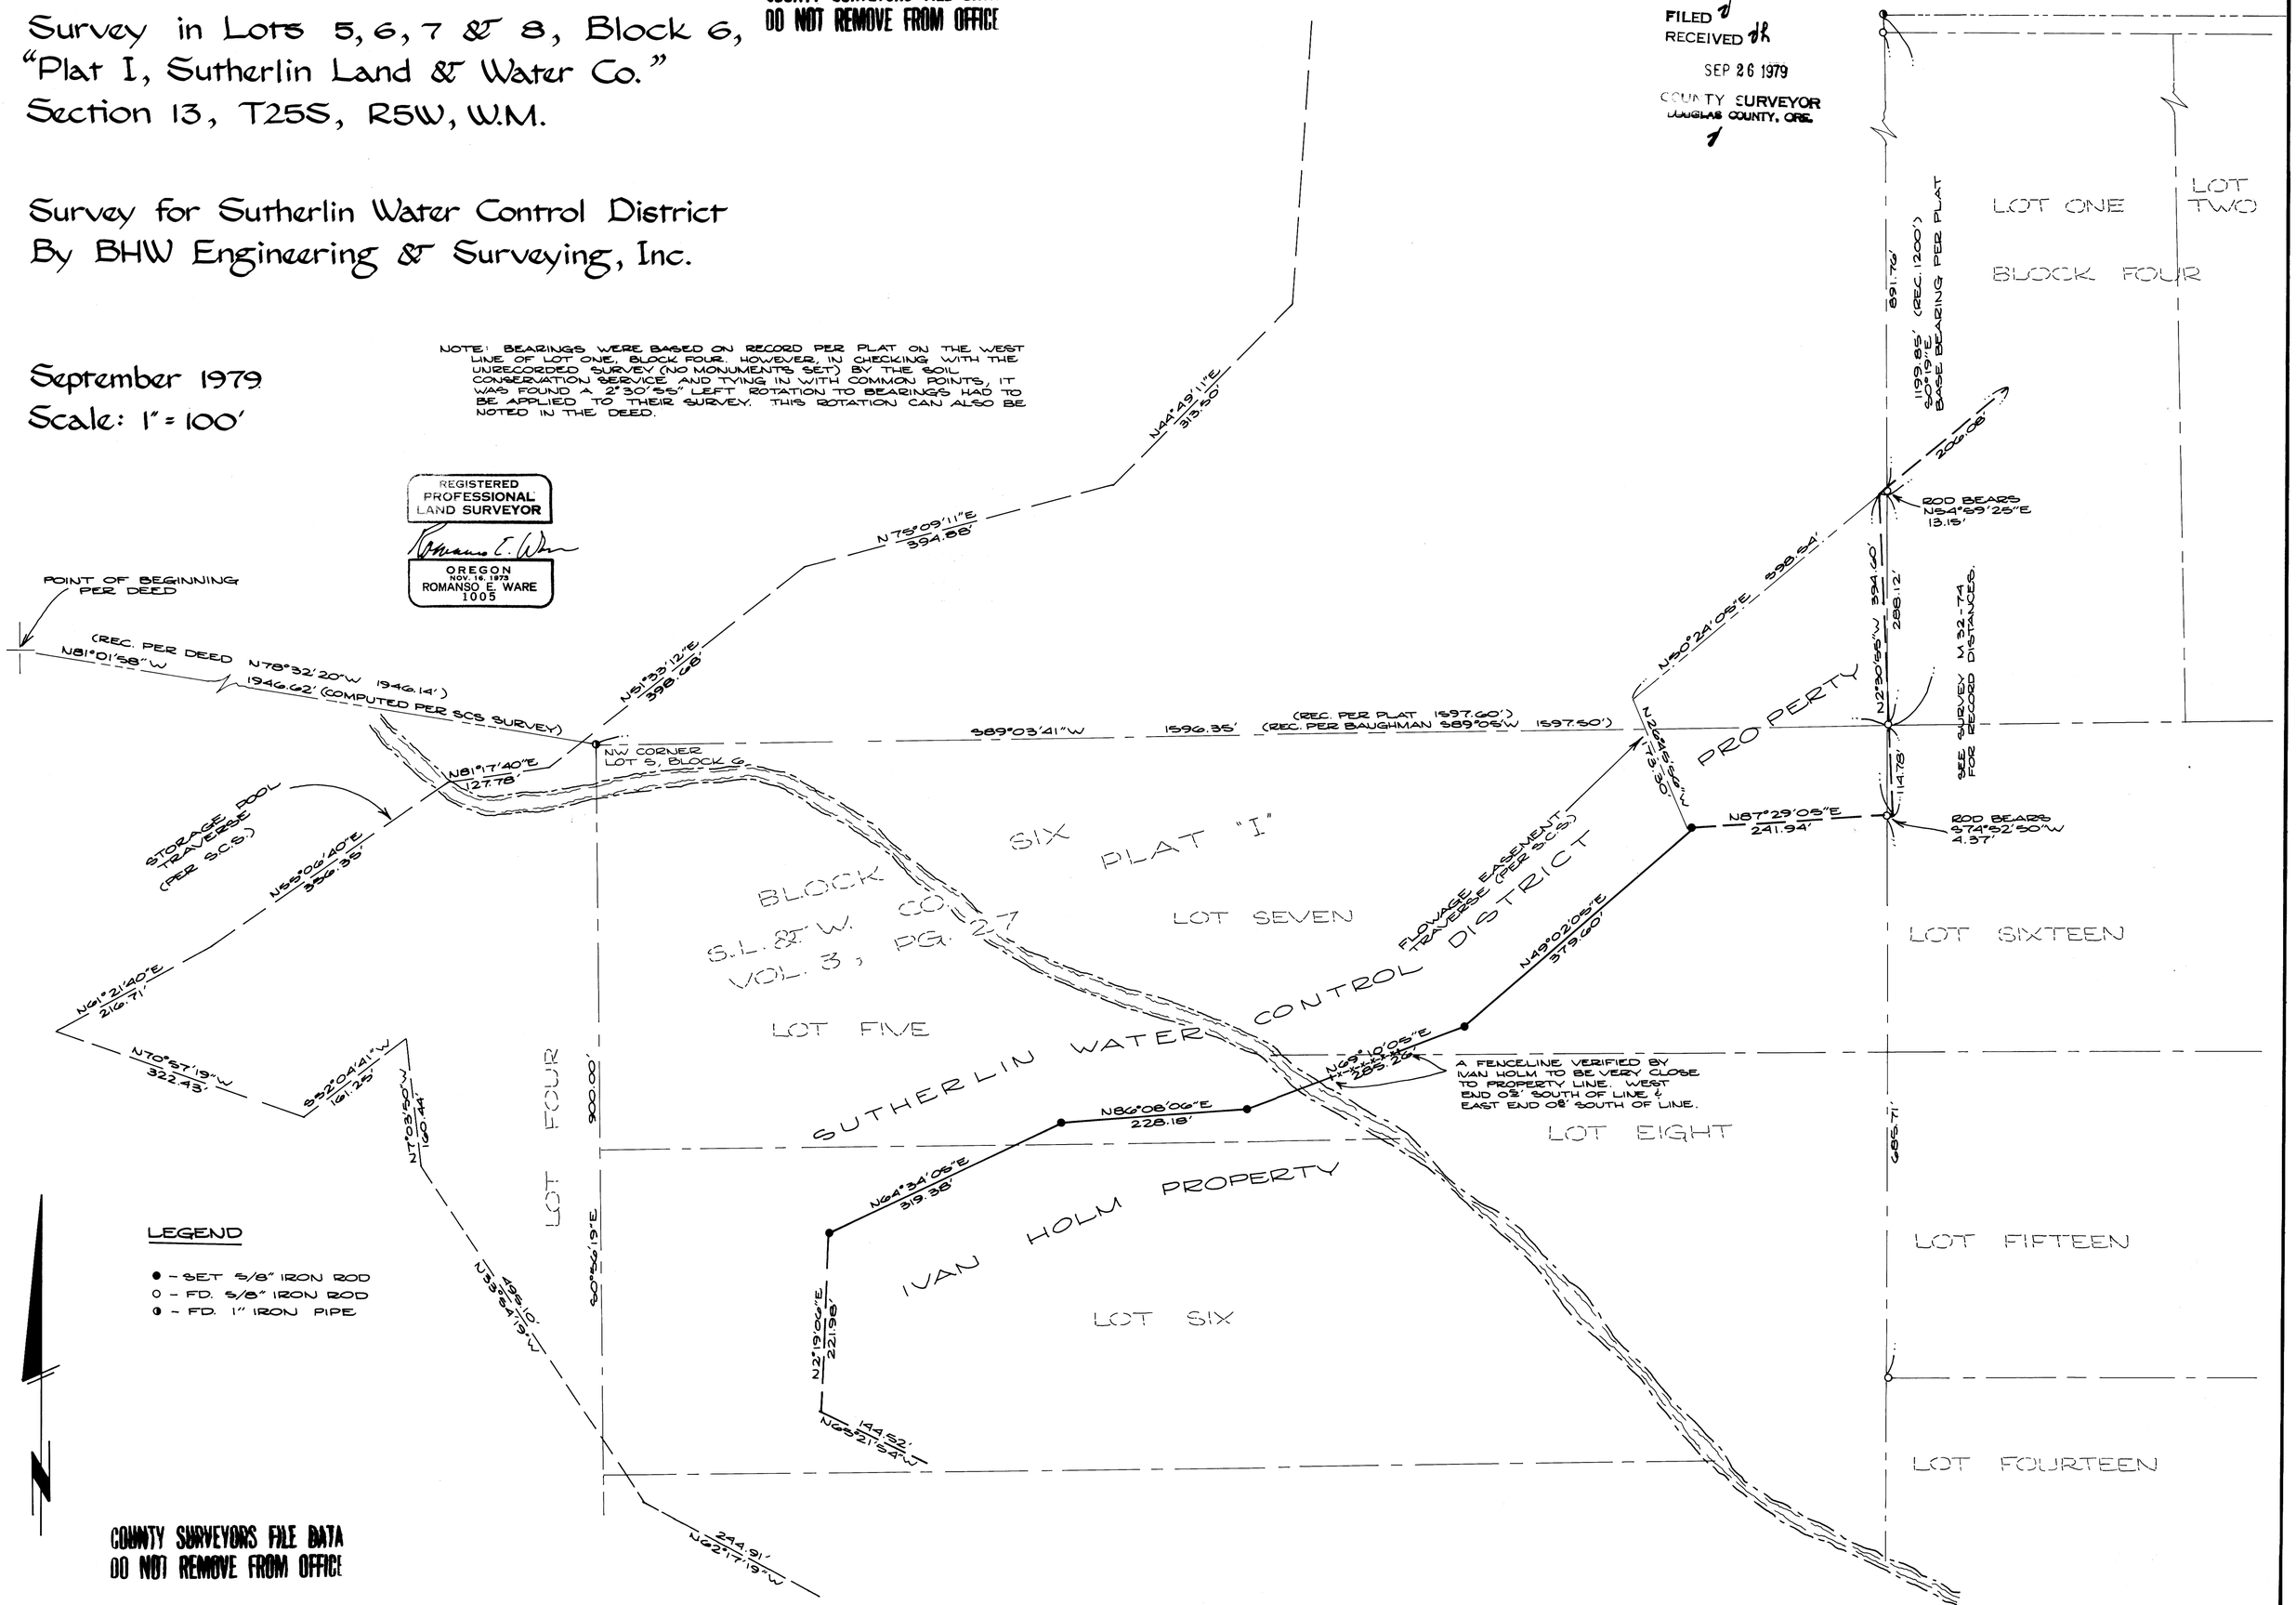

COUNTY SURVEYORS FILE DATA
DO NOT REMOVE FROM OFFICE

MAP FILE M79-8